
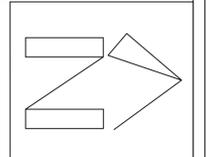


AS BUILT DRAWING OF MAIN SEWER "A" FROM PADEGAON SPS TO MAKBARA (R.A.BILL-1 TO R.A. BILL-6)

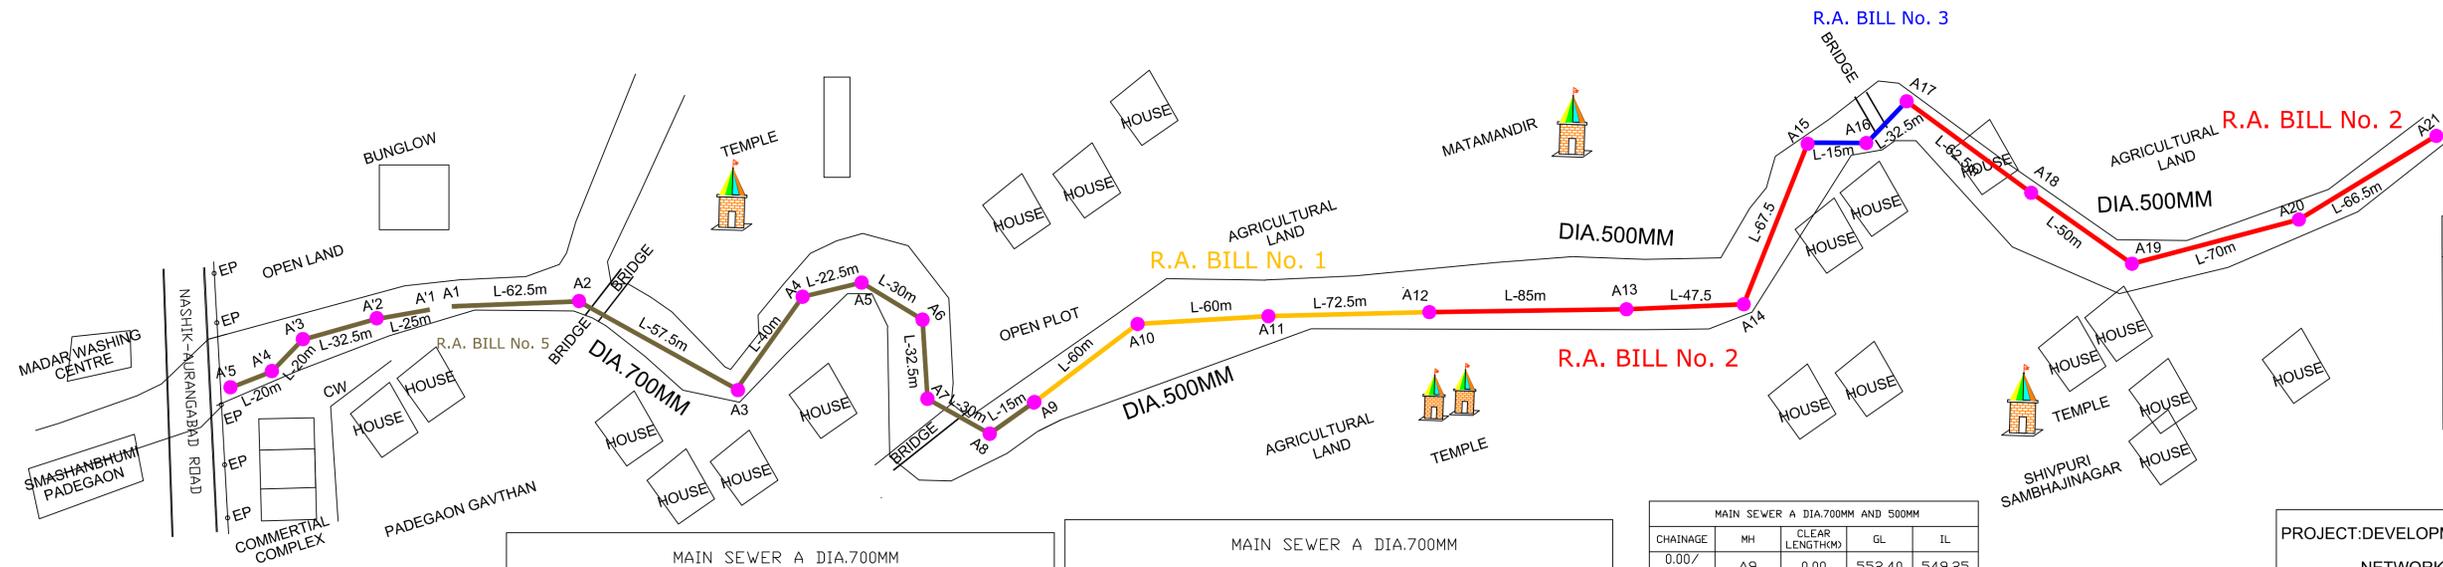

LEGENDS	
	RA BILL 1
	RA BILL 2
	RA BILL 3
	RA BILL 4
	RA BILL 5

MAIN SEWER A DIA.700MM				
CHAINAGE	MH	CLEAR LENGTH(M)	GL	IL
00.00	A'1	00.00	551.100	548.275
26.9000	A'2	25.00	550.820	548.445
61.3000	A'3	32.5000	550.900	548.480
83.20	A'4	20.0000	550.760	548.575
105.10	A'5	20.0000	550.840	548.730

MAIN SEWER A DIA.700MM				
CHAINAGE	MH	CLEAR LENGTH(M)	GL	IL
0.00	A1	0.00	551.100	548.245
64.40	A2	62.50	551.870	548.305
120.00	A3	57.50	551.575	548.635
161.90	A4	40.00	552.750	548.755
186.30	A5	22.50	552.990	548.835
2187.20	A6	30.00	553.225	548.910
252.60	A7	32.50	553.035	548.935
284.50	A8	30.00	553.895	549.015
301.40	A9	15.00	553.480	549.135

MAIN SEWER A DIA.700MM AND 500MM				
CHAINAGE	MH	CLEAR LENGTH(M)	GL	IL
0.00/553.00	A9	0.00	552.40	549.25
61.50/614.50	A10	60.00	552.25	549.82
123.00/676.00	A11	60.00	553.28	550.71
197.00/750.00	A12	72.50	553.32	551.06
283.50/836.50	A13	85.00	555.05	551.145
332.50/885.50	A14	47.50	554.615	551.415
401.50/1003.50	A15	67.50	554.395	551.880
417.25/1020.00	A16	15.00	555.875	551.901
450.00/1054.00	A17	32.50	555.215	551.900
514.00/1117.50	A18	62.00	555.230	552.145
565.5/1196.00	A19	50.00	555.450	552.595
637.00/1267.50	A20	70.00	556.110	553.030
707.00/1335.50	A21	66.50	556.480	553.485

PROJECT: DEVELOPMENT OF SEWERAGE COLLECTION NETWORK UNDER UIDSSMT FOR AURANGABAD CITY

TITLE : AS BUILT DRAWING OF MAIN SEWER "A"



AURANGABAD MUNICIPAL CORPORATION, TOWN HALL, AURANGABAD

AGENCY: KHILARI INFRASTRUCTURE PVT. LTD. 101, PRABHAT CENTER, SECT-1A, CBD, BELAPUR, NAVI MUMBAI-400 614

CONSULTANT: FORTRESS INFRASTRUCTURE ADVISORY SERVICES, MARINE LINES, MUMBAI-2

SCALE 1:1000

AS BUILT DRAWING OF MAIN SEWER "A" FROM PADEGAON SPS TO MAKBARA (R.A.BILL-1 TO R.A. BILL-6)

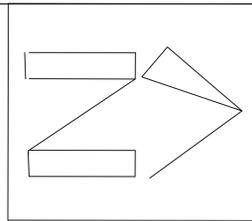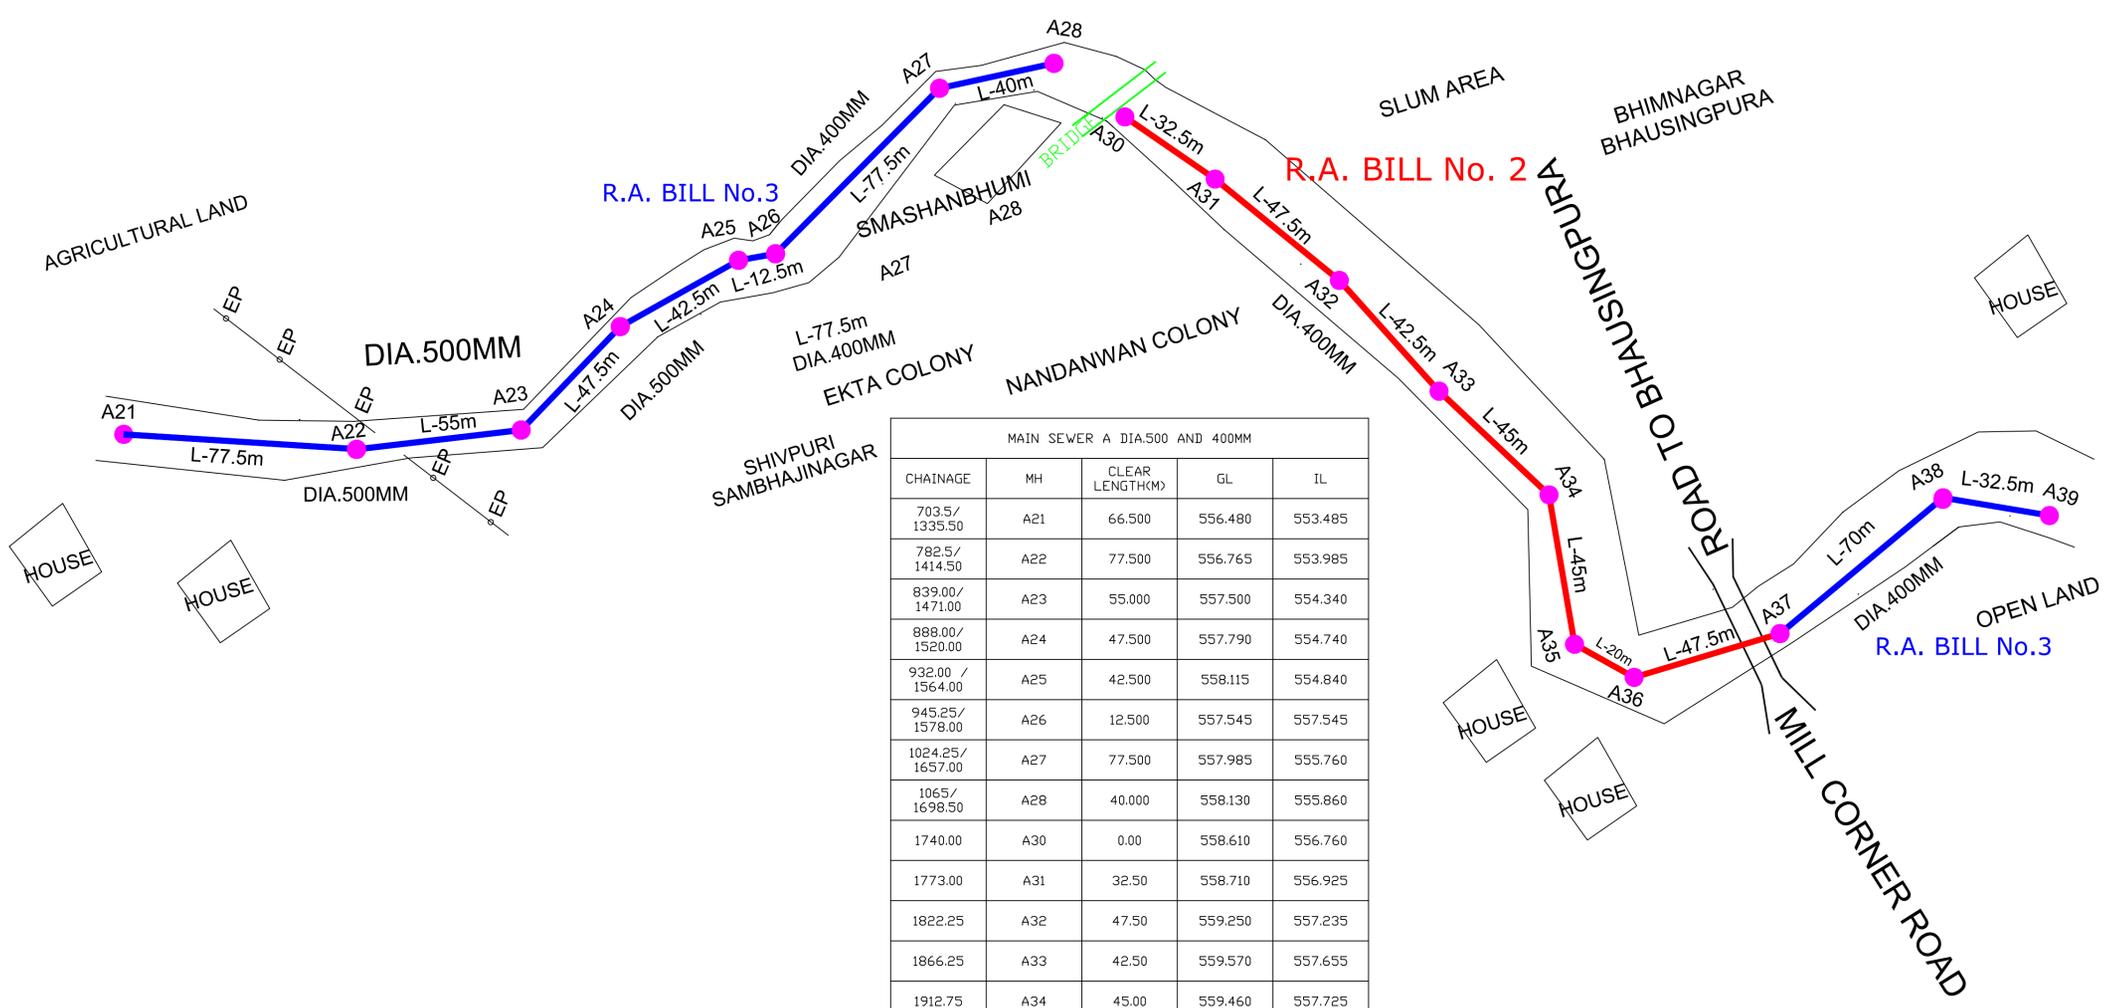

LEGENDS	
—	RA BILL 2
—	RA BILL 3

MAIN SEWER A DIA.500 AND 400MM				
CHAINAGE	MH	CLEAR LENGTH(M)	GL	IL
703.5/1335.50	A21	66.500	556.480	553.485
782.5/1414.50	A22	77.500	556.765	553.985
839.00/1471.00	A23	55.000	557.500	554.340
888.00/1520.00	A24	47.500	557.790	554.740
932.00/1564.00	A25	42.500	558.115	554.840
945.25/1578.00	A26	12.500	557.545	557.545
1024.25/1637.00	A27	77.500	557.985	555.760
1065/1698.50	A28	40.000	558.130	555.860
1740.00	A30	0.00	558.610	556.760
1773.00	A31	32.50	558.710	556.925
1822.25	A32	47.50	559.250	557.235
1866.25	A33	42.50	559.570	557.655
1912.75	A34	45.00	559.460	557.725
1959.25	A35	45.00	559.485	557.725
1980.75	A36	20.00	560.250	557.730
2029.75	A37	47.50	559.980	557.825
2101.25	A38	70.00	560.490	558.195
2135.25	A39	32.50	561.295	558.220

PROJECT: DEVELOPMENT OF SEWERAGE COLLECTION NETWORK UNDER UIDSSMT FOR AURANGABAD CITY

TITLE : AS BUILT DRAWING OF MAIN SEWER "A"


 AURANGABAD MUNICIPAL CORPORATION,
TOWN HALL, AURANGABAD

AGENCY: KHILARI INFRASTRUCTURE PVT. LTD.
101, PRABHAT CENTER, SECT-1A, CBD, BELAPUR,
NAVI MUMBAI-400 614

CONSULTANT: FORTRESS INFRASTRUCTURE ADVISORY SERVICES, MARINE LINES, MUMBAI-2

SCALE 1:1000

AS BUILT DRAWING OF MAIN SEWER "A" FROM PADEGAON SPS TO MAKBARA (R.A.BILL-1 TO R.A. BILL-6)

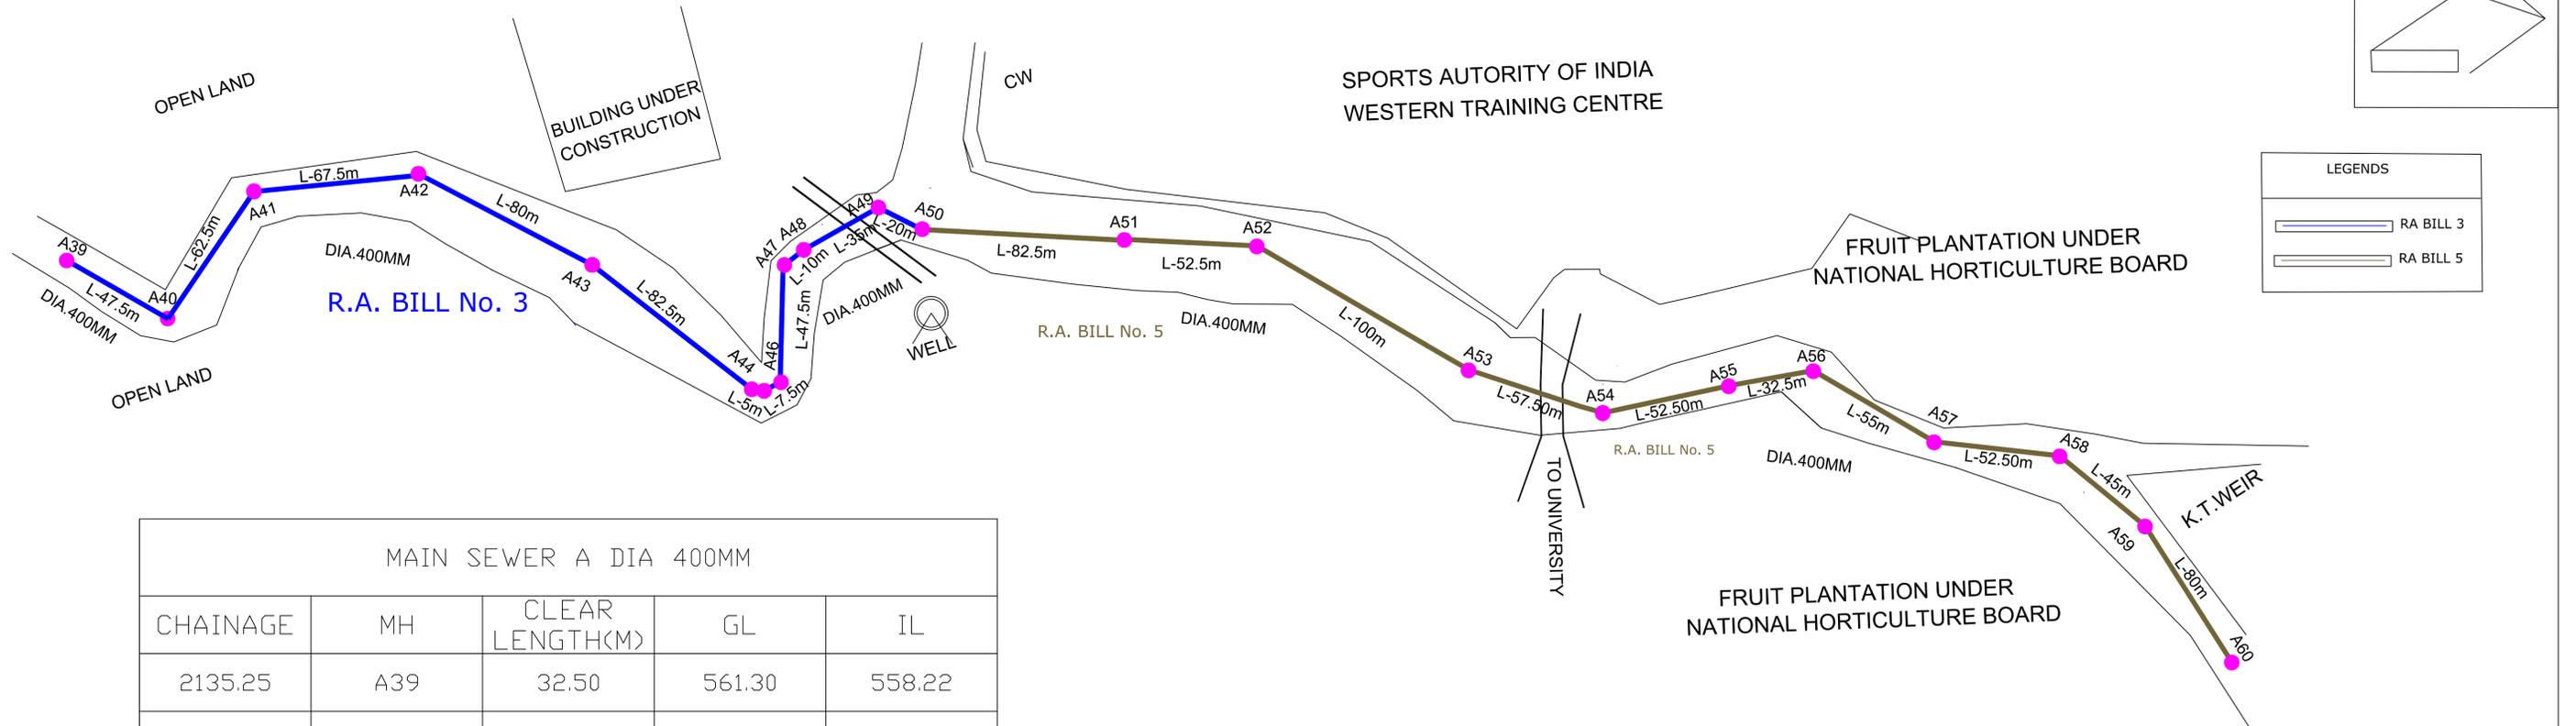

LEGENDS	
	RA BILL 3
	RA BILL 5



MAIN SEWER A DIA 400MM				
CHAINAGE	MH	CLEAR LENGTH(M)	GL	IL
2135.25	A39	32.50	561.30	558.22
2184.25	A40	47.50	561.28	558.55
2248.25	A41	62.50	561.50	588.82
2317.25	A42	67.50	561.87	559.27
2398.75	A43	80.00	562.58	569.77
2482.75	A44	82.50	563.26	560.19
2488.50	A45	5.00	563.28	560.19
2496.75	A46	7.50	563.20	560.33
2545.75	A47	47.50	563.24	560.53
2556.50	A48	10.00	563.24	560.58
2593.00	A49	35.00	564.72	560.76
2613.75	A50	20.00	564.40	560.99

MAIN SEWER A DIA-400MM				
CHAINAGE	MH	CLEAR LENGTH(M)	GL	IL
2613.75	A50	20.00	564.400	560.985
2697.75	A51	82.50	564.610	561.505
2751.75	A52	52.50	564.840	562.135
2853.25	A53	100.00	565.755	562.840
2912.25	A54	57.50	567.020	564.500
2966.25	A55	52.50	567.265	565.115
3000.25	A56	32.50	566.860	565.125
3056.75	A57	55.00	567.430	565.245
3110.75	A58	52.50	567.980	565.655
3157.25	A59	45.00	567.620	565.725
3238.75	A60	80.00	569.330	556.155

SCALE 1:1000

PROJECT:DEVELOPMENT OF SEWERAGE COLLECTION NETWORK UNDER UIDSSMT FOR AURANGABAD CITY	
TITLE : AS BUILT DRAWING OF MAIN SEWER "A"	
 AURANGABAD MUNICIPAL CORPORATION, TOWN HALL, AURANGABAD	
AGENCY:KHILARI INFRASTRUCTURE PVT. LTD. 101, PRABHAT CENTER, SECT-1A, CBD, BELAPUR, NAVI MUMBAI-400 614	
CONSULTANT: FORTRESS INFRASTRUCTURE ADVISORY SERVICES, MARINE LINES, MUMBAI-2	

AS BUILT DRAWING OF MAIN SEWER "A" FROM PADEGAON SPS TO MAKBARA (R.A.BILL-1 TO R.A. BILL-6)

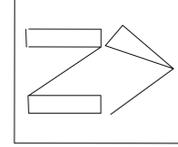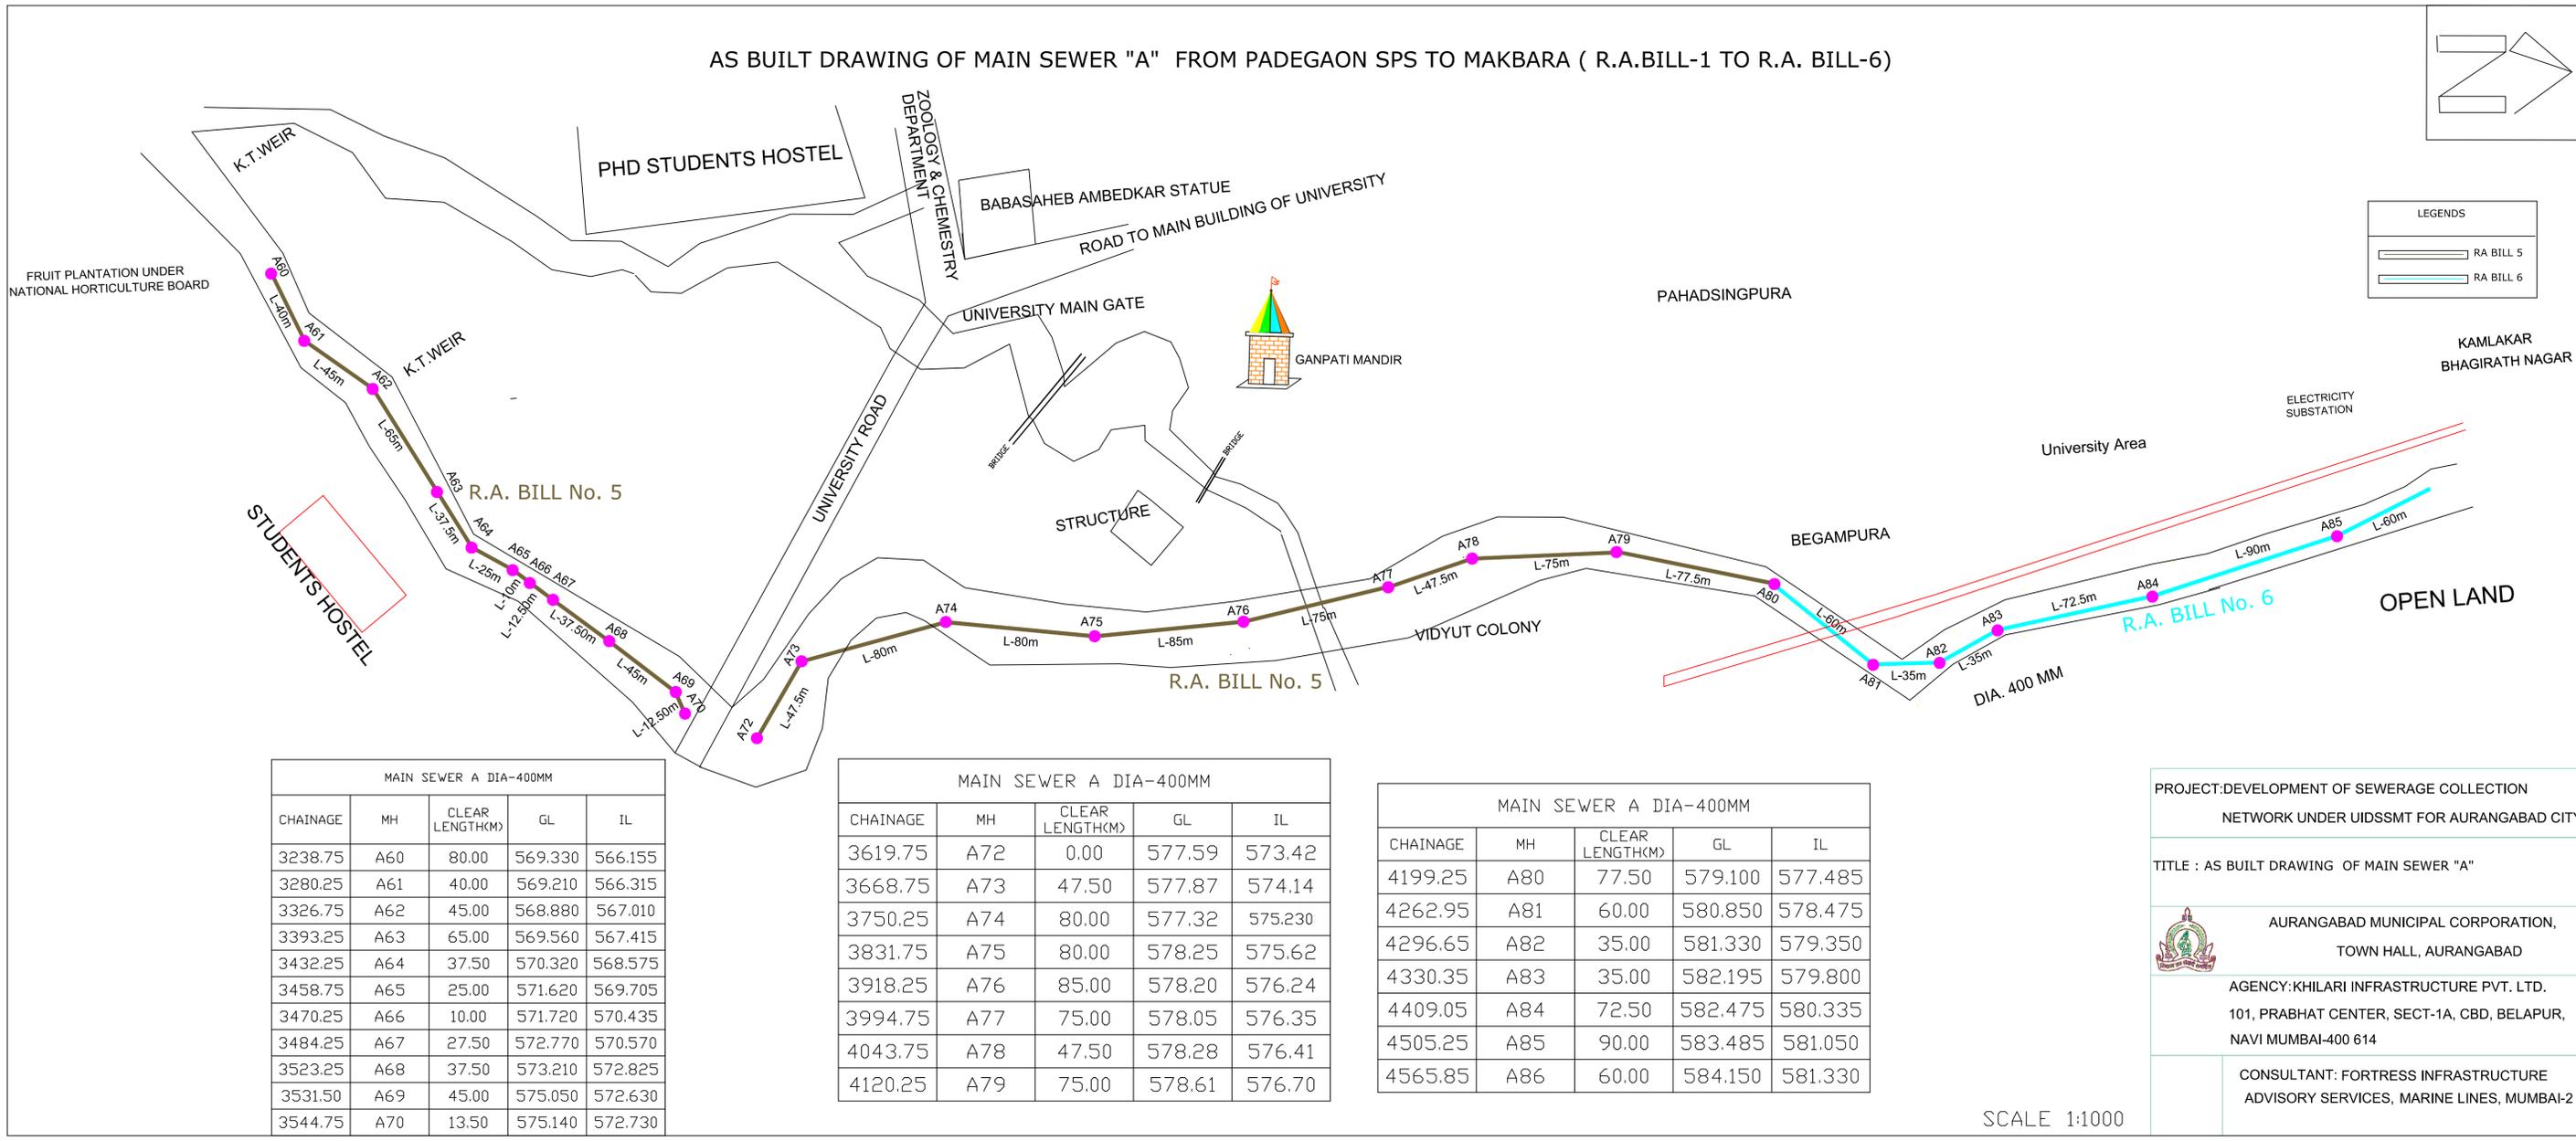

LEGENDS

	RA BILL 5
	RA BILL 6

MAIN SEWER A DIA-400MM				
CHAINAGE	MH	CLEAR LENGTH(M)	GL	IL
3238.75	A60	80.00	569.330	566.155
3280.25	A61	40.00	569.210	566.315
3326.75	A62	45.00	568.880	567.010
3393.25	A63	65.00	569.560	567.415
3432.25	A64	37.50	570.320	568.575
3458.75	A65	25.00	571.620	569.705
3470.25	A66	10.00	571.720	570.435
3484.25	A67	27.50	572.770	570.570
3523.25	A68	37.50	573.210	572.825
3531.50	A69	45.00	575.050	572.630
3544.75	A70	13.50	575.140	572.730

MAIN SEWER A DIA-400MM				
CHAINAGE	MH	CLEAR LENGTH(M)	GL	IL
3619.75	A72	0.00	577.59	573.42
3668.75	A73	47.50	577.87	574.14
3750.25	A74	80.00	577.32	575.230
3831.75	A75	80.00	578.25	575.62
3918.25	A76	85.00	578.20	576.24
3994.75	A77	75.00	578.05	576.35
4043.75	A78	47.50	578.28	576.41
4120.25	A79	75.00	578.61	576.70

MAIN SEWER A DIA-400MM				
CHAINAGE	MH	CLEAR LENGTH(M)	GL	IL
4199.25	A80	77.50	579.100	577.485
4262.95	A81	60.00	580.850	578.475
4296.65	A82	35.00	581.330	579.350
4330.35	A83	35.00	582.195	579.800
4409.05	A84	72.50	582.475	580.335
4505.25	A85	90.00	583.485	581.050
4565.85	A86	60.00	584.150	581.330

PROJECT: DEVELOPMENT OF SEWERAGE COLLECTION NETWORK UNDER UIDSSMT FOR AURANGABAD CITY

TITLE : AS BUILT DRAWING OF MAIN SEWER "A"


AURANGABAD MUNICIPAL CORPORATION, TOWN HALL, AURANGABAD

AGENCY: KHILARI INFRASTRUCTURE PVT. LTD.
101, PRABHAT CENTER, SECT-1A, CBD, BELAPUR, NAVI MUMBAI-400 614

CONSULTANT: FORTRESS INFRASTRUCTURE ADVISORY SERVICES, MARINE LINES, MUMBAI-2

SCALE 1:1000

AS BUILT DRAWING OF BRANCH SEWER " B " AT RAHUL NAGAR RA BILL-6

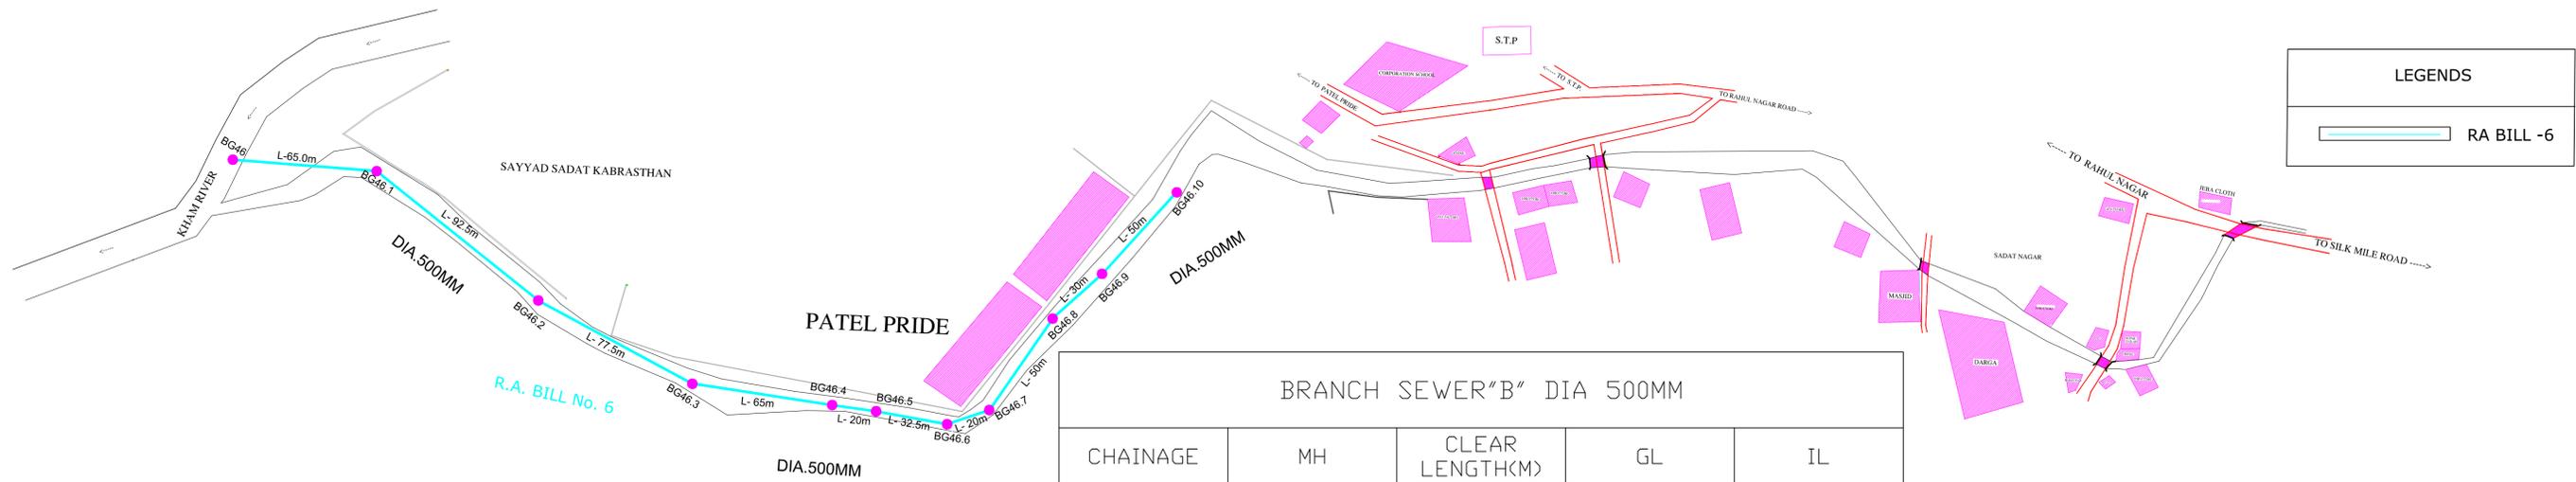

LEGENDS	
	RA BILL -6

BRANCH SEWER "B" DIA 500MM				
CHAINAGE	MH	CLEAR LENGTH(M)	GL	IL
0.00	BG46	0.00	540.595	538.030
66.20	BG46.1	65.00	541.090	538.305
159.90	BG46.2	92.50	542.125	538.845
238.60	BG46.3	77.50	542.715	539.325
304.80	BG46.4	65.00	542.920	539.855
326.00	BG46.5	20.00	544.030	540.185
359.70	BG46.6	32.50	545.730	540.485
380.90	BG46.7	20.00	545.980	540.905
432.10	BG46.8	50.00	545.100	541.345
463.30	BG46.9	30.00	544.830	541.465
513.90	BG46.10	50.00	545.170	541.610

PROJECT: DEVELOPMENT OF SEWERAGE COLLECTION NETWORK UNDER UIDSSMT FOR AURANGABAD CITY

TITLE: AS BUILT OF BRANCH SEWER "B"

 AURANGABAD MUNICIPAL CORPORATION,
TOWN HALL, AURANGABAD

 AGENCY KHILARI INFRASTRUCTURE PVT. LTD.
101, PRABHAT CENTER, SECT-1A, CBD, BELAPUR,
NAVI MUMBAI-400 614


CONSULTANT: FORTRESS INFRASTRUCTURE ADVISORY SERVICES, MARINE LINES, MUMBAI-2

SCALE 1:1000


AS BUILT DRAWING OF MAIN SEWER " B" HARSUL TO GOLWADI SPS (R.A.BILL-1 TO R.A.6)

LEGENDS

- RA BILL 1
- RA BILL 2
- RA BILL 3

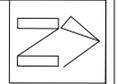

PRIMARY SCHOOL
PROPOSED 10 MLD STP PLANT BANEWADI

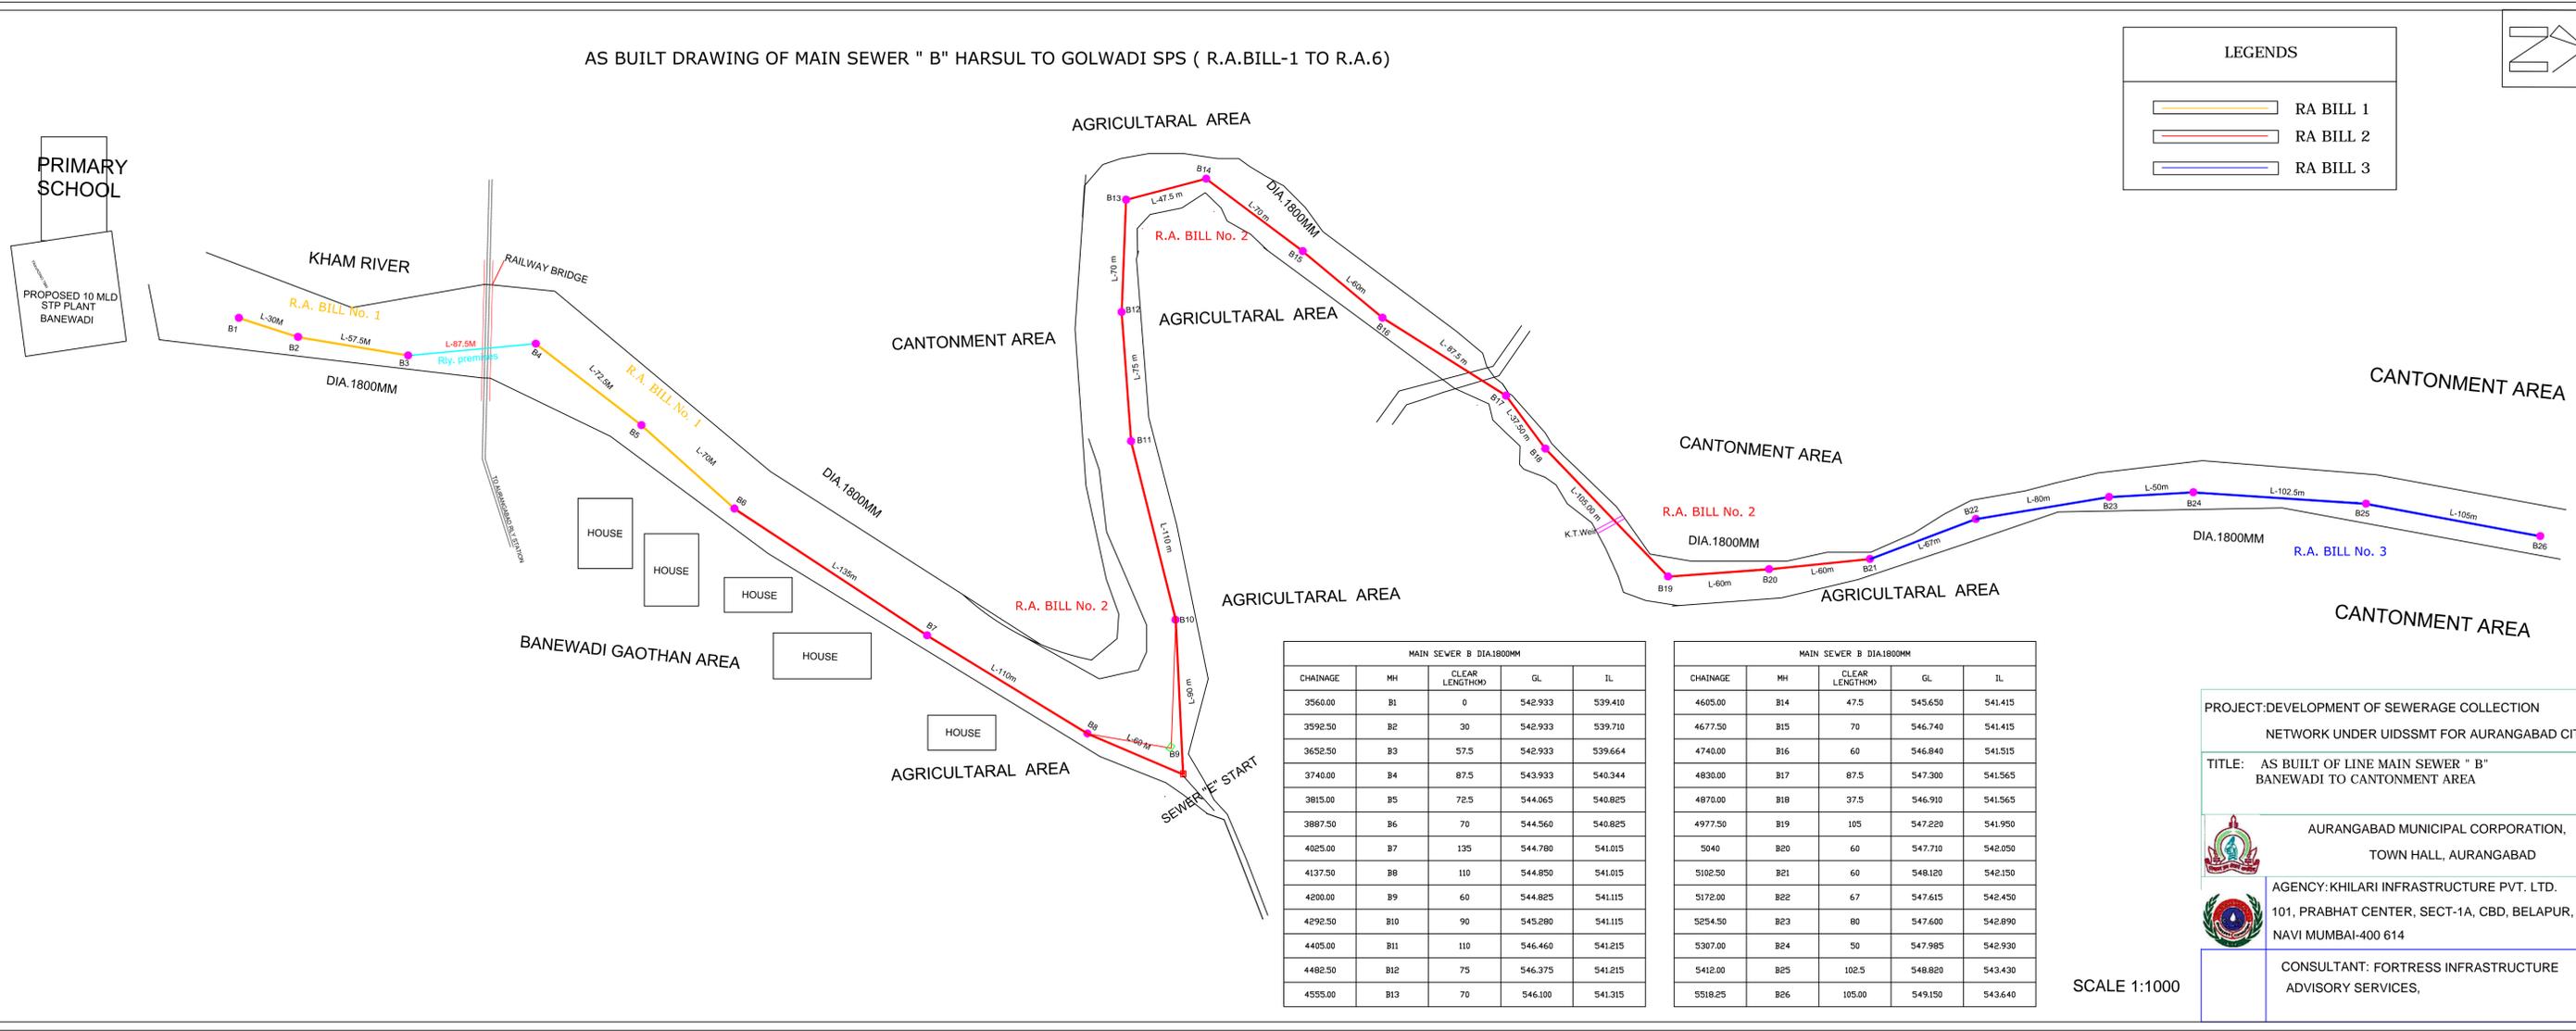

MAIN SEWER B DIA1800MM				
CHAINAGE	MH	CLEAR LENGTH(M)	GL	IL
3560.00	B1	0	542.933	539.410
3592.50	B2	30	542.933	539.710
3652.50	B3	57.5	542.933	539.664
3740.00	B4	87.5	543.933	540.344
3815.00	B5	72.5	544.065	540.825
3887.50	B6	70	544.560	540.825
4025.00	B7	135	544.780	541.015
4137.50	B8	110	544.850	541.015
4200.00	B9	60	544.825	541.115
4292.50	B10	90	545.280	541.115
4405.00	B11	110	546.460	541.215
4482.50	B12	75	546.375	541.215
4555.00	B13	70	546.100	541.315

MAIN SEWER B DIA1800MM				
CHAINAGE	MH	CLEAR LENGTH(M)	GL	IL
4605.00	B14	47.5	545.650	541.415
4677.50	B15	70	546.740	541.415
4740.00	B16	60	546.840	541.515
4830.00	B17	87.5	547.300	541.565
4870.00	B18	37.5	546.910	541.565
4977.50	B19	105	547.220	541.950
5040	B20	60	547.710	542.050
5102.50	B21	60	548.120	542.150
5172.00	B22	67	547.615	542.450
5254.50	B23	80	547.600	542.890
5307.00	B24	50	547.985	542.930
5412.00	B25	102.5	548.820	543.430
5518.25	B26	105.00	549.150	543.640

PROJECT: DEVELOPMENT OF SEWERAGE COLLECTION NETWORK UNDER UIDSSMT FOR AURANGABAD CITY

TITLE: AS BUILT OF LINE MAIN SEWER " B" BANEWADI TO CANTONMENT AREA


AURANGABAD MUNICIPAL CORPORATION,
TOWN HALL, AURANGABAD

AGENCY: KHILARI INFRASTRUCTURE PVT. LTD.
101, PRABHAT CENTER, SECT-1A, CBD, BELAPUR,
NAVI MUMBAI-400 614


CONSULTANT: FORTRESS INFRASTRUCTURE ADVISORY SERVICES,

SCALE 1:1000

AS BUILT OF MAIN SEWER " B" BANEWADI TO CANTONMENT AREA RA BILL-4 AND RA BILL-5

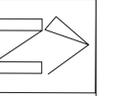

LEGENDS	
	RA BILL -4
	RA BILL -5

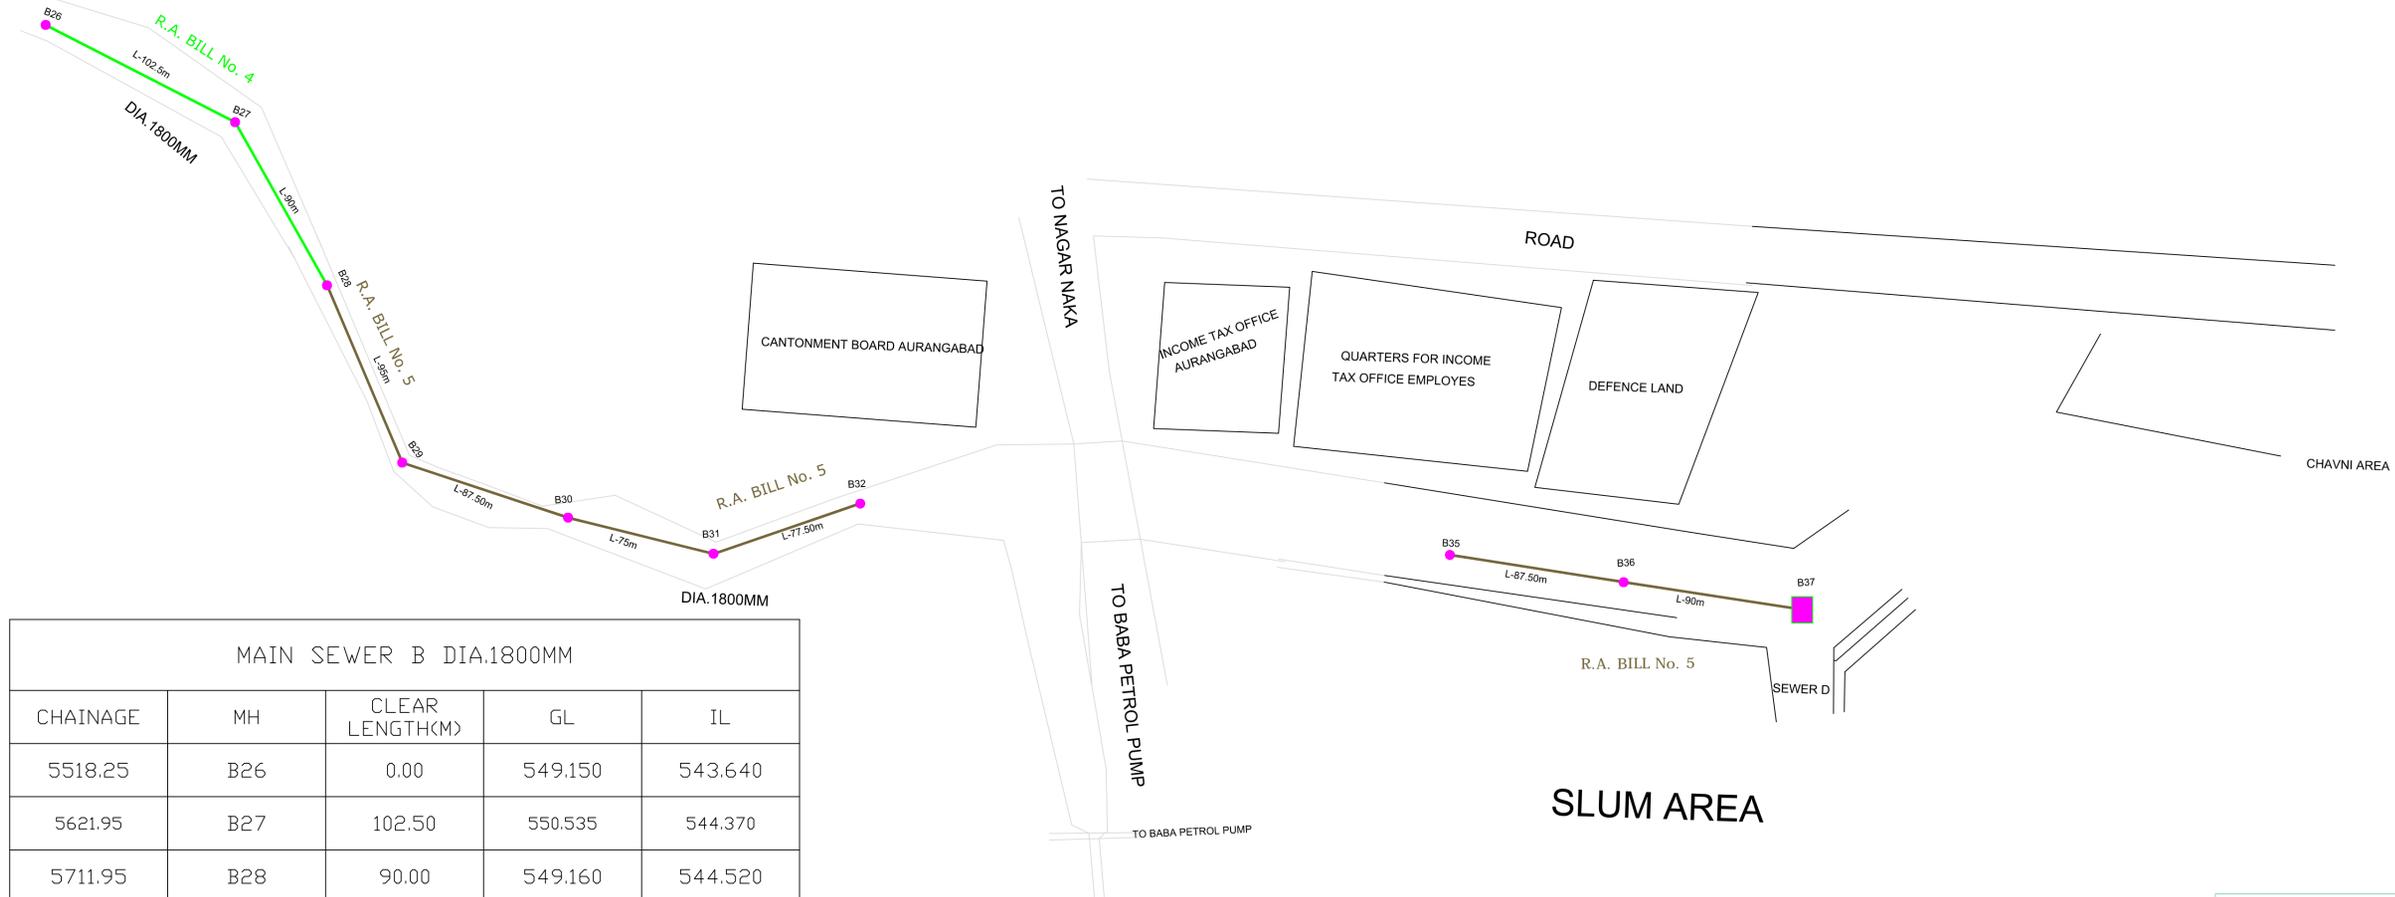

MAIN SEWER B DIA.1800MM				
CHAINAGE	MH	CLEAR LENGTH(M)	GL	IL
5518.25	B26	0.00	549.150	543.640
5621.95	B27	102.50	550.535	544.370
5711.95	B28	90.00	549.160	544.520
5809.05	B29	95.00	549.190	544.760
5898.65	B30	87.50	550.800	545.440
5975.75	B31	75.00	551.125	545.580
6055.35	B32	77.50	551.490	545.655
6305.35	B35	00.00	551.450	547.760
6394.95	B36	87.50	552.220	548.290
6487.05	B37	90.00	554.490	548.390

PROJECT:DEVELOPMENT OF SEWERAGE COLLECTION NETWORK UNDER UIDSSMT FOR AURANGABAD CITY

TITLE: AS BUILT OF MAIN SEWER " B"


 AURANGABAD MUNICIPAL CORPORATION,
TOWN HALL, AURANGABAD

 AGENCY:KHILARI INFRASTRUCTURE PVT. LTD.
101, PRABHAT CENTER, SECT-1A, CBD, BELAPUR,
NAVI MUMBAI-400 614

CONSULTANT: FORTRESS INFRASTRUCTURE ADVISORY SERVICES,

SCALE 1:1000

AS BUILT DRAWING OF MAIN SEWER " B" BANEWADI TO CANTONMENT AREA RA BILL-6

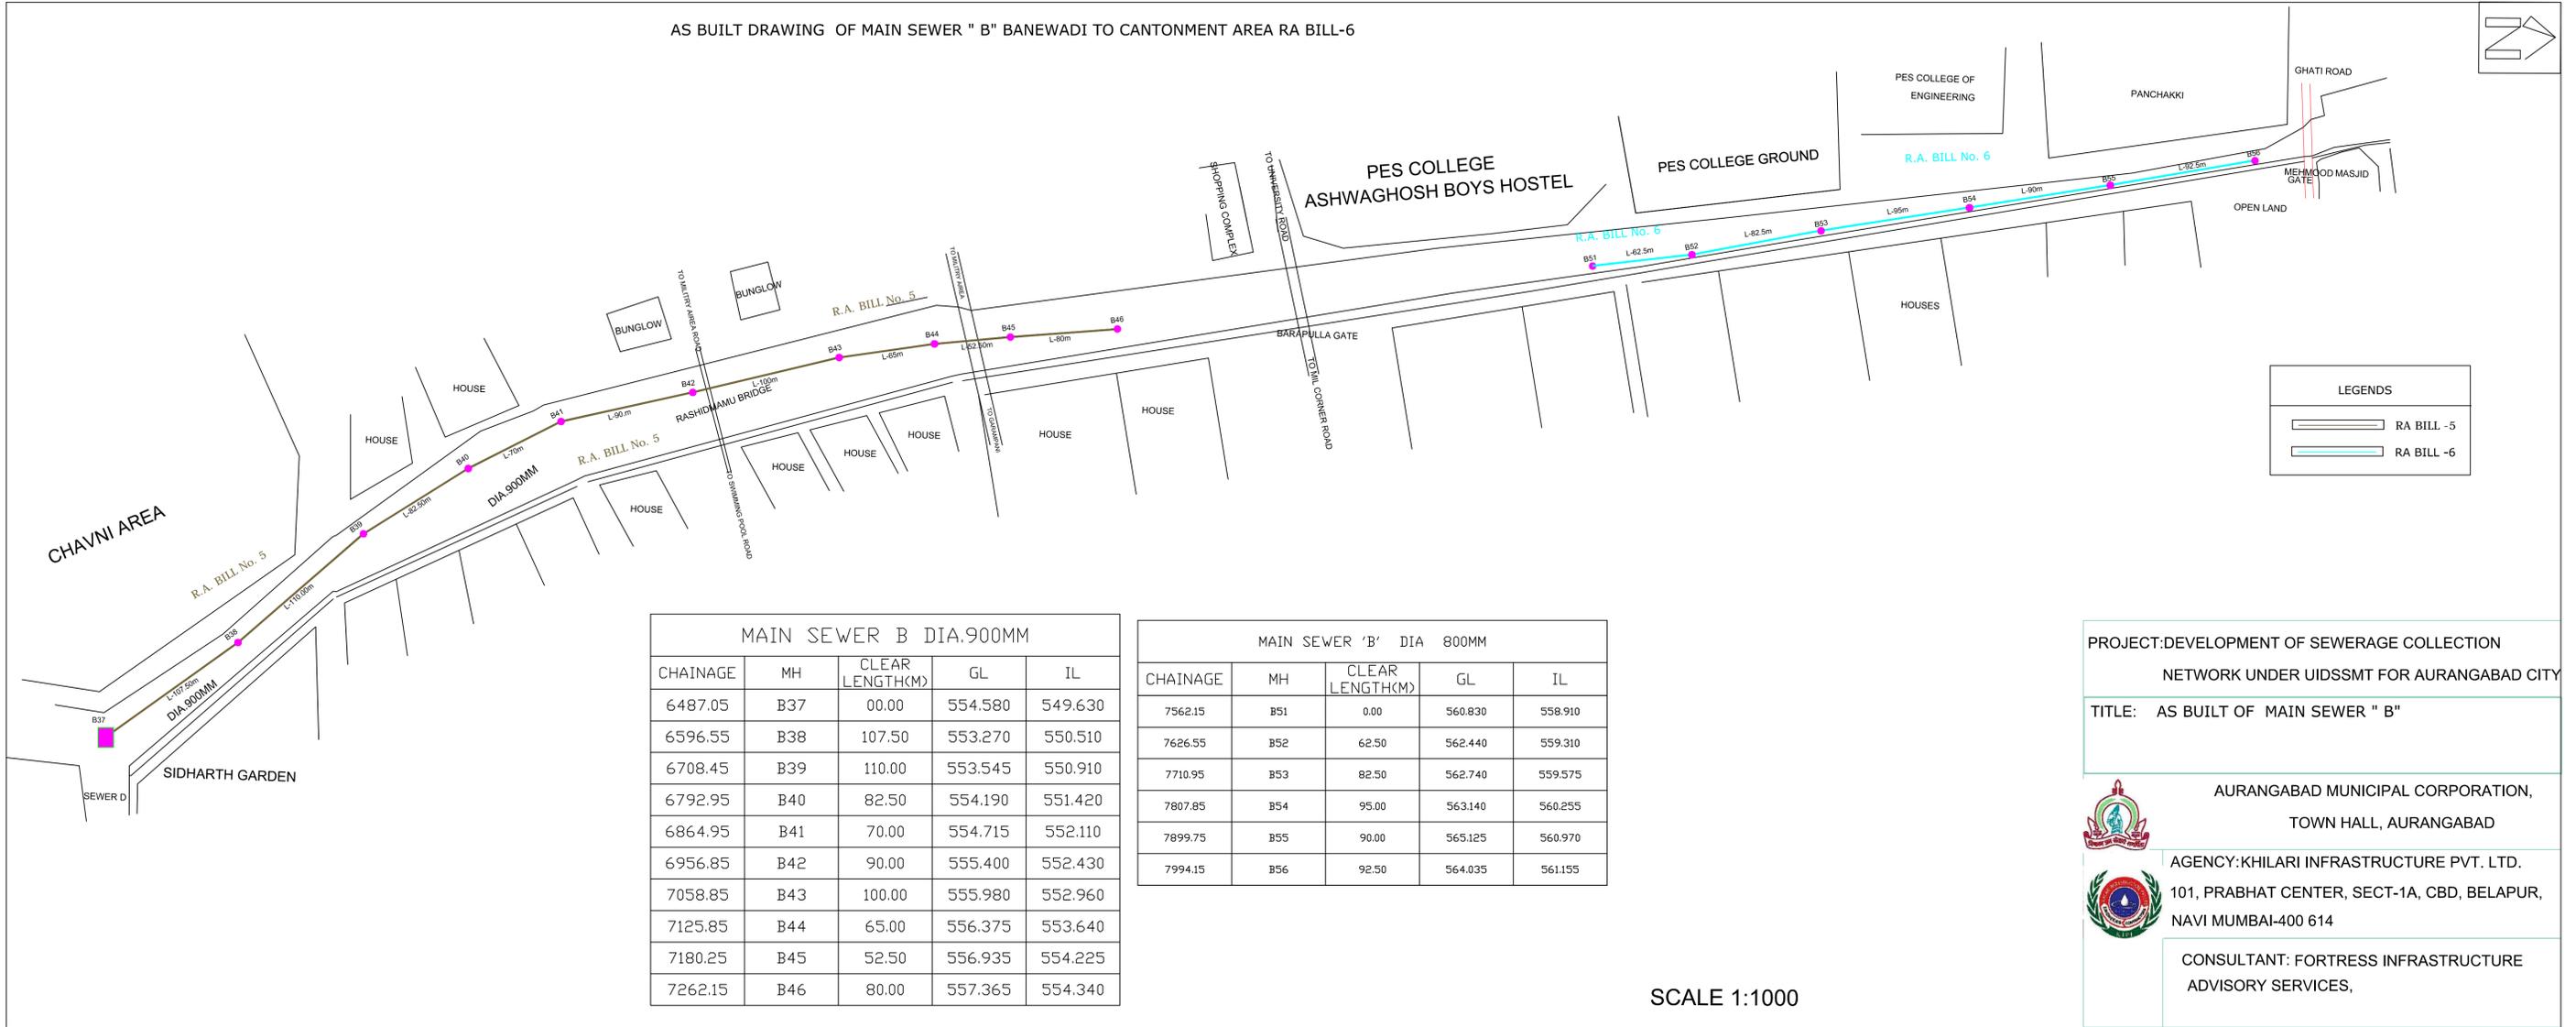

MAIN SEWER B DIA.900MM				
CHAINAGE	MH	CLEAR LENGTH(M)	GL	IL
6487.05	B37	00.00	554.580	549.630
6596.55	B38	107.50	553.270	550.510
6708.45	B39	110.00	553.545	550.910
6792.95	B40	82.50	554.190	551.420
6864.95	B41	70.00	554.715	552.110
6956.85	B42	90.00	555.400	552.430
7058.85	B43	100.00	555.980	552.960
7125.85	B44	65.00	556.375	553.640
7180.25	B45	52.50	556.935	554.225
7262.15	B46	80.00	557.365	554.340

MAIN SEWER 'B' DIA 800MM				
CHAINAGE	MH	CLEAR LENGTH(M)	GL	IL
7562.15	B51	0.00	560.830	558.910
7626.55	B52	62.50	562.440	559.310
7710.95	B53	82.50	562.740	559.575
7807.85	B54	95.00	563.140	560.255
7899.75	B55	90.00	565.125	560.970
7994.15	B56	92.50	564.035	561.155

SCALE 1:1000

PROJECT:DEVELOPMENT OF SEWERAGE COLLECTION NETWORK UNDER UIDSSMT FOR AURANGABAD CITY

TITLE: AS BUILT OF MAIN SEWER " B"

AURANGABAD MUNICIPAL CORPORATION,
TOWN HALL, AURANGABAD


AGENCY:KHILARI INFRASTRUCTURE PVT. LTD.
101, PRABHAT CENTER, SECT-1A, CBD, BELAPUR,
NAVI MUMBAI-400 614

CONSULTANT: FORTRESS INFRASTRUCTURE ADVISORY SERVICES,

AS BUILT OF MAIN SEWER " B" FROM HIMAYATBAGH TO HARSUL RA BILL-5



LEGENDS	
	RA BILL- 5

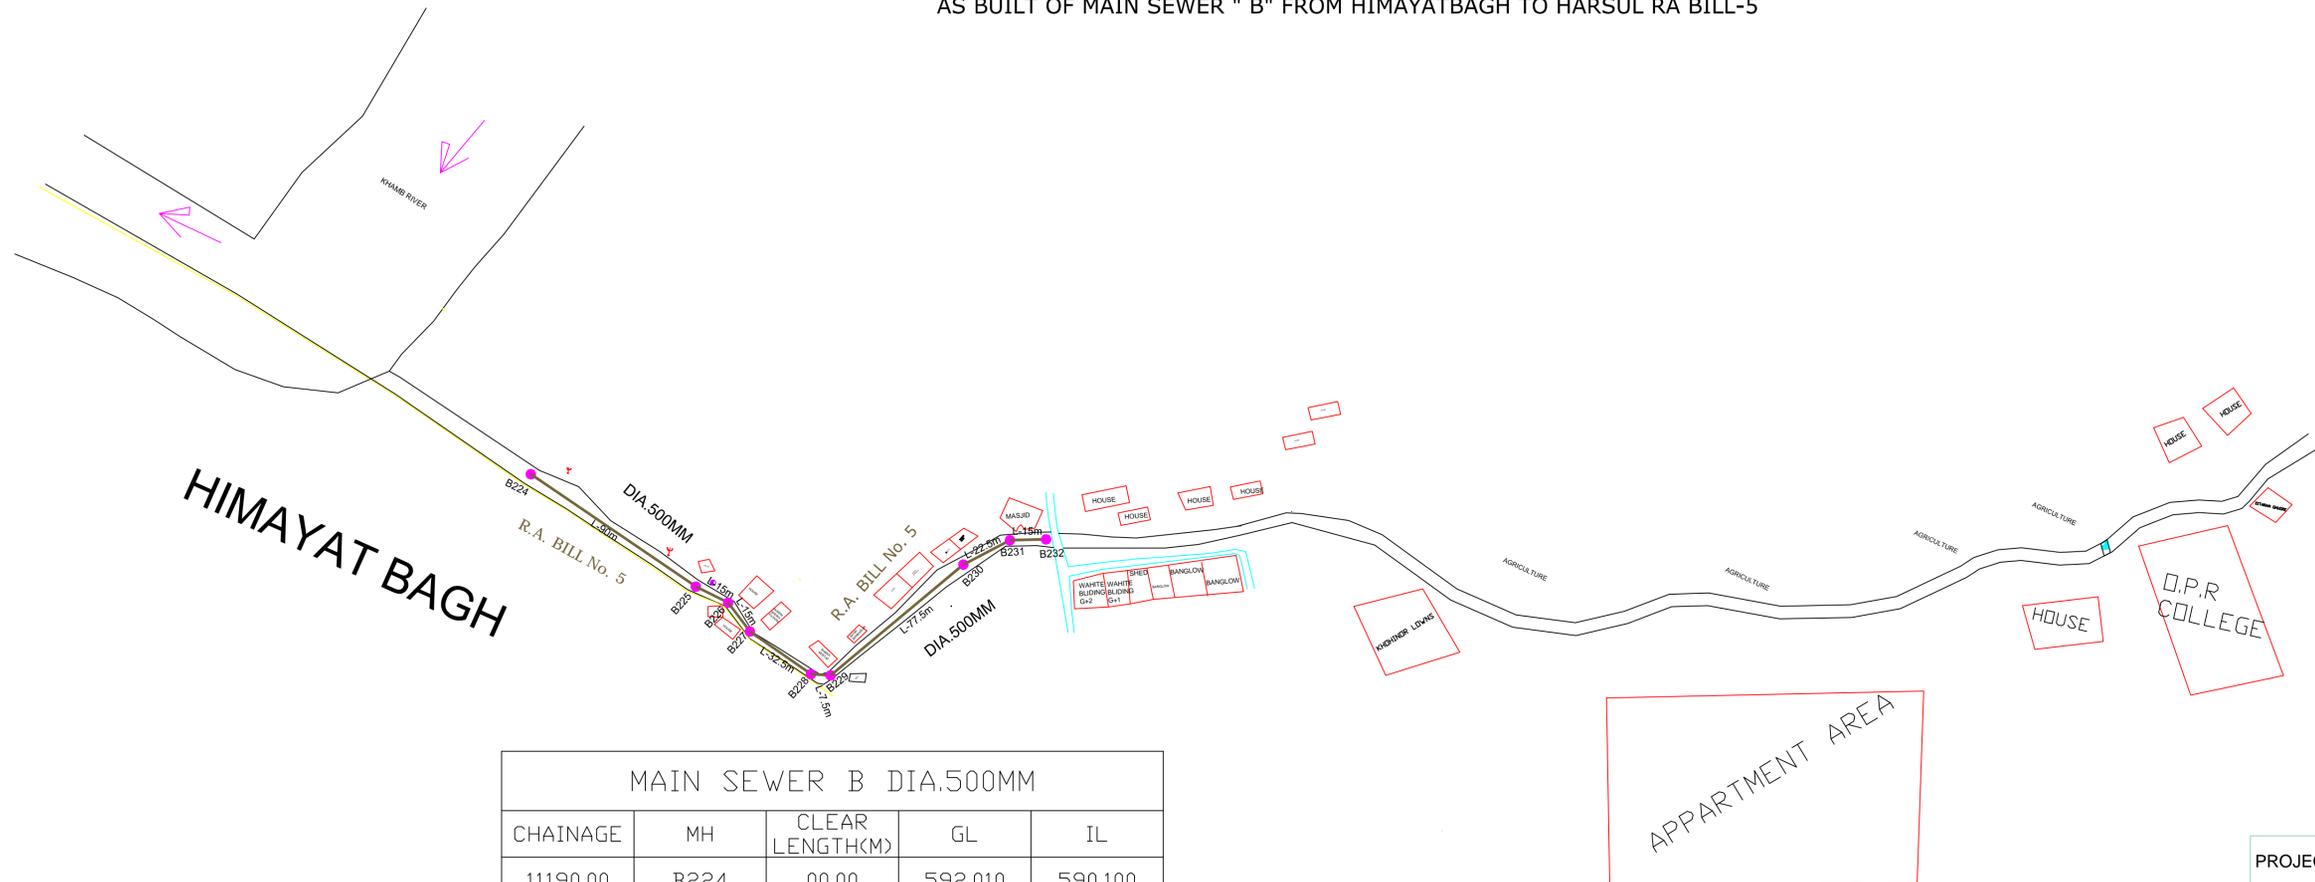

MAIN SEWER B DIA.500MM				
CHAINAGE	MH	CLEAR LENGTH(M)	GL	IL
11190.00	B224	00.00	592.010	590.100
11281.20	B225	90.00	592.580	590.118
11297.40	B226	15.00	593.090	590.120
11313.60	B227	15.00	592.915	590.135
11347.30	B228	32.50	592.540	590.156
11356.00	B229	7.50	592.770	590.158
11434.70	B230	77.50	593.255	590.380
11458.40	B231	22.50	593.255	590.445
11474.60	B232	15.00	593.505	590.505

APPARTMENT AREA

SCALE 1:1000

PROJECT:DEVELOPMENT OF SEWERAGE COLLECTION NETWORK UNDER UIDSSMT FOR AURANGABAD CITY


TITLE: AS BUILT OF MAIN SEWER " B" HIMAYATBAGH TO HARSUL

AURANGABAD MUNICIPAL CORPORATION,
TOWN HALL, AURANGABAD

AGENCY:KHILARI INFRASTRUCTURE PVT. LTD.
101, PRABHAT CENTER, SECT-1A, CBD, BELAPUR,
NAVI MUMBAI-400 614

CONSULTANT: FORTRESS INFRASTRUCTURE ADVISORY SERVICES,

AS BUILT OF MAIN SEWER " B" FROM HIMAYATBAGH TO HARSUL RA BILL-5

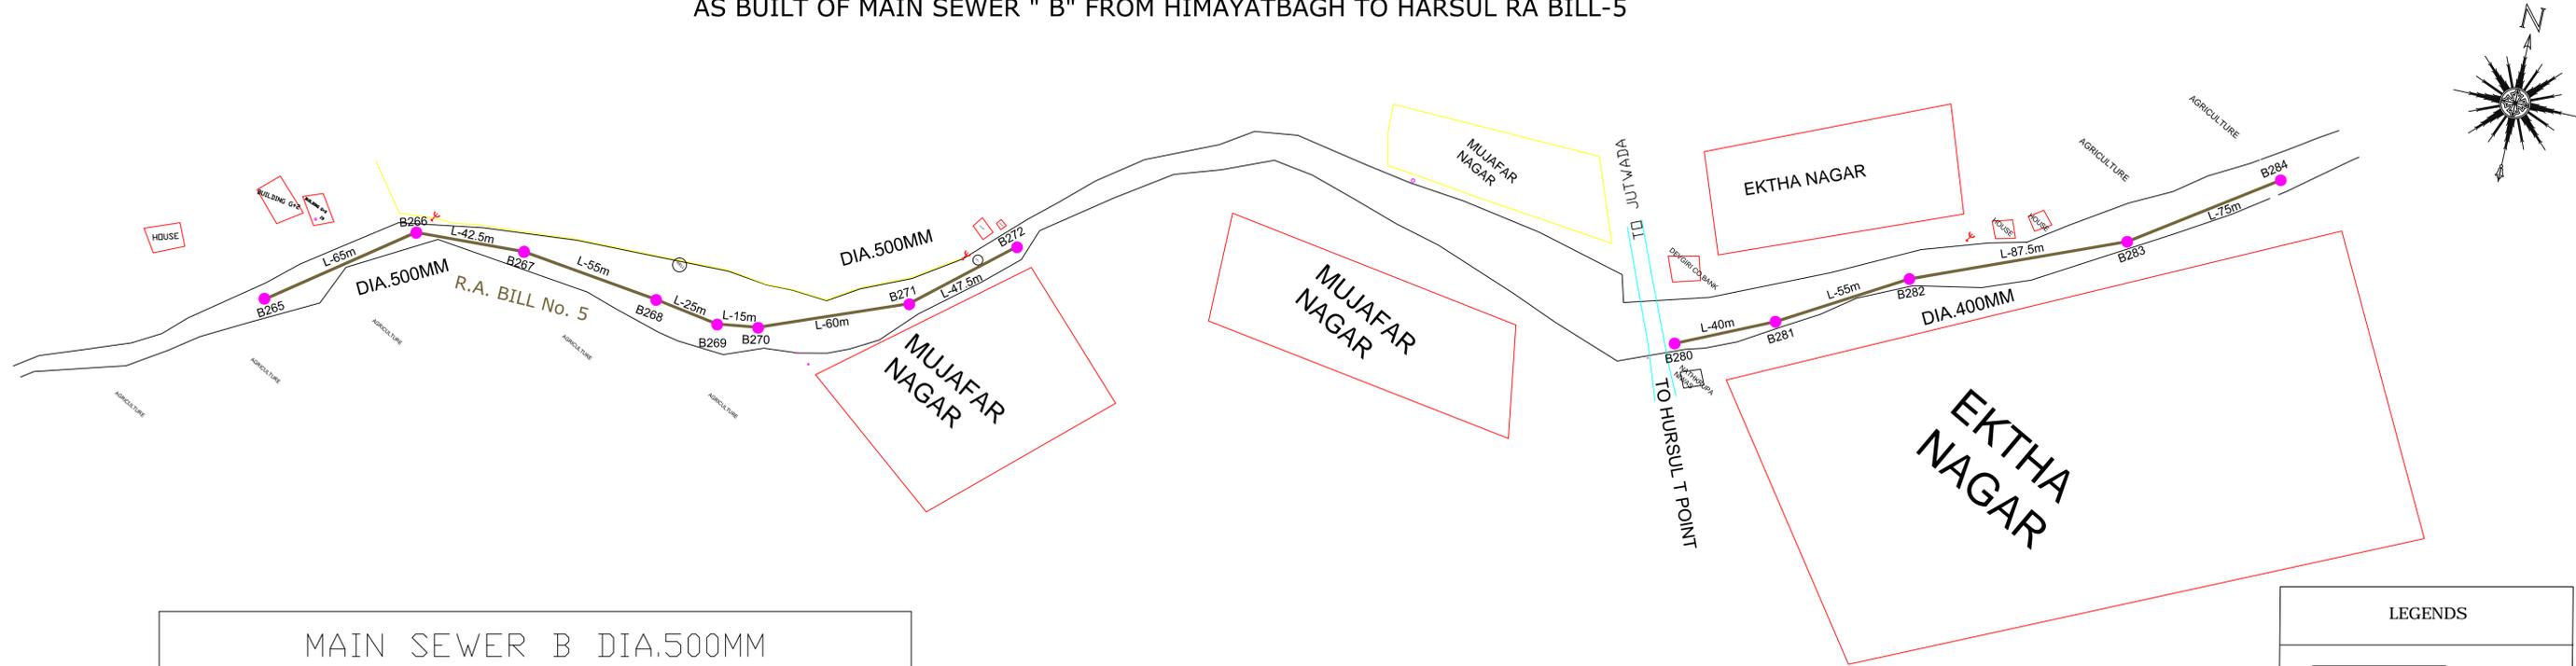

MAIN SEWER B DIA.500MM

CHAINAGE	MH	CLEAR LENGTH(M)	GL	IL
12270.00	B265	00.00	595.325	592.730
12336.20	B266	65.00	595.695	593.100
12379.90	B267	42.50	595.855	593.220
12436.10	B268	55.00	596.210	593.335
12462.30	B269	25.00	596.450	593.525
12478.50	B270	15.00	596.590	593.665
12539.70	B271	60.00	596.385	593.925
12588.40	B272	45.50	596.245	594.025

MAIN SEWER B DIA.400MM

CHAINAGE	MH	CLEAR LENGTH(M)	GL	IL
12870.00	B280	00.00	597.490	594.965
12911.20	B281	40.00	597.670	595.115
12967.40	B282	55.00	597.680	595.340
13056.10	B283	87.50	598.110	595.680
13132.30	B284	75.00	598.370	595.985

LEGENDS

RA BILL 5

PROJECT:DEVELOPMENT OF SEWERAGE COLLECTION NETWORK UNDER UIDSSMT FOR AURANGABAD CITY

TITLE: AS BUILT OF MAIN SEWER " B" HIMAYATBAGH TO HARSUL



AURANGABAD MUNICIPAL CORPORATION,
TOWN HALL, AURANGABAD




AGENCY:KHLARI INFRASTRUCTURE PVT. LTD.
101, PRABHAT CENTER, SECT-1A, CBD, BELAPUR,
NAVI MUMBAI-400 614

CONSULTANT: FORTRESS INFRASTRUCTURE
ADVISORY SERVICES,

SCALE 1:1000

AS BUILT DRAWING OF MAIN SEWER "C" NEAR SIDDHARTH GARDEN RA BILL -6

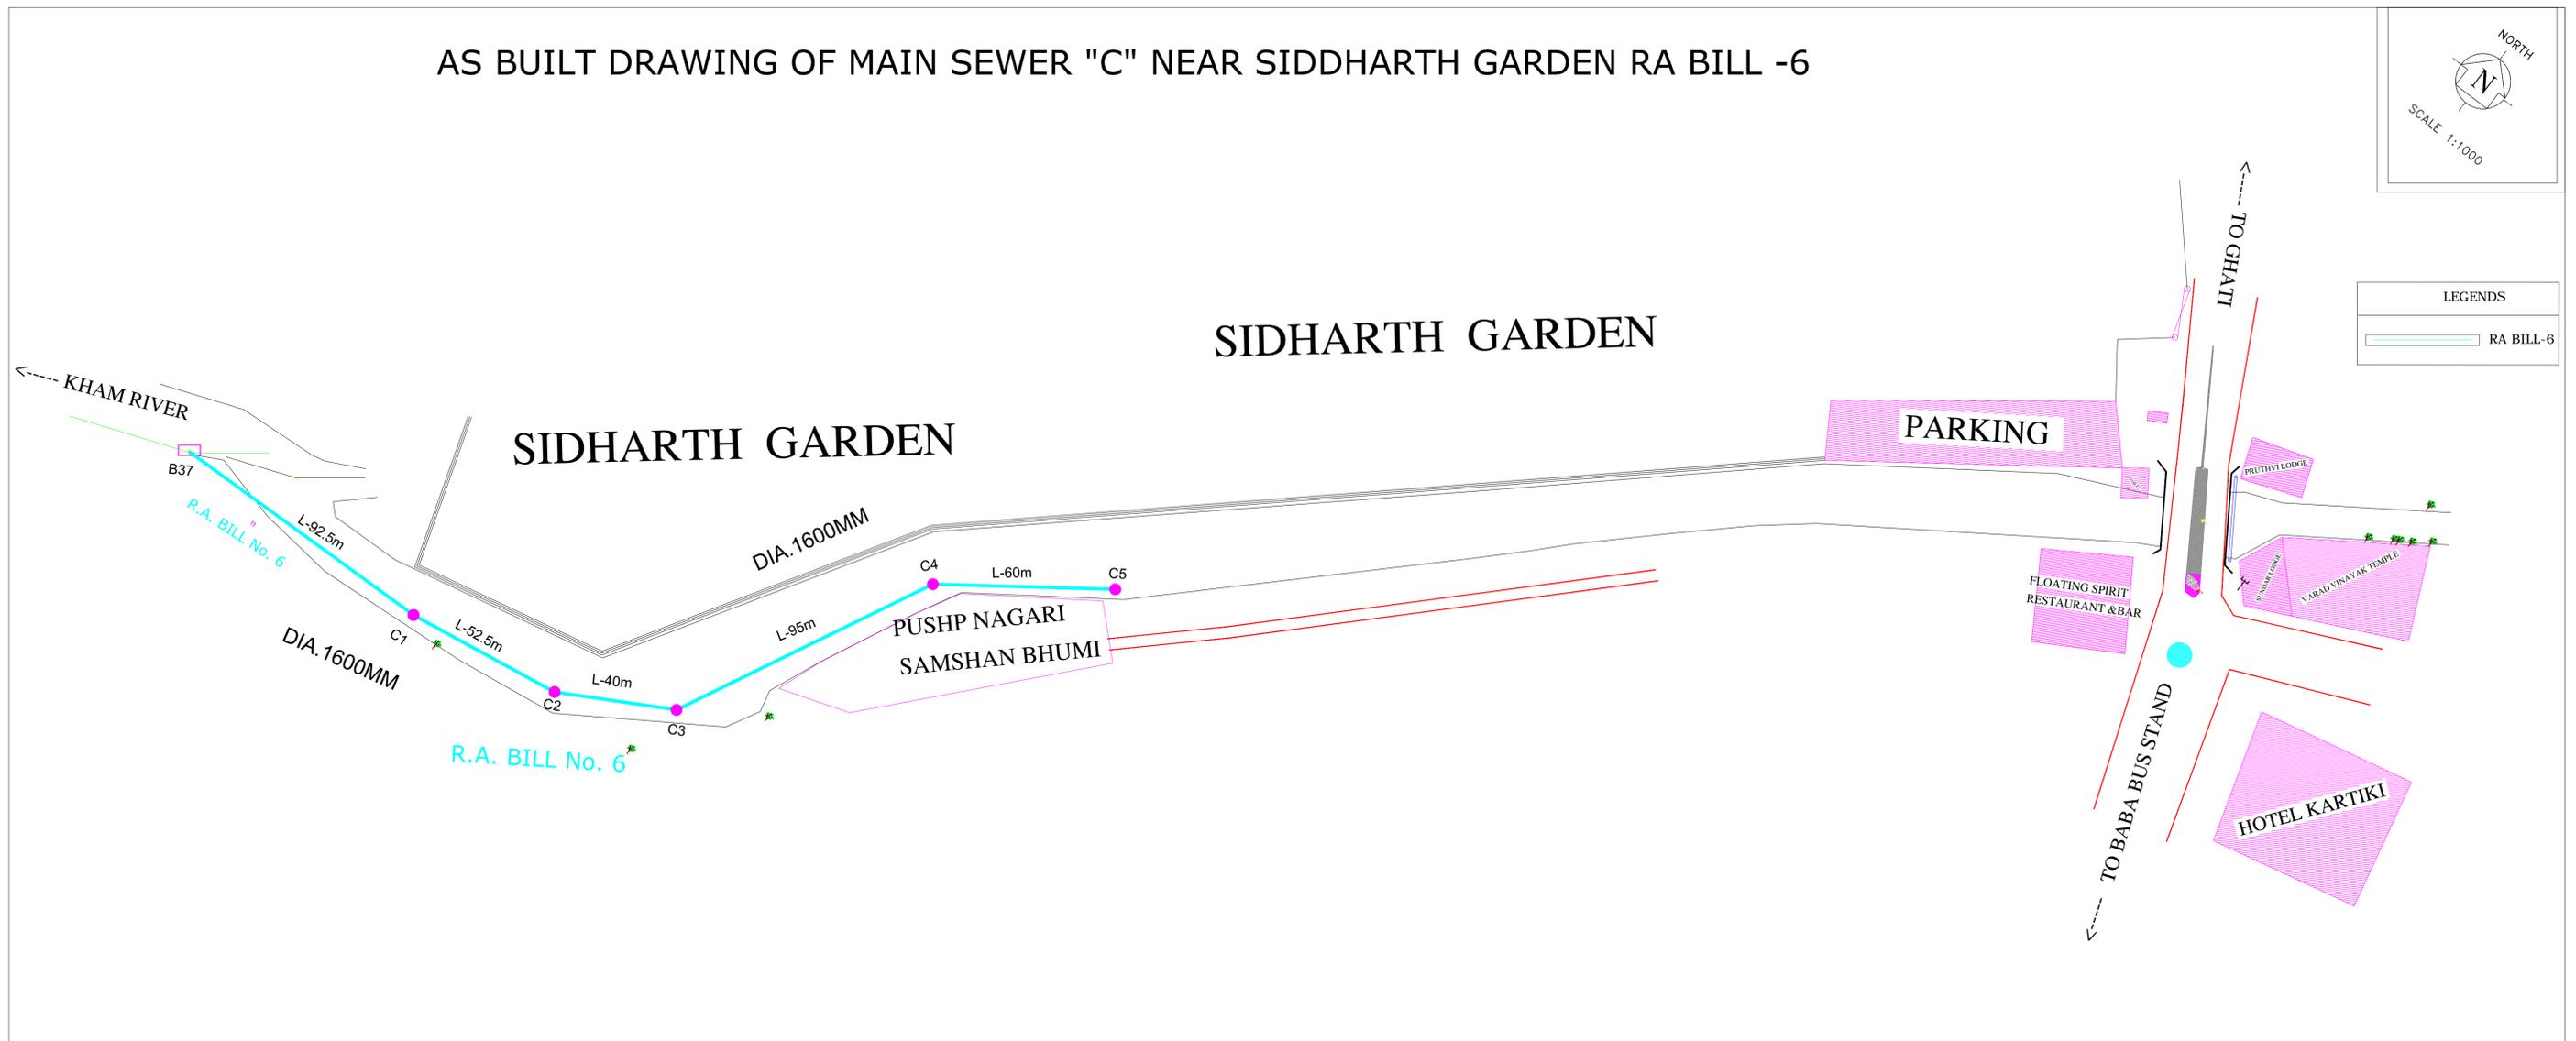

MAIN SEWER "C" -DIA.1600MM				
CHAINAGE	MH	CLEAR LENGTH(M)	GL	IL
0.00	B37	00.00	555.960	548.835
94.60	C1	92.50	557.800	549.470
149.20	C2	52.50	557.300	549.985
191.30	C3	40.00	555.920	550.340
288.40	C4	95.00	552.880	550.675
350.50	C5	60.00	553.035	550.765

PROJECT: DEVELOPMENT OF SEWERAGE COLLECTION NETWORK UNDER UIDSSMT FOR AURANGABAD CITY

TITLE: AS BUILT OF MAIN SEWER "C"

 AURANGABAD MUNICIPAL CORPORATION,
TOWN HALL, AURANGABAD

 AGENCY: KHILARI INFRASTRUCTURE PVT. LTD.
101, PRABHAT CENTER, SECT-1A, CBD, BELAPUR,
NAVI MUMBAI-400 614

CONSULTANT: FORTRESS INFRASTRUCTURE ADVISORY SERVICES, MARINE LINES, MUMBAI-2


AS BUILT DRAWING OF BRANCH SEWER "C" ROSHAN GATE TO CHAMPA CHOWK RA BILL-5



SCALE 1:1000

LEGENDS	
	RA BILL -5

BRANCH SEWER "C" DIA,500MM				
CHAINAGE	MH	CLEAR LENGTH(M)	GL	IL
0.00	RG1	0.00	575.620	572.800
31.50	RG2	30.00	575.850	573.120
63.00	RG3	30.00	576.790	573.770
94.50	RG4	30.00	577.780	574.430
126.00	RG5	30.00	578.700	575.450
157.50	RG6	30.00	579.180	576.010
189.00	RG7	30.00	579.290	576.290

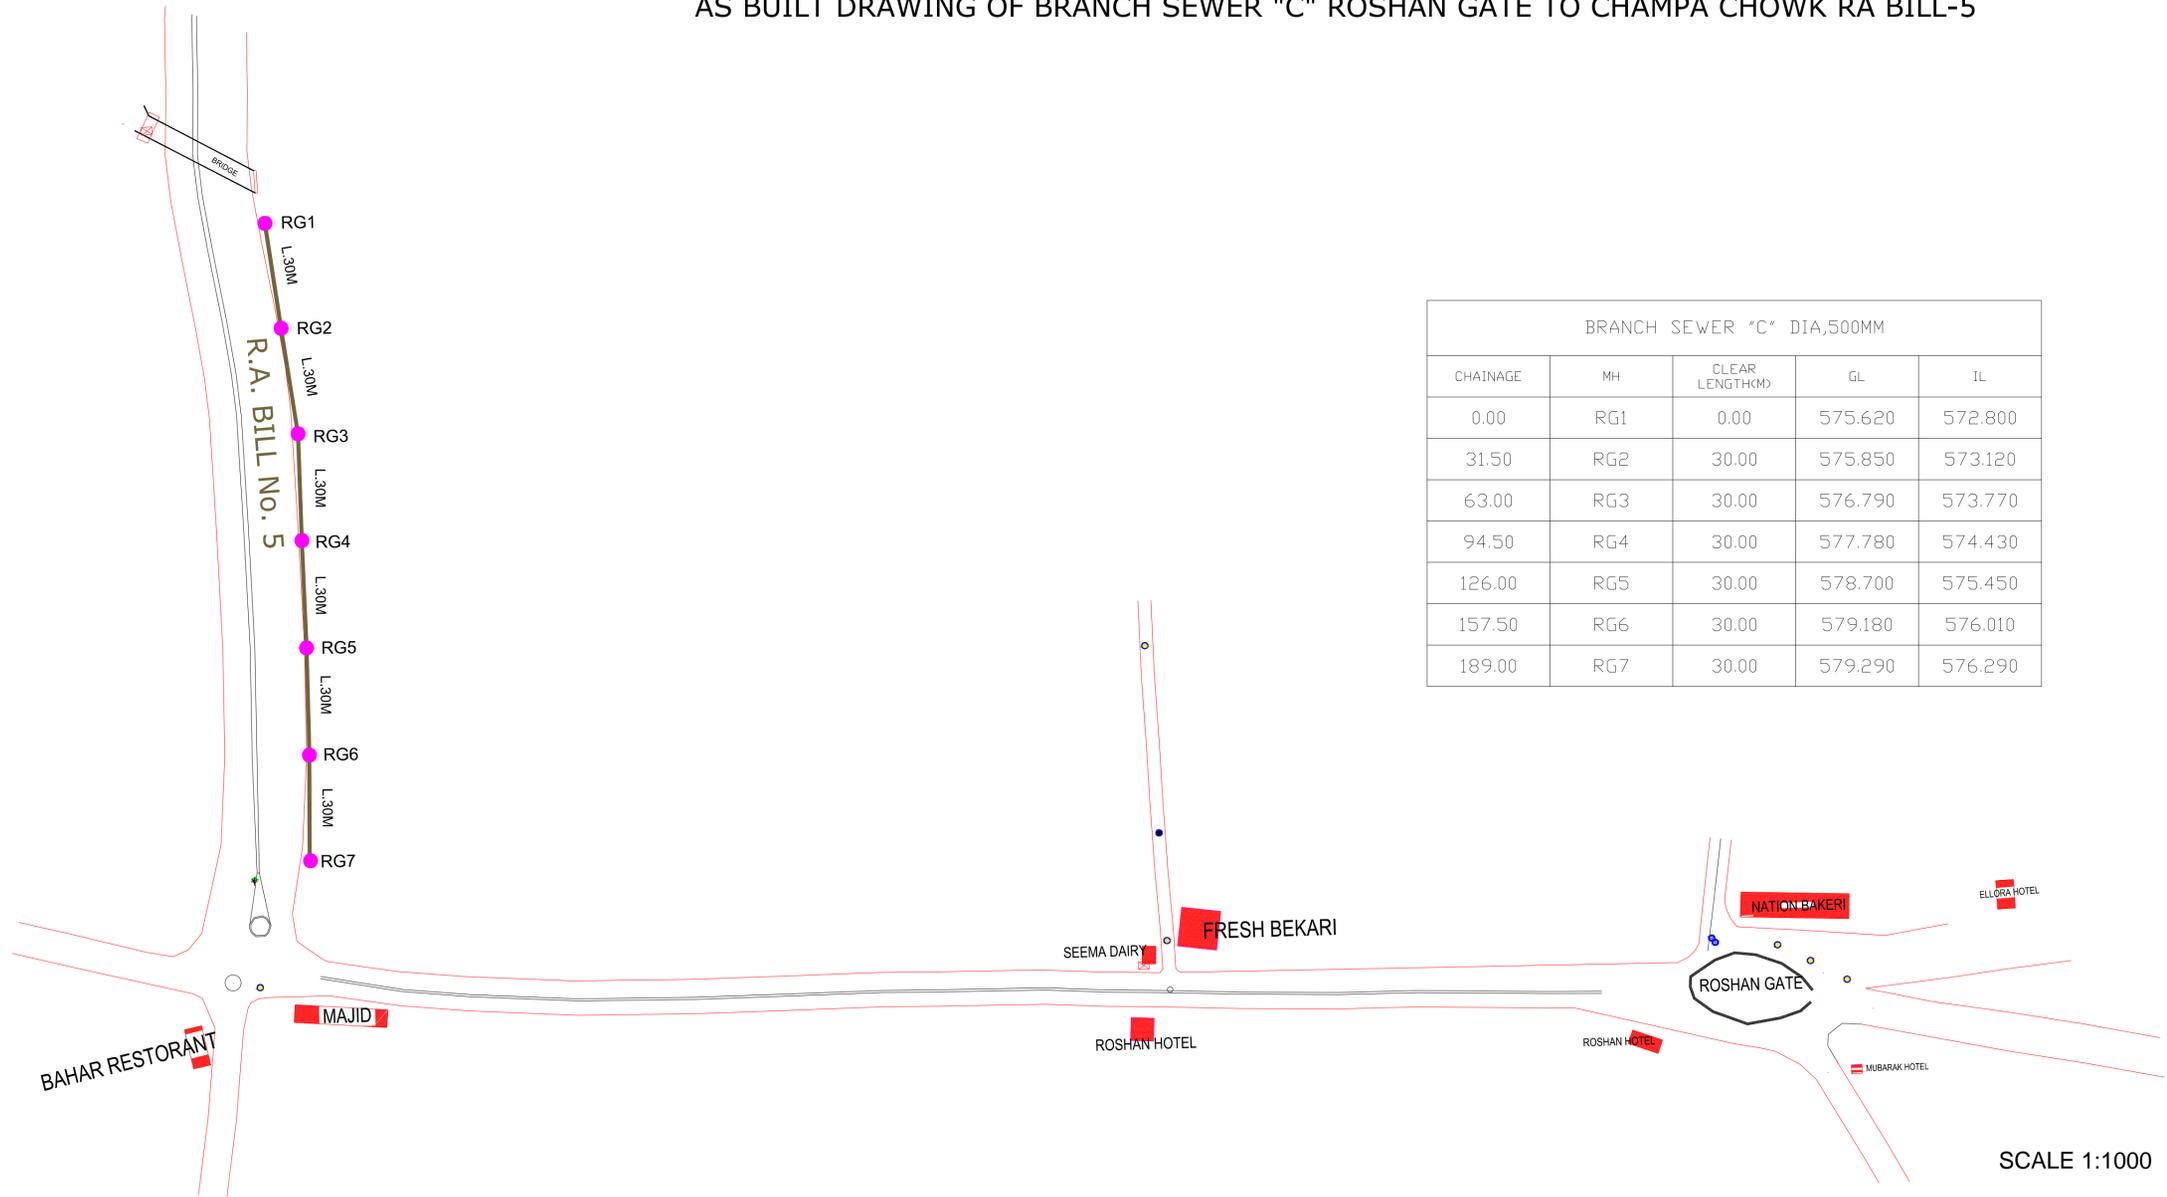


PROJECT: DEVELOPMENT OF SEWERAGE COLLECTION NETWORK UNDER UIDSSMT FOR AURANGABAD CITY

TITLE: AS BUILT OF BRANCH SEWER "C" DIA-500mm

 AURANGABAD MUNICIPAL CORPORATION, TOWN HALL, AURANGABAD

 AGENCY: KHILARI INFRASTRUCTURE PVT. LTD. 101, PRABHAT CENTER, SECT-1A, CBD, BELAPUR, NAVI MUMBAI-400 614

CONSULTANT: FORTRESS INFRASTRUCTURE ADVISORY SERVICES,

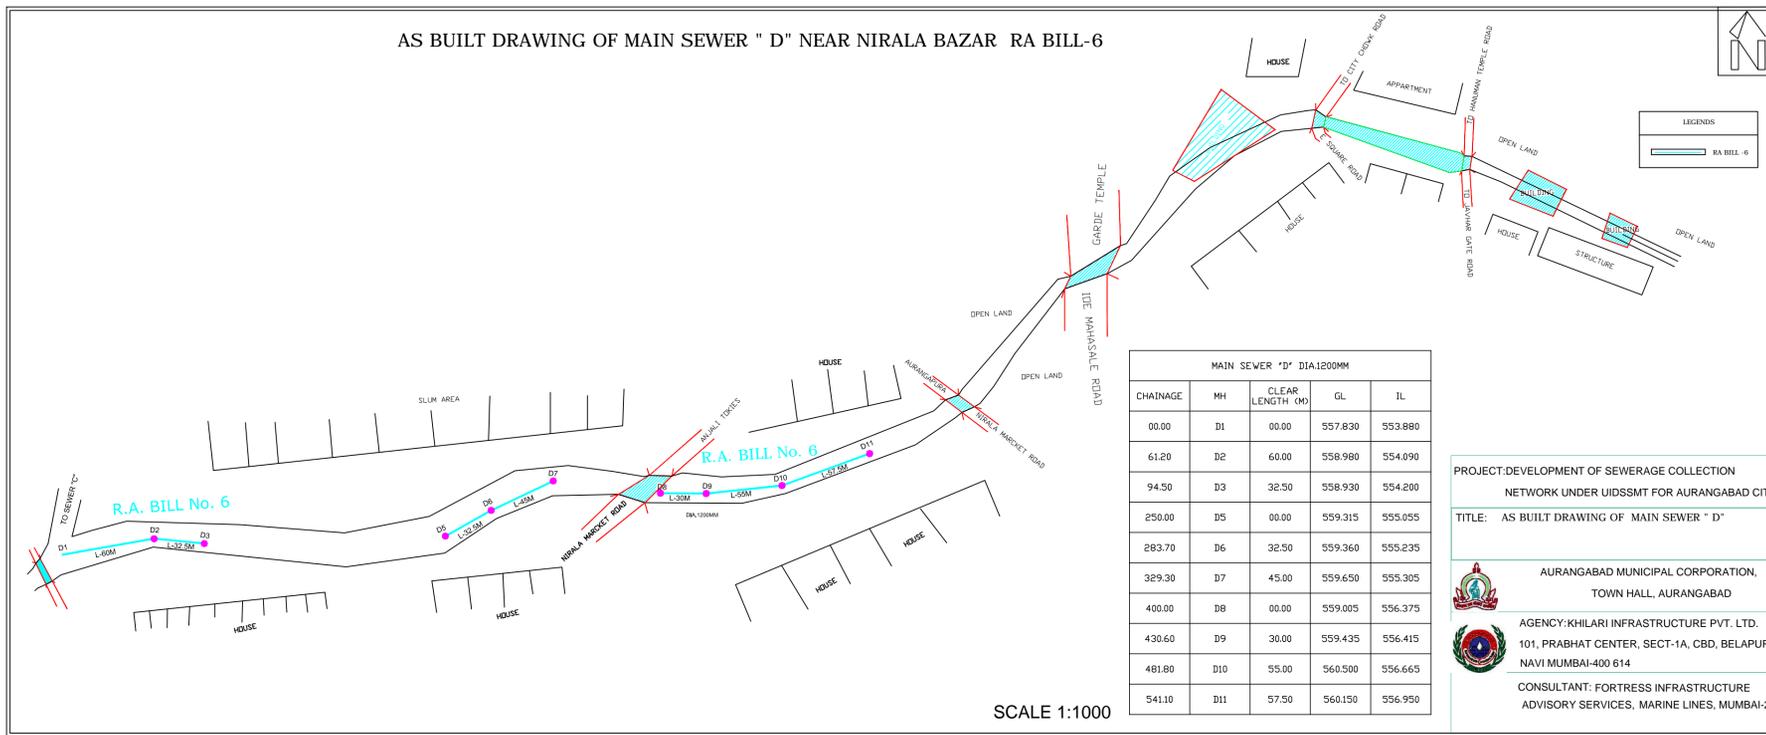


AS BUILT DRAWING OF BRANCH SEWER " D " FROM VARAD GANESH MANDIR TO SHILLEKHANA RA BILL-6

T1



AS BUILT DRAWING OF BRANCH SEWER " D" FROM VARAD GANESH MANDIR TO SHILLEKHANA RA BILL-6

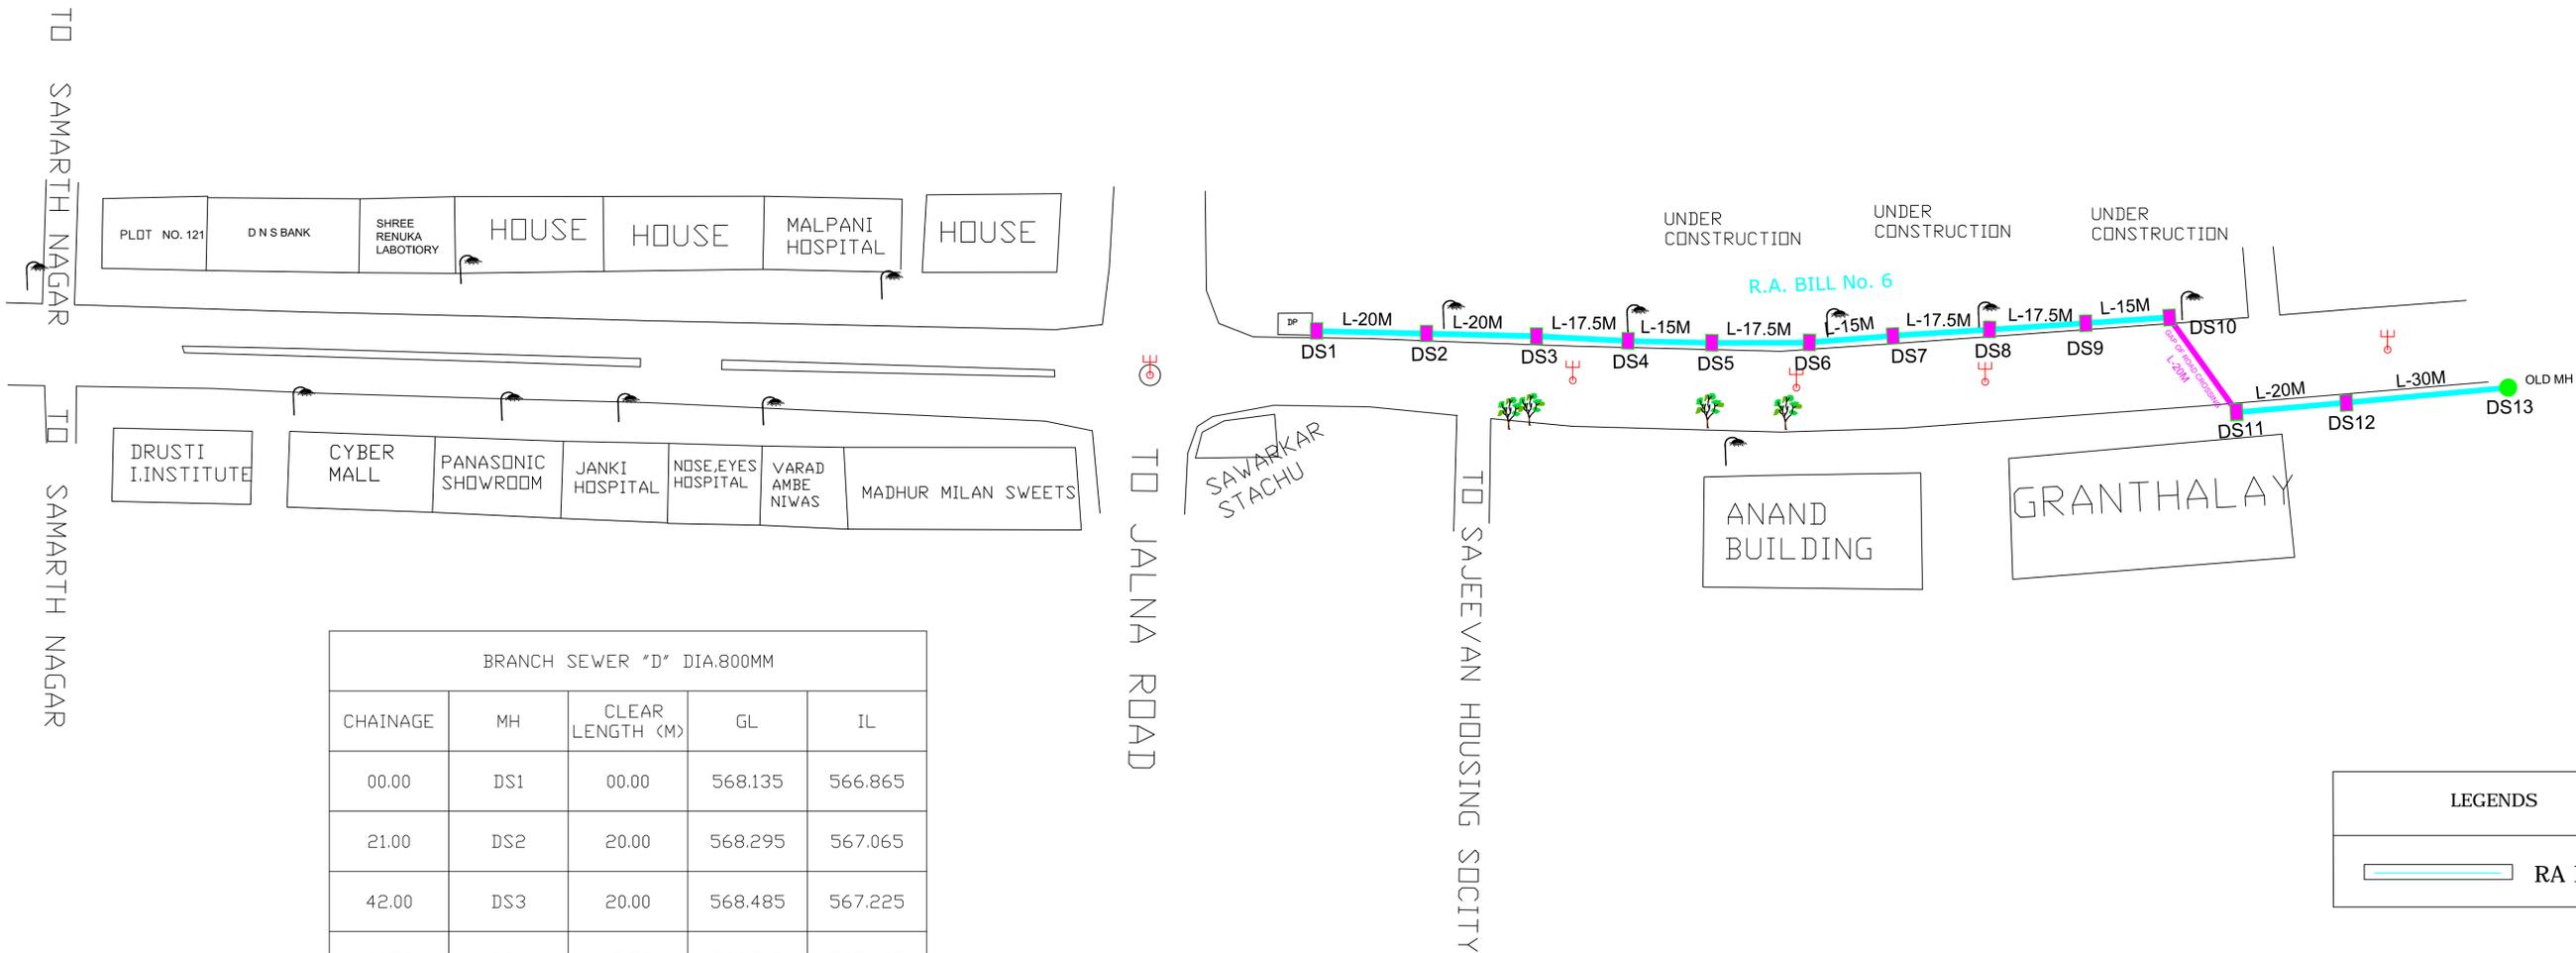

BRANCH SEWER "D" DIA.800MM				
CHAINAGE	MH	CLEAR LENGTH (M)	GL	IL
00.00	DS1	00.00	568.135	566.865
21.00	DS2	20.00	568.295	567.065
42.00	DS3	20.00	568.485	567.225
60.50	DS4	17.50	568.715	567.465
76.50	DS5	15.00	568.835	567.665
95.00	DS6	17.50	569.215	567.735
111.00	DS7	15.00	569.485	567.955
129.50	DS8	17.50	569.885	568.155
148.00	DS9	17.50	570.105	568.315
164.00	DS10	15.00	570.120	567.430
184.00	DS11	20.00	570.610	568.960
205.00	DS12	20.00	571.080	569.220
236.00	DS13	30.00	571.640	569.820

LEGENDS

RA BILL-6

PROJECT: DEVELOPMENT OF SEWERAGE COLLECTION NETWORK UNDER UIDSSMT FOR AURANGABAD CITY

TITLE: AS BUILT DRAWING OF BRANCH SEWER " D"


AURANGABAD MUNICIPAL CORPORATION, TOWN HALL, AURANGABAD

AGENCY: KHILARI INFRASTRUCTURE PVT. LTD. 101, PRABHAT CENTER, SECT-1A, CBD, BELAPUR, NAVI MUMBAI-400 614

CONSULTANT: FORTRESS INFRASTRUCTURE ADVISORY SERVICES, MARINE LINES, MUMBAI-2

SCALE 1:1000

AS BUILT DRAWING OF MAIN SEWER " E" RA BILL -6

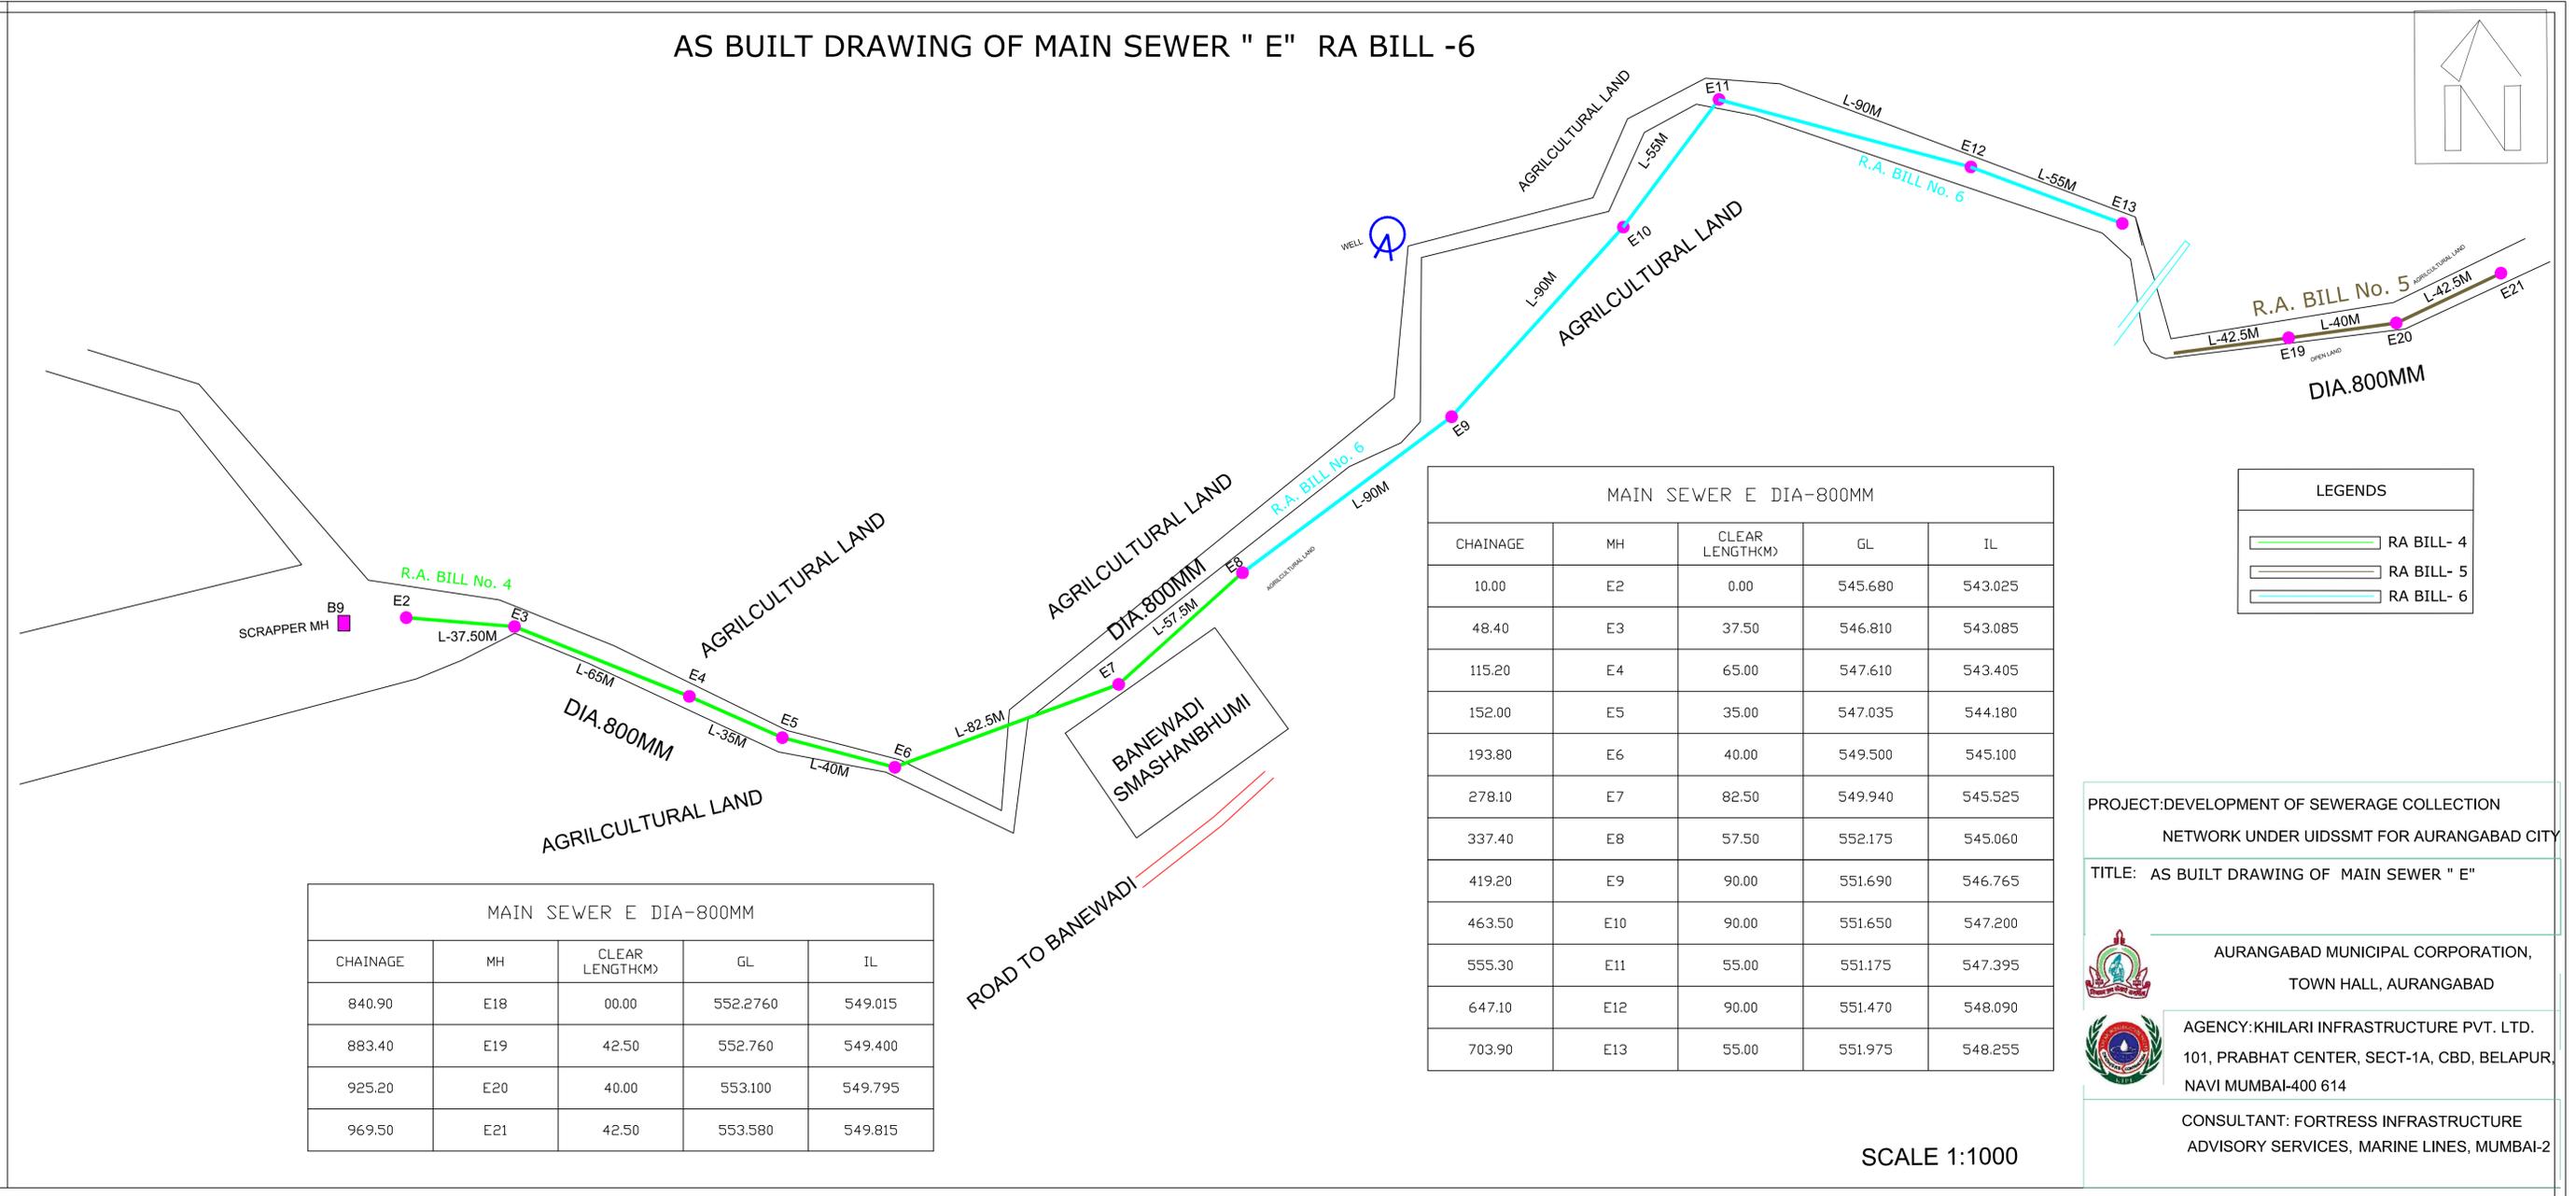

MAIN SEWER E DIA-800MM				
CHAINAGE	MH	CLEAR LENGTH(M)	GL	IL
840.90	E18	00.00	552.2760	549.015
883.40	E19	42.50	552.760	549.400
925.20	E20	40.00	553.100	549.795
969.50	E21	42.50	553.580	549.815

MAIN SEWER E DIA-800MM				
CHAINAGE	MH	CLEAR LENGTH(M)	GL	IL
10.00	E2	0.00	545.680	543.025
48.40	E3	37.50	546.810	543.085
115.20	E4	65.00	547.610	543.405
152.00	E5	35.00	547.035	544.180
193.80	E6	40.00	549.500	545.100
278.10	E7	82.50	549.940	545.525
337.40	E8	57.50	552.175	545.060
419.20	E9	90.00	551.690	546.765
463.50	E10	90.00	551.650	547.200
555.30	E11	55.00	551.175	547.395
647.10	E12	90.00	551.470	548.090
703.90	E13	55.00	551.975	548.255

LEGENDS	
	RA BILL- 4
	RA BILL- 5
	RA BILL- 6

PROJECT: DEVELOPMENT OF SEWERAGE COLLECTION NETWORK UNDER UIDSSMT FOR AURANGABAD CITY

TITLE: AS BUILT DRAWING OF MAIN SEWER " E"


AURANGABAD MUNICIPAL CORPORATION,
TOWN HALL, AURANGABAD

AGENCY: KHILARI INFRASTRUCTURE PVT. LTD.
101, PRABHAT CENTER, SECT-1A, CBD, BELAPUR,
NAVI MUMBAI-400 614

CONSULTANT: FORTRESS INFRASTRUCTURE ADVISORY SERVICES, MARINE LINES, MUMBAI-2

SCALE 1:1000

AS BUILT DRAWING OF MAIN SEWER " E " RA BILL -6

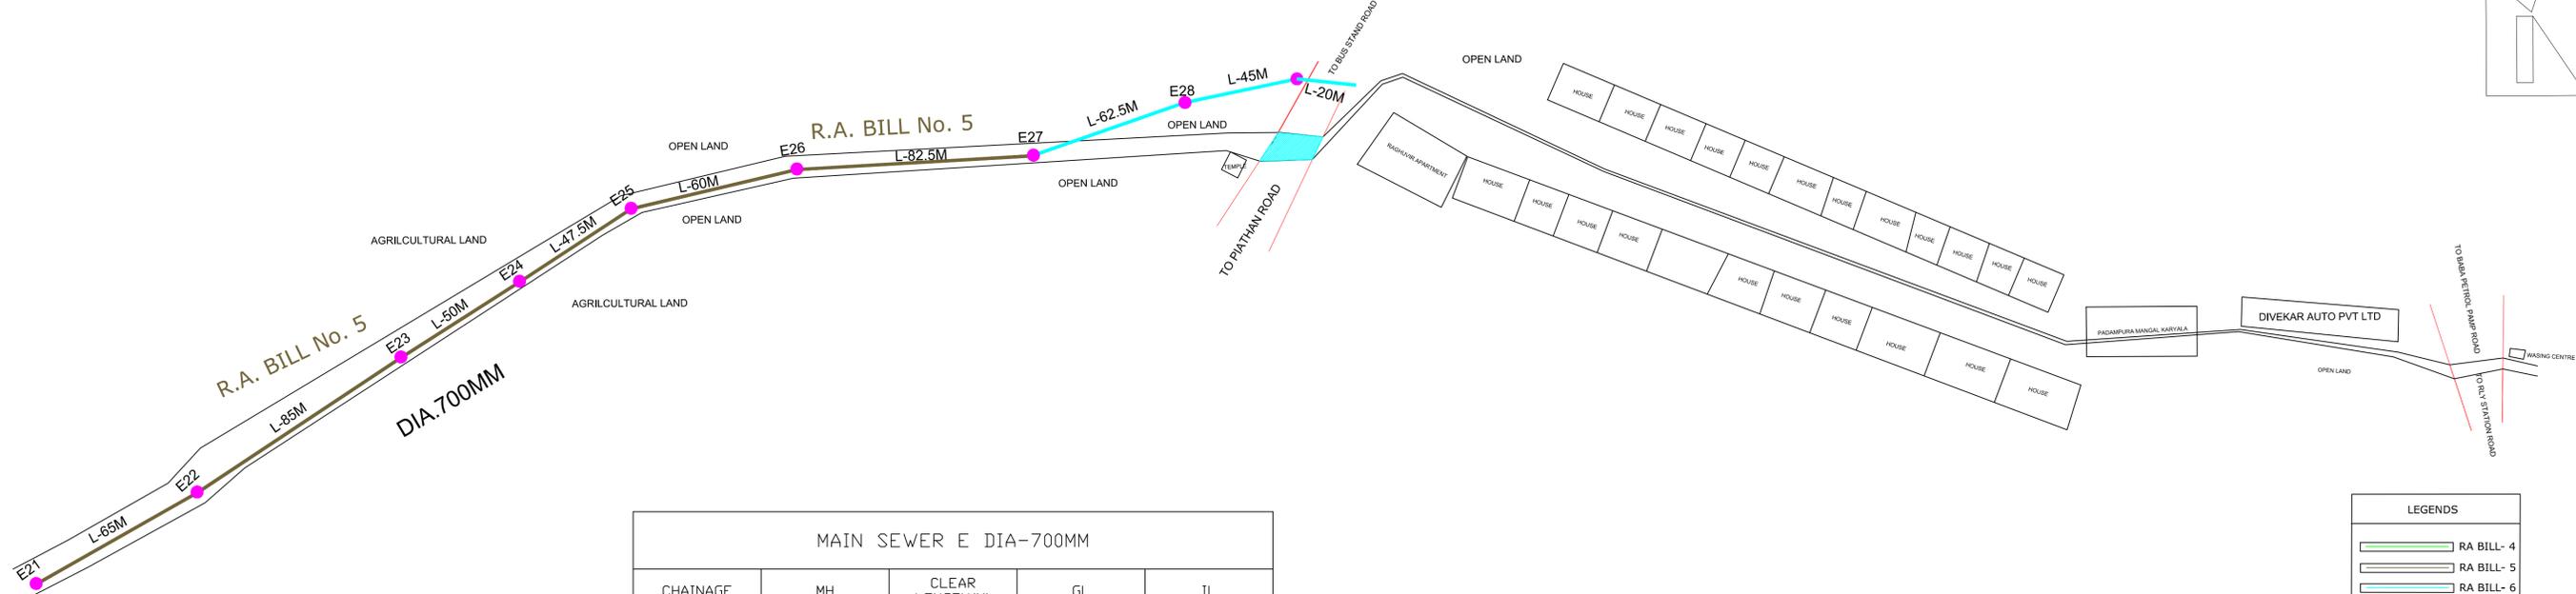

MAIN SEWER E DIA-700MM				
CHAINAGE	MH	CLEAR LENGTH(M)	GL	IL
969.50	E21	42.50	553.580	550.115 /549.815
1036.30	E22	65.00	553.975	550.410
1123.10	E23	85.00	554.655	551.040
1174.90	E24	50.00	554.975	551.300
1224.20	E25	47.50	555.230	551.855
1285.95	E26	60.00	555.670	552.395
1369.90	E27	82.50	557.000	552.540

MAIN SEWER E DIA-700MM				
CHAINAGE	MH	CLEAR LENGTH(M)	GL	IL
1369.90	E27	82.50	557.000	552.995
1434.20	E28	62.50	557.225	553.490
1480.70	E29	45.00	557.250	554.240
1501.30	E30	20.00	559.166	554.266

LEGENDS	
	RA BILL- 4
	RA BILL- 5
	RA BILL- 6

PROJECT:DEVELOPMENT OF SEWERAGE COLLECTION NETWORK UNDER UIDSSMT FOR AURANGABAD CITY

TITLE: AS BUILT DRAWING OF MAIN SEWER " E "



AURANGABAD MUNICIPAL CORPORATION,
TOWN HALL, AURANGABAD




AGENCY:KHILARI INFRASTRUCTURE PVT. LTD.
101, PRABHAT CENTER, SECT-1A, CBD, BELAPUR,
NAVI MUMBAI-400 614


CONSULTANT: FORTRESS INFRASTRUCTURE
ADVISORY SERVICES, MARINE LINES, MUMBAI-2

SCALE 1:1000

AS BUILT DRAWING OF BRANCH SEWER " E" RA BILL -5

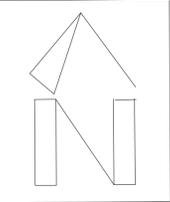

LEGENDS	
	RA BILL - 5

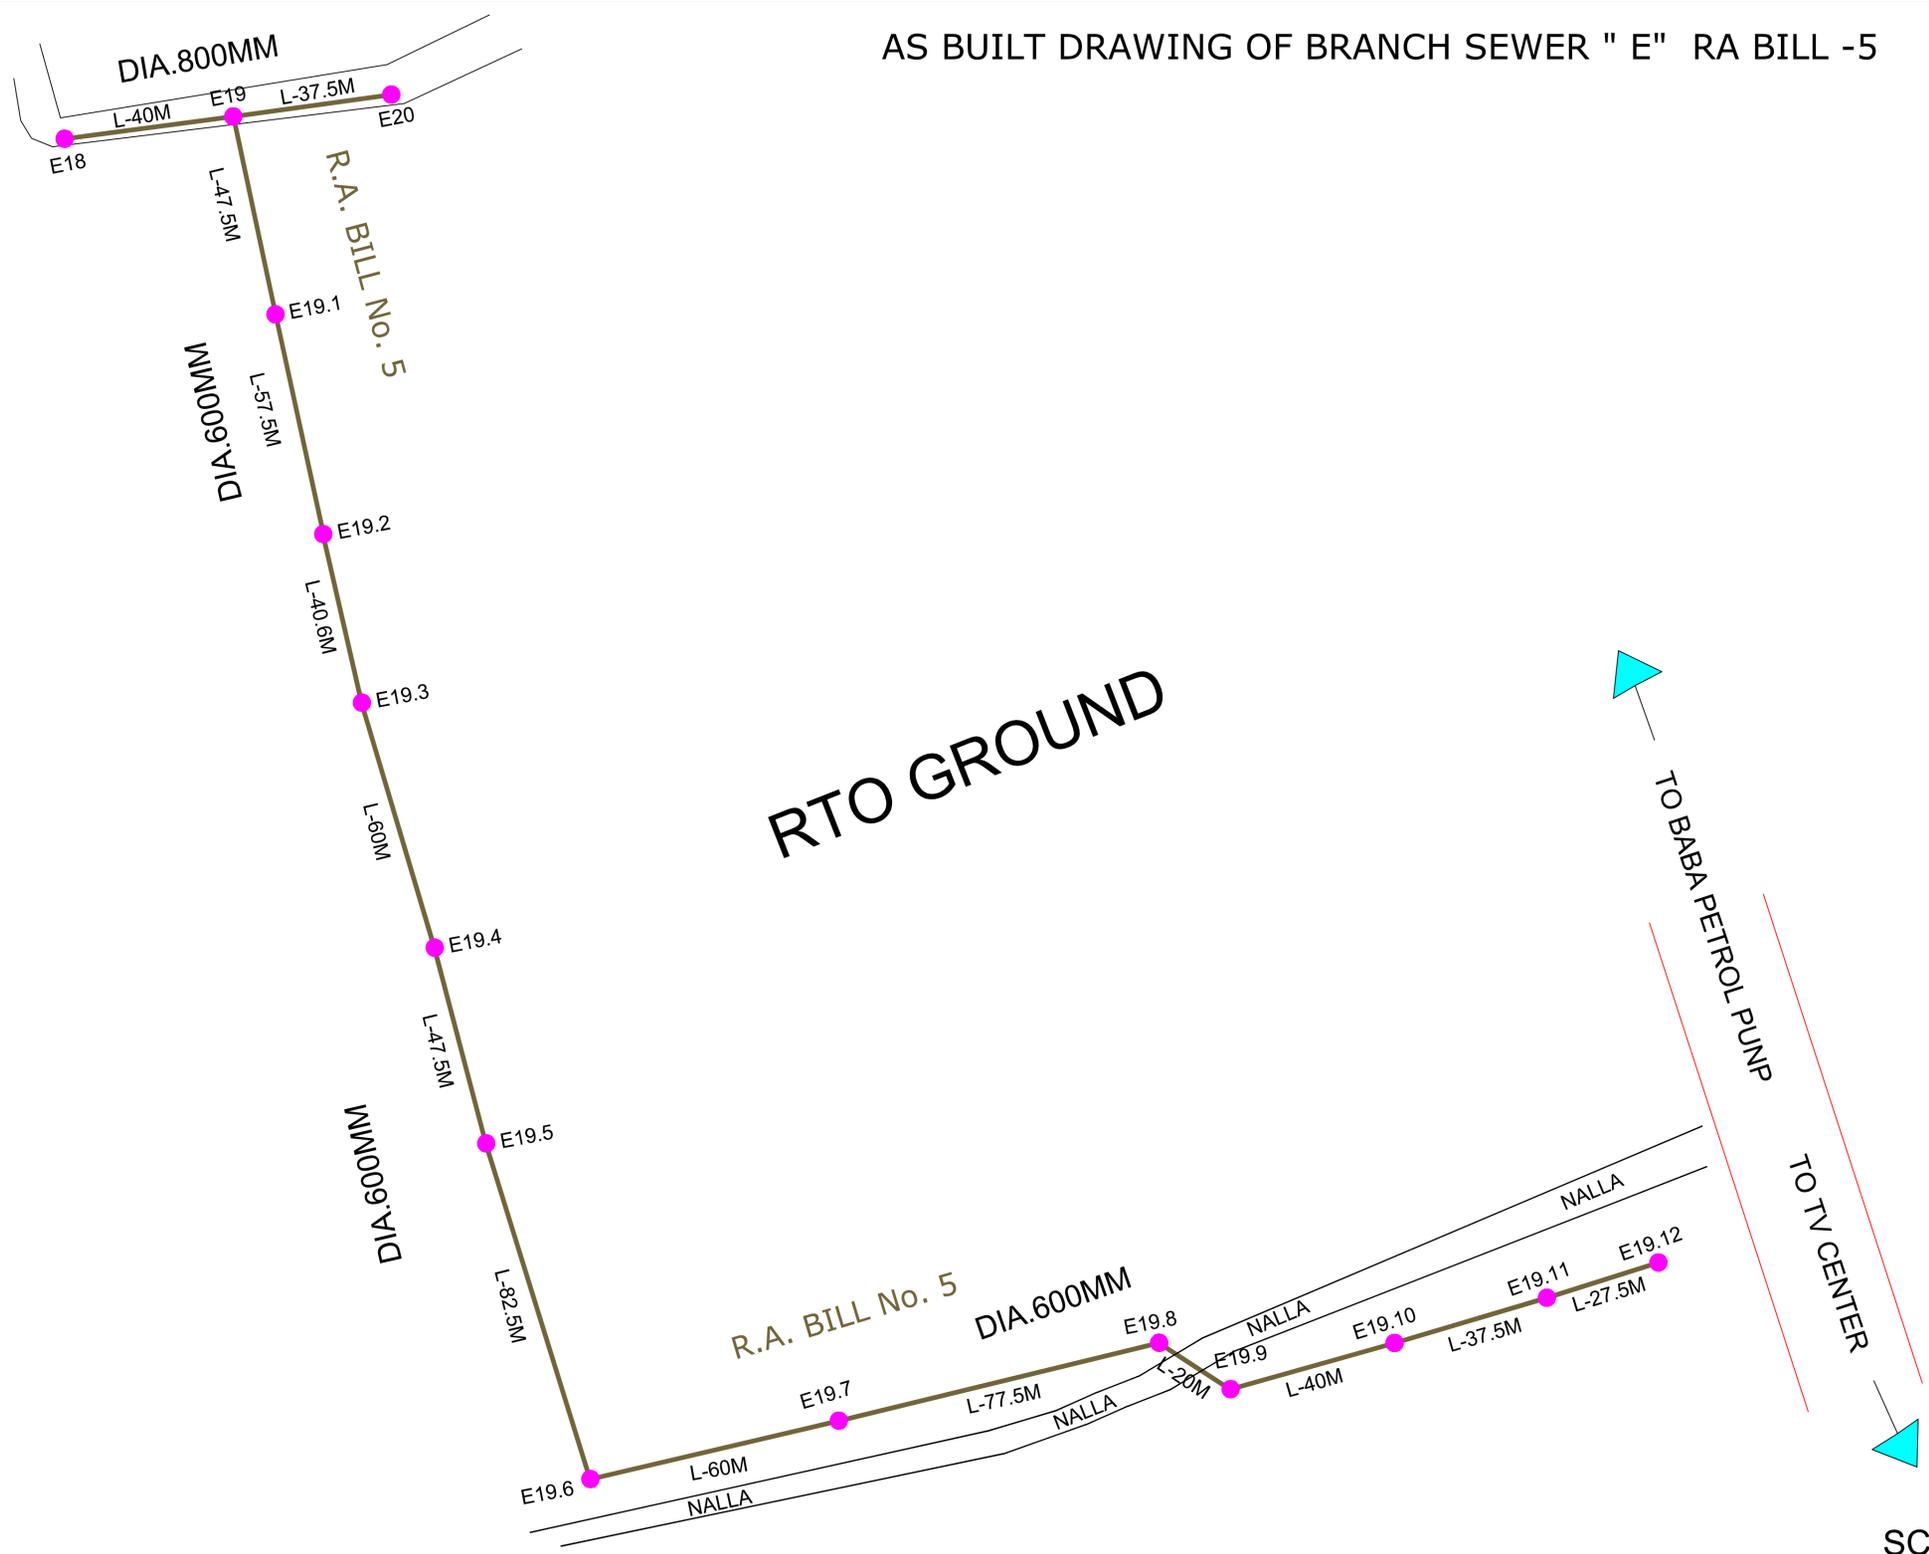

BRANCH SEWER E DIA-600MM				
CHAINAGE	MH	CLEAR LENGTH(M)	GL	IL
00.00	E19	00.00	552.835	550.545
48.10	E19.1	47.50	554.825	551.930
101.80	E19.2	52.50	556.395	552.595
143.00	E19.3	40.60	557.500	553.520
204.20	E19.4	60.00	557.550	554.000
252.90	E19.5	47.50	557.350	554.130
336.60	E19.6	82.50	556.630	554.345
397.80	E19.7	60.00	556.915	554.470
476.50	E19.8	77.50	557.262	554.555
497.70	E19.9	20.00	557.100	554.850
538.90	E19.10	40.00	557.310	554.890
577.60	E19.11	37.50	557.700	554.960
605.70	E19.12	27.50	557.820	554.990

PROJECT:DEVELOPMENT OF SEWERAGE COLLECTION NETWORK UNDER UIDSSMT FOR AURANGABAD CITY

TITLE: AS BUILT DRAWING OF BRANCH SEWER " E"




AURANGABAD MUNICIPAL CORPORATION,
TOWN HALL, AURANGABAD




AGENCY:KHLARI INFRASTRUCTURE PVT. LTD.
101, PRABHAT CENTER, SECT-1A, CBD, BELAPUR,
NAVI MUMBAI-400 614

CONSULTANT: FORTRESS INFRASTRUCTURE
ADVISORY SERVICES, MARINE LINES, MUMBAI-2

SCALE 1:1000

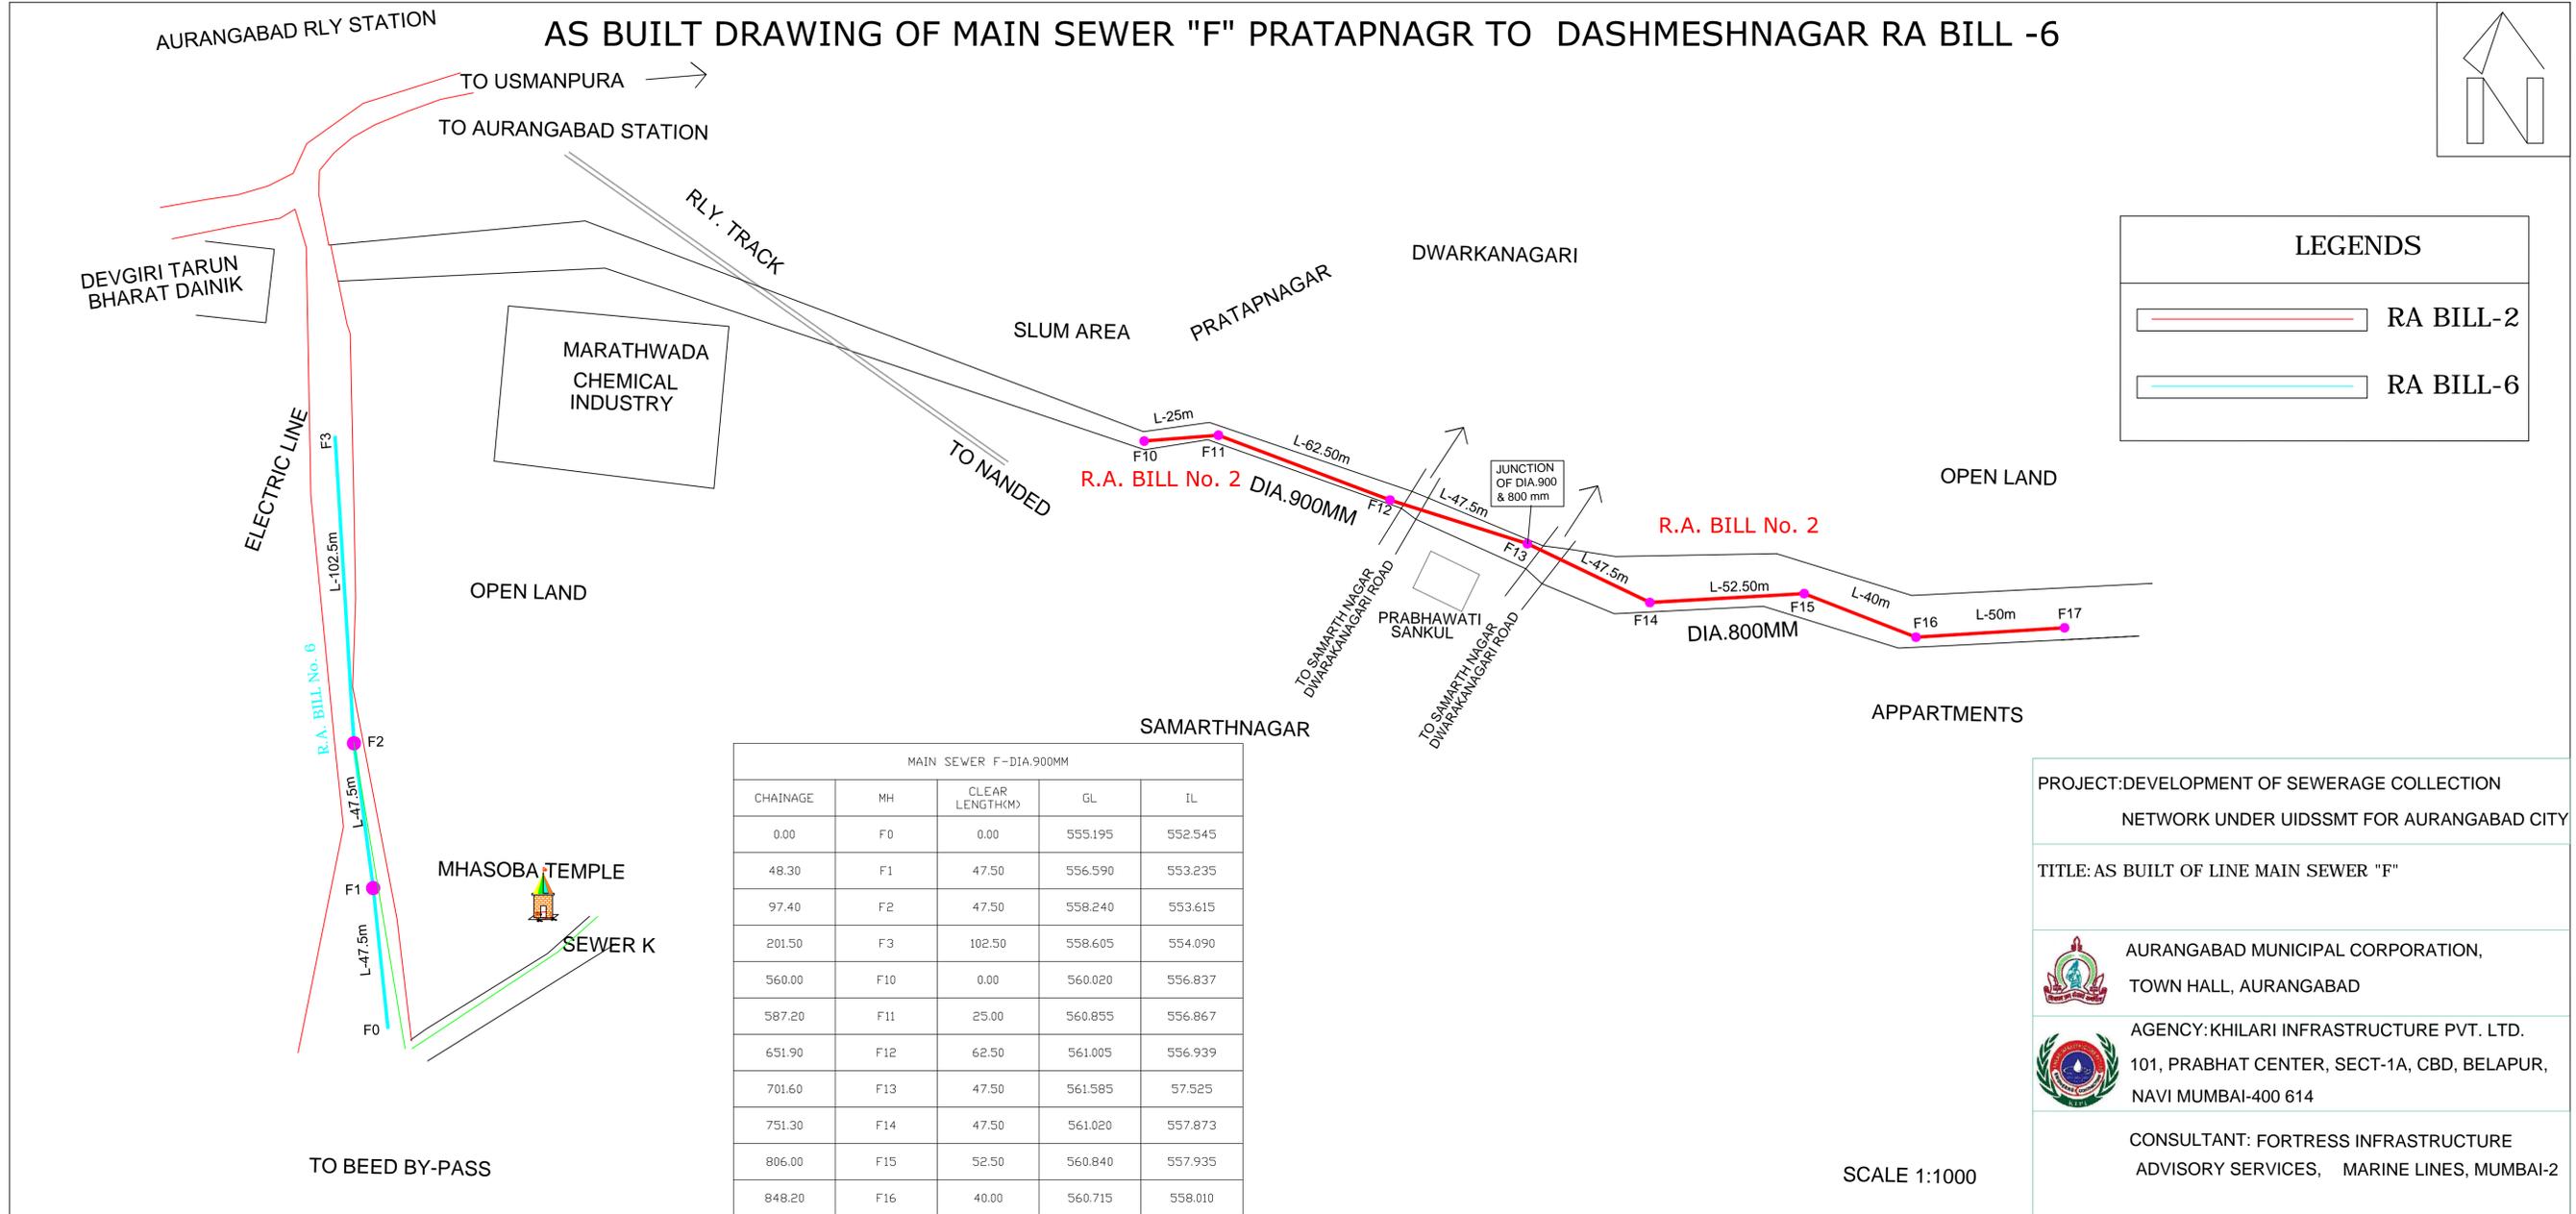

AS BUILT DRAWING OF MAIN SEWER "F" PRATAPNAGR TO DASHMESHNAGAR RA BILL-3

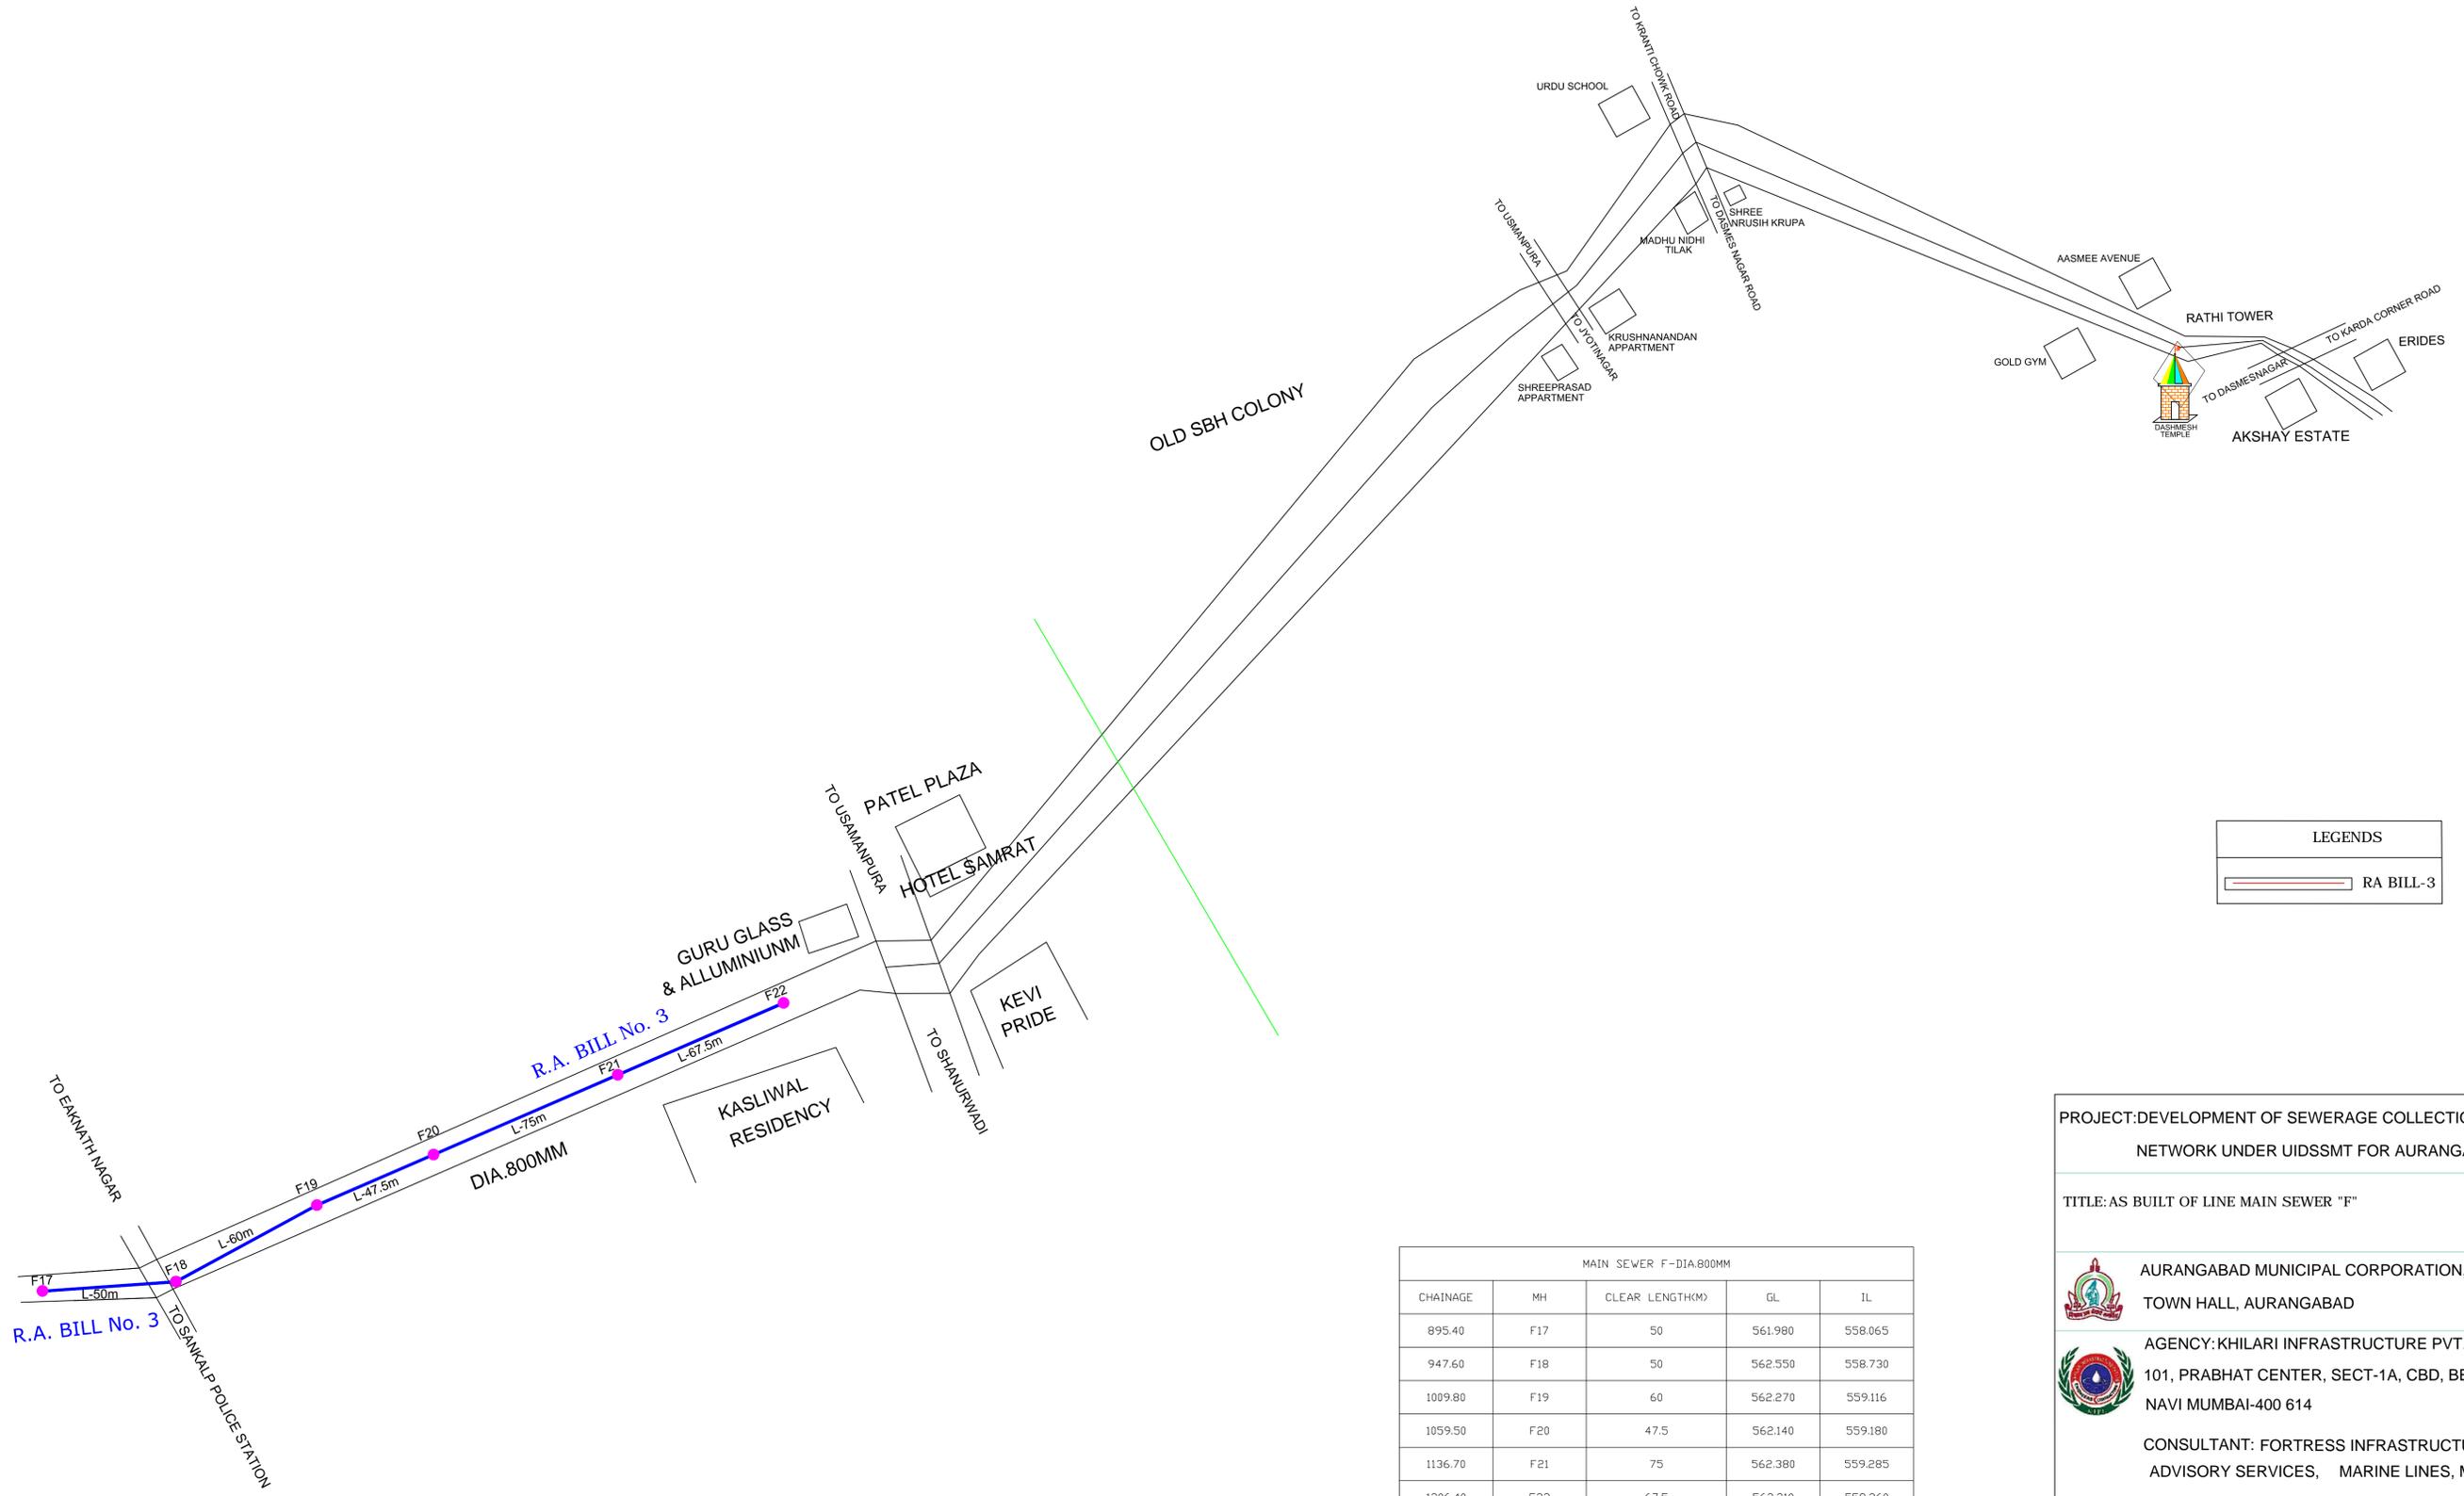

LEGENDS	
	RA BILL-3

MAIN SEWER F-DIA.800MM				
CHAINAGE	MH	CLEAR LENGTH(M)	GL	IL
895.40	F17	50	561.980	558.065
947.60	F18	50	562.550	558.730
1009.80	F19	60	562.270	559.116
1059.50	F20	47.5	562.140	559.180
1136.70	F21	75	562.380	559.285
1206.40	F22	67.5	563.210	559.360

PROJECT: DEVELOPMENT OF SEWERAGE COLLECTION NETWORK UNDER UIDSSMT FOR AURANGABAD CITY

TITLE: AS BUILT OF LINE MAIN SEWER "F"

AURANGABAD MUNICIPAL CORPORATION,
TOWN HALL, AURANGABAD



AGENCY: KHILARI INFRASTRUCTURE PVT. LTD.
101, PRABHAT CENTER, SECT-1A, CBD, BELAPUR,
NAVI MUMBAI-400 614

CONSULTANT: FORTRESS INFRASTRUCTURE ADVISORY SERVICES, MARINE LINES, MUMBAI-2

AS BUILT DRAWING OF MAIN SEWER " K " FROM NYAYANAGAR TO GOLWADI SPS (R.A. BILL-1 TO R.A.-6)

SHEET 1/10

MAIN SEWER DIA.1400MM					483.00	K9	85.00	533.880	528.00
CHAINAGE	MH	CLEAR LENGTH (M)	GL	IL	552.00	K10	67.50	534.700	528.070
0.50	K2	0.00	531.925	526.495	589.50	K11	37.50	535.740	528.100
82.00	K3	80.00	531.480	526.880	693.50	K12	102.50	535.450	528.205
158.50	K4	75.00	533.450	526.950	735.00	K13	40.00	535.320	528.520
230.00	K5	70.00	532.685	527.135	832.50	K14	97.50	535.360	528.865
296.50	K6	65.00	532.945	527.275	965.00	K15	132.50	535.410	529.200
365.00	K7	67.50	533.235	527.430	1045.00	K16	80.00	535.585	529.405
396.50	K8	30.00	533.670	527.720	1152.50	K17	107.50	536.412	529.512

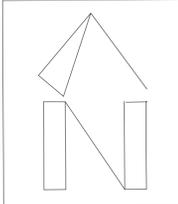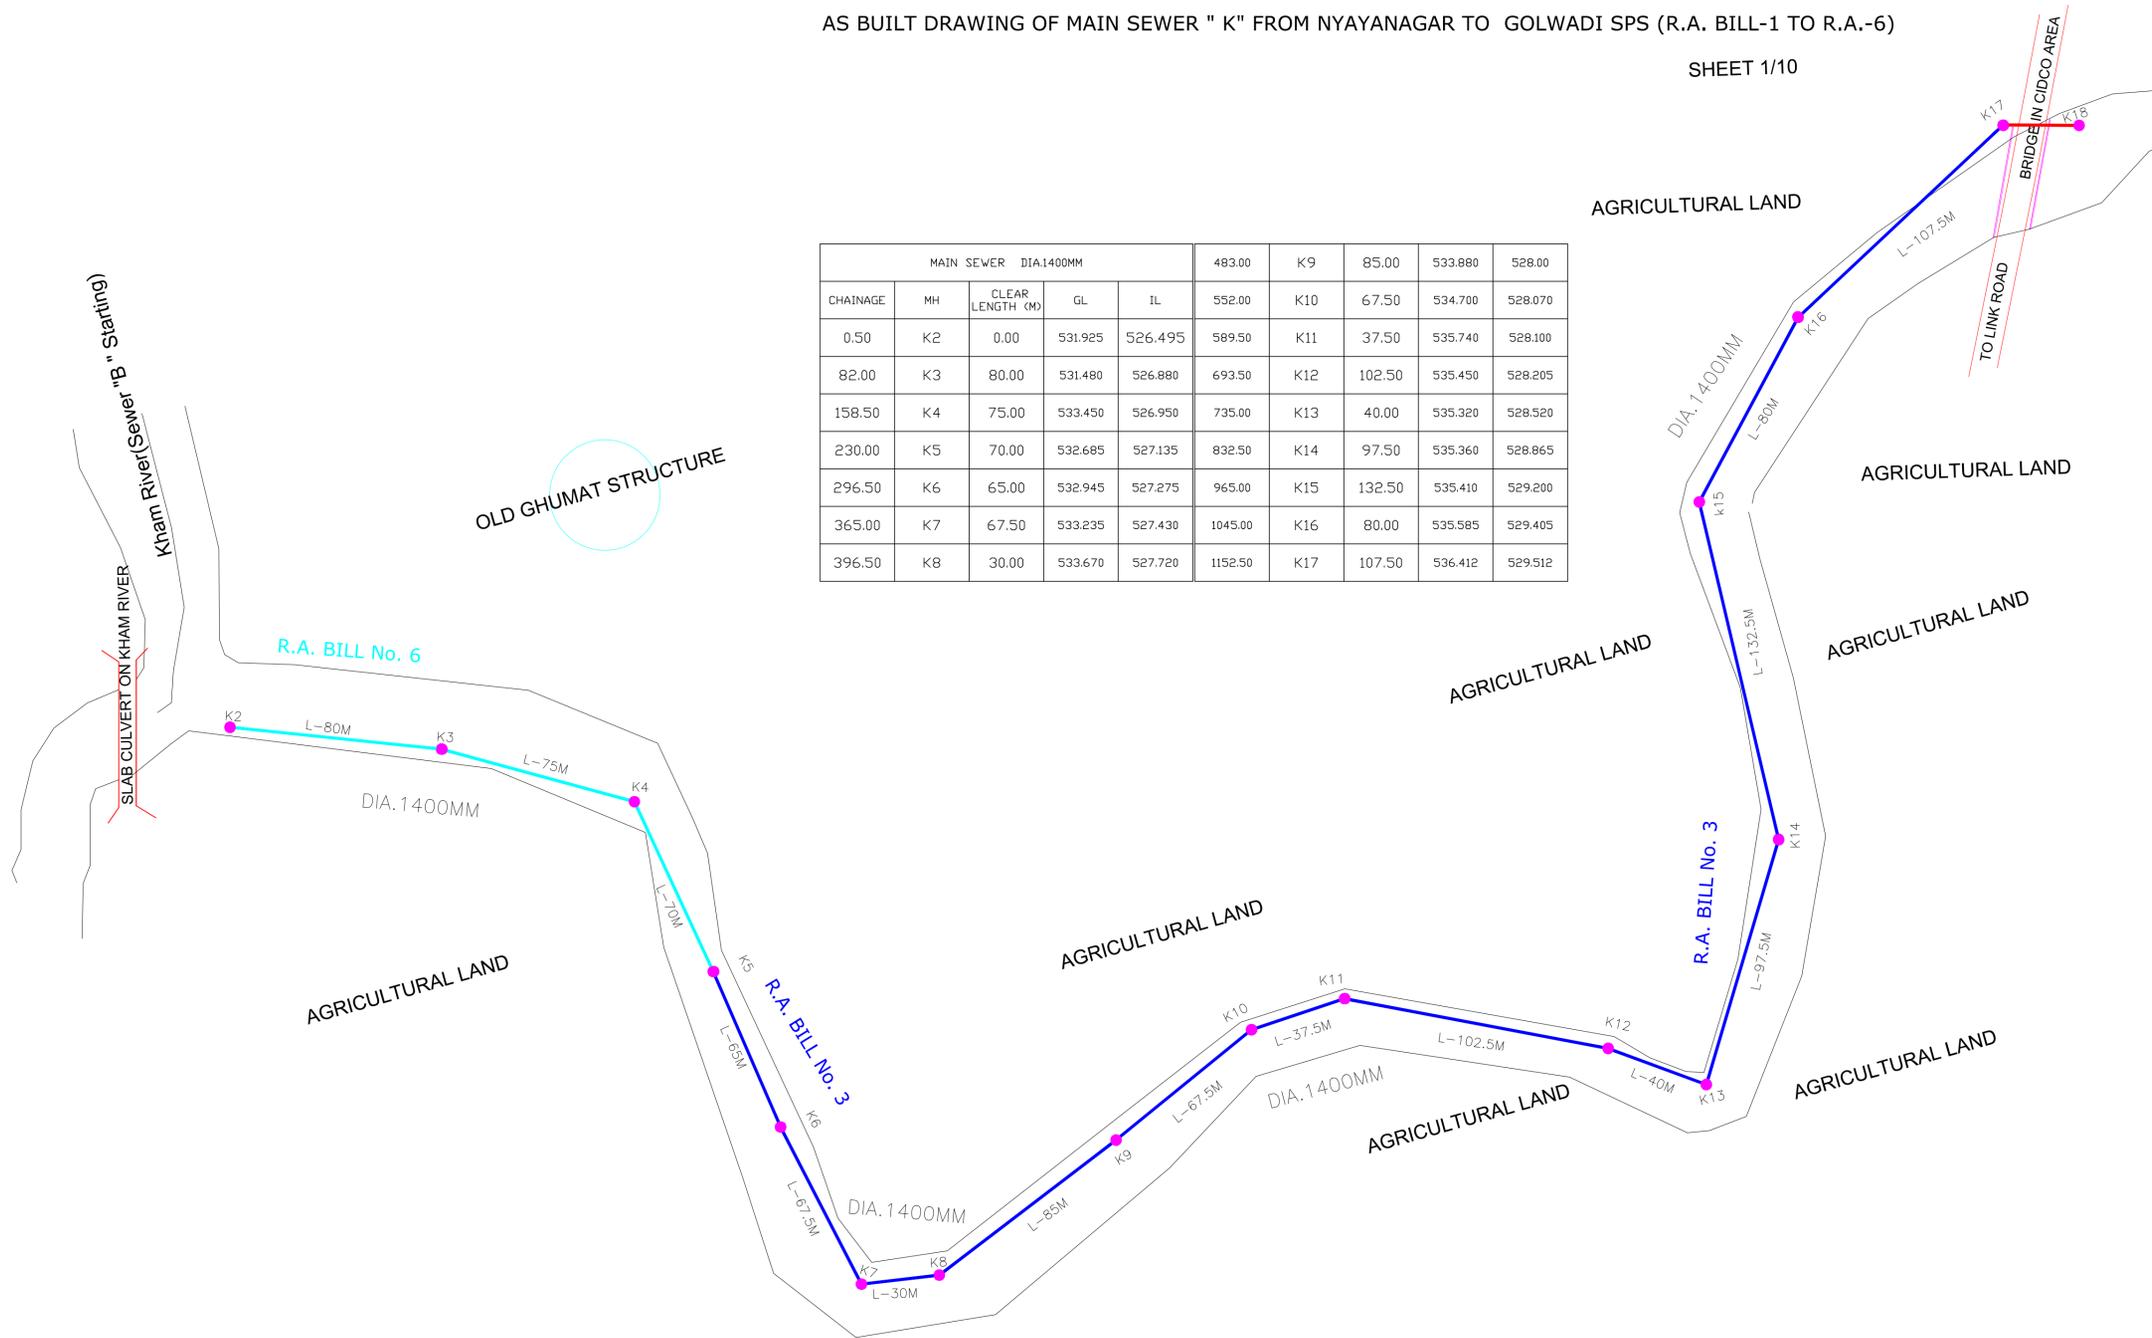

LEGENDS	
	RA BILL- 3
	RA BILL- 6

PROJECT: DEVELOPMENT OF SEWERAGE COLLECTION NETWORK UNDER UIDSSMT FOR AURANGABAD CITY

TITLE: AS BUILT DRAWING OF MAIN SEWER " K "



AURANGABAD MUNICIPAL CORPORATION,
TOWN HALL, AURANGABAD

AGENCY: KHILARI INFRASTRUCTURE PVT. LTD.
101, PRABHAT CENTER, SECT-1A, CBD, BELAPUR,
NAVI MUMBAI-400 614

CONSULTANT: FORTRESS INFRASTRUCTURE
ADVISORY SERVICES, MARINE LINES, MUMBAI-2

SCALE 1:1000

AS BUILT DRAWING OF BRANCH SEWER "K" FROM SUTGIRNI CHOWK TO VIJAY CHOWK RA BILL -5

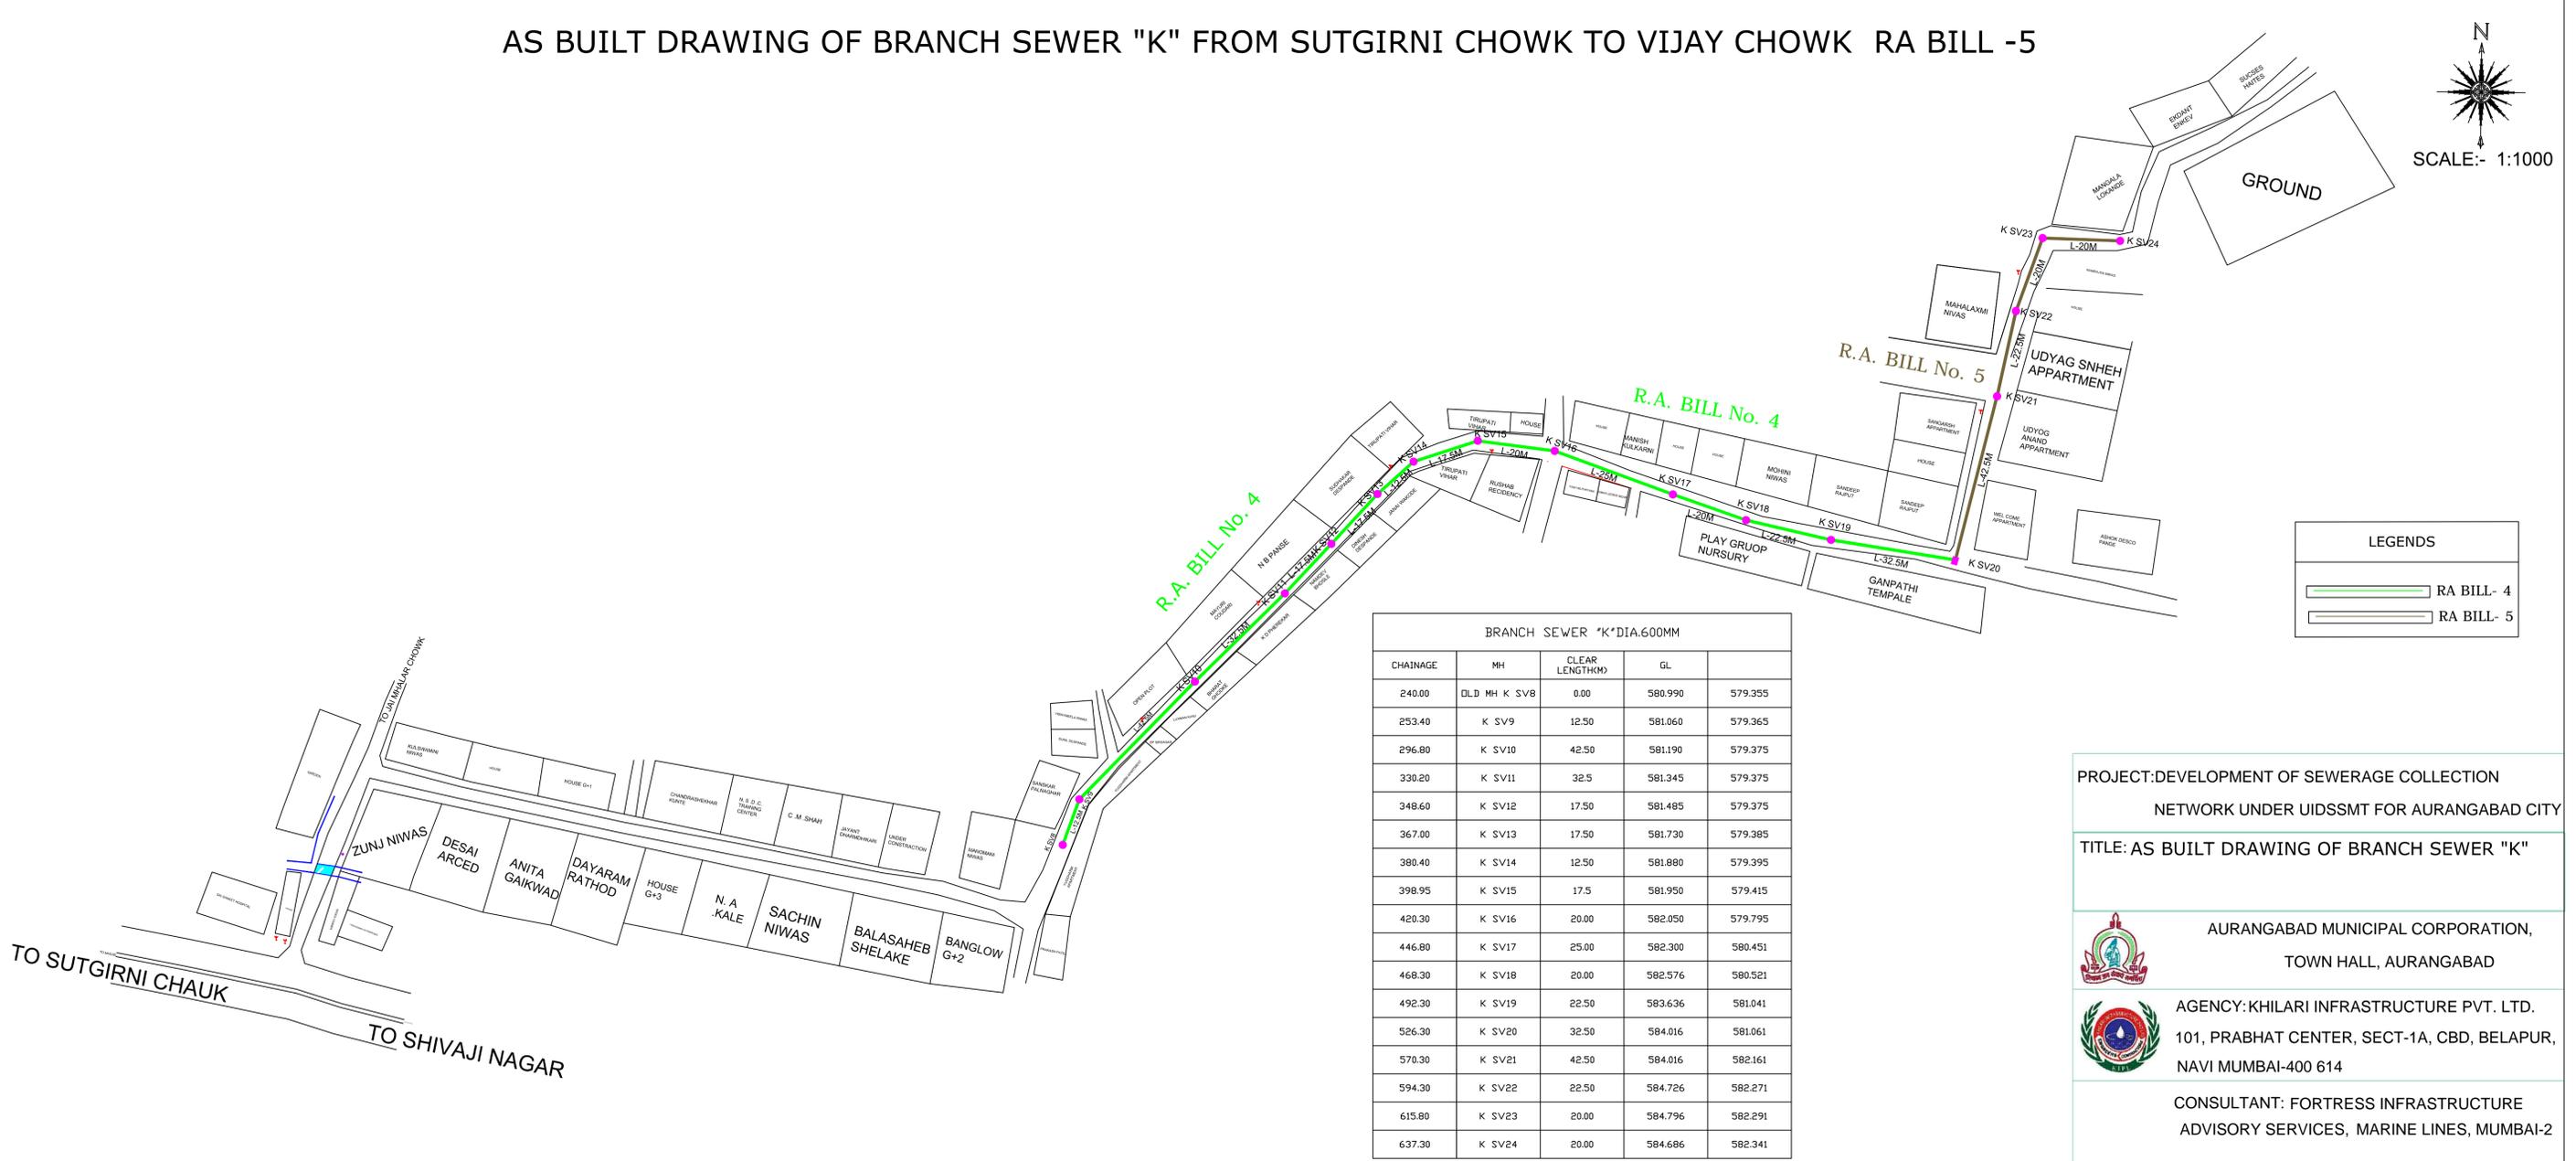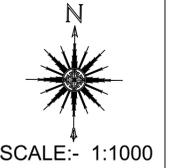

LEGENDS	
—	RA BILL - 4
—	RA BILL - 5

BRANCH SEWER "K" DIA. 600MM				
CHAINAGE	MH	CLEAR LENGTH(M)	GL	
240.00	OLD MH K SV8	0.00	580.990	579.355
253.40	K SV9	12.50	581.060	579.365
296.80	K SV10	42.50	581.190	579.375
330.20	K SV11	32.5	581.345	579.375
348.60	K SV12	17.50	581.485	579.375
367.00	K SV13	17.50	581.730	579.385
380.40	K SV14	12.50	581.880	579.395
398.95	K SV15	17.5	581.950	579.415
420.30	K SV16	20.00	582.050	579.795
446.80	K SV17	25.00	582.300	580.451
468.30	K SV18	20.00	582.576	580.521
492.30	K SV19	22.50	583.636	581.041
526.30	K SV20	32.50	584.016	581.061
570.30	K SV21	42.50	584.016	582.161
594.30	K SV22	22.50	584.726	582.271
615.80	K SV23	20.00	584.796	582.291
637.30	K SV24	20.00	584.686	582.341

PROJECT: DEVELOPMENT OF SEWERAGE COLLECTION NETWORK UNDER UIDSSMT FOR AURANGABAD CITY


TITLE: AS BUILT DRAWING OF BRANCH SEWER "K"

 AURANGABAD MUNICIPAL CORPORATION,
TOWN HALL, AURANGABAD

 AGENCY: KHILARI INFRASTRUCTURE PVT. LTD.
101, PRABHAT CENTER, SECT-1A, CBD, BELAPUR,
NAVI MUMBAI-400 614

CONSULTANT: FORTRESS INFRASTRUCTURE ADVISORY SERVICES, MARINE LINES, MUMBAI-2

AS BUILT DRAWING OF MAIN SEWER " K " GOLWADI RA BILL -6

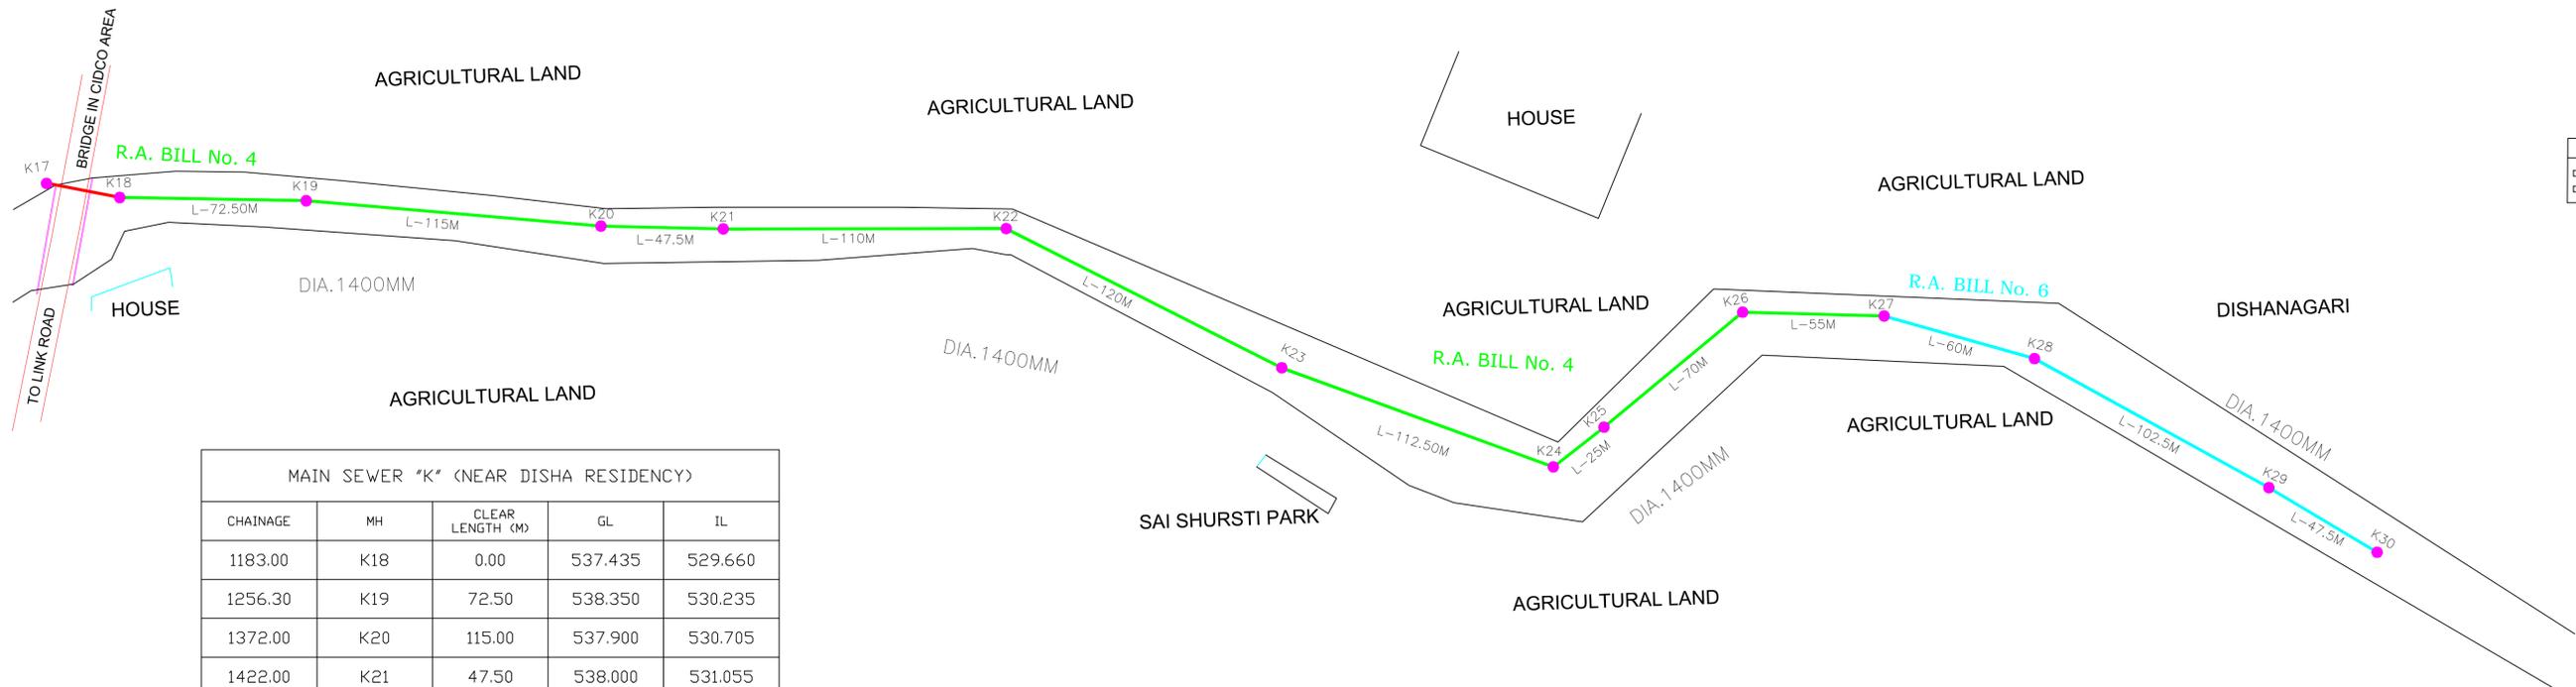

MAIN SEWER "K" (NEAR DISHA RESIDENCY)				
CHAINAGE	MH	CLEAR LENGTH (M)	GL	IL
1183.00	K18	0.00	537.435	529.660
1256.30	K19	72.50	538.350	530.235
1372.00	K20	115.00	537.900	530.705
1422.00	K21	47.50	538.000	531.055
1533.00	K22	110.00	538.850	531.175
1655.20	K23	120.00	539.720	531.395
1769.30	K24	112.50	539.730	531.510
1795.90	K25	25.00	538.735	531.555
1867.50	K26	70.00	538.910	531.825
1924.10	K27	55.00	538.710	531.850
1931.70	K27	0.00	538.710	531.850
1993.20	K28	60.00	539.210	532.360
2097.20	K29	102.50	538.170	532.470
2146.20	K30	47.50	539.975	532.875


PROJECT: DEVELOPMENT OF SEWERAGE COLLECTION NETWORK UNDER UIDSSMT FOR AURANGABAD CITY
 TITLE: AS BUILT DRAWING OF MAIN SEWER " K "

AURANGABAD MUNICIPAL CORPORATION,
 TOWN HALL, AURANGABAD

AGENCY: KHILARI INFRASTRUCTURE PVT. LTD.
 101, PRABHAT CENTER, SECT-1A, CBD, BELAPUR,
 NAVI MUMBAI-400 614

CONSULTANT: FORTRESS INFRASTRUCTURE
 ADVISORY SERVICES, MARINE LINES, MUMBAI-2

SCALE 1:1000


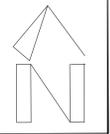


LEGENDS	
—	RA BILL- 4
—	RA BILL- 6

AS BUILT DRAWING OF MAIN SEWER " K" BACKSIDE BEST PRICE MALL RA BILL -3

LEGENDS

 RA BILL- 3

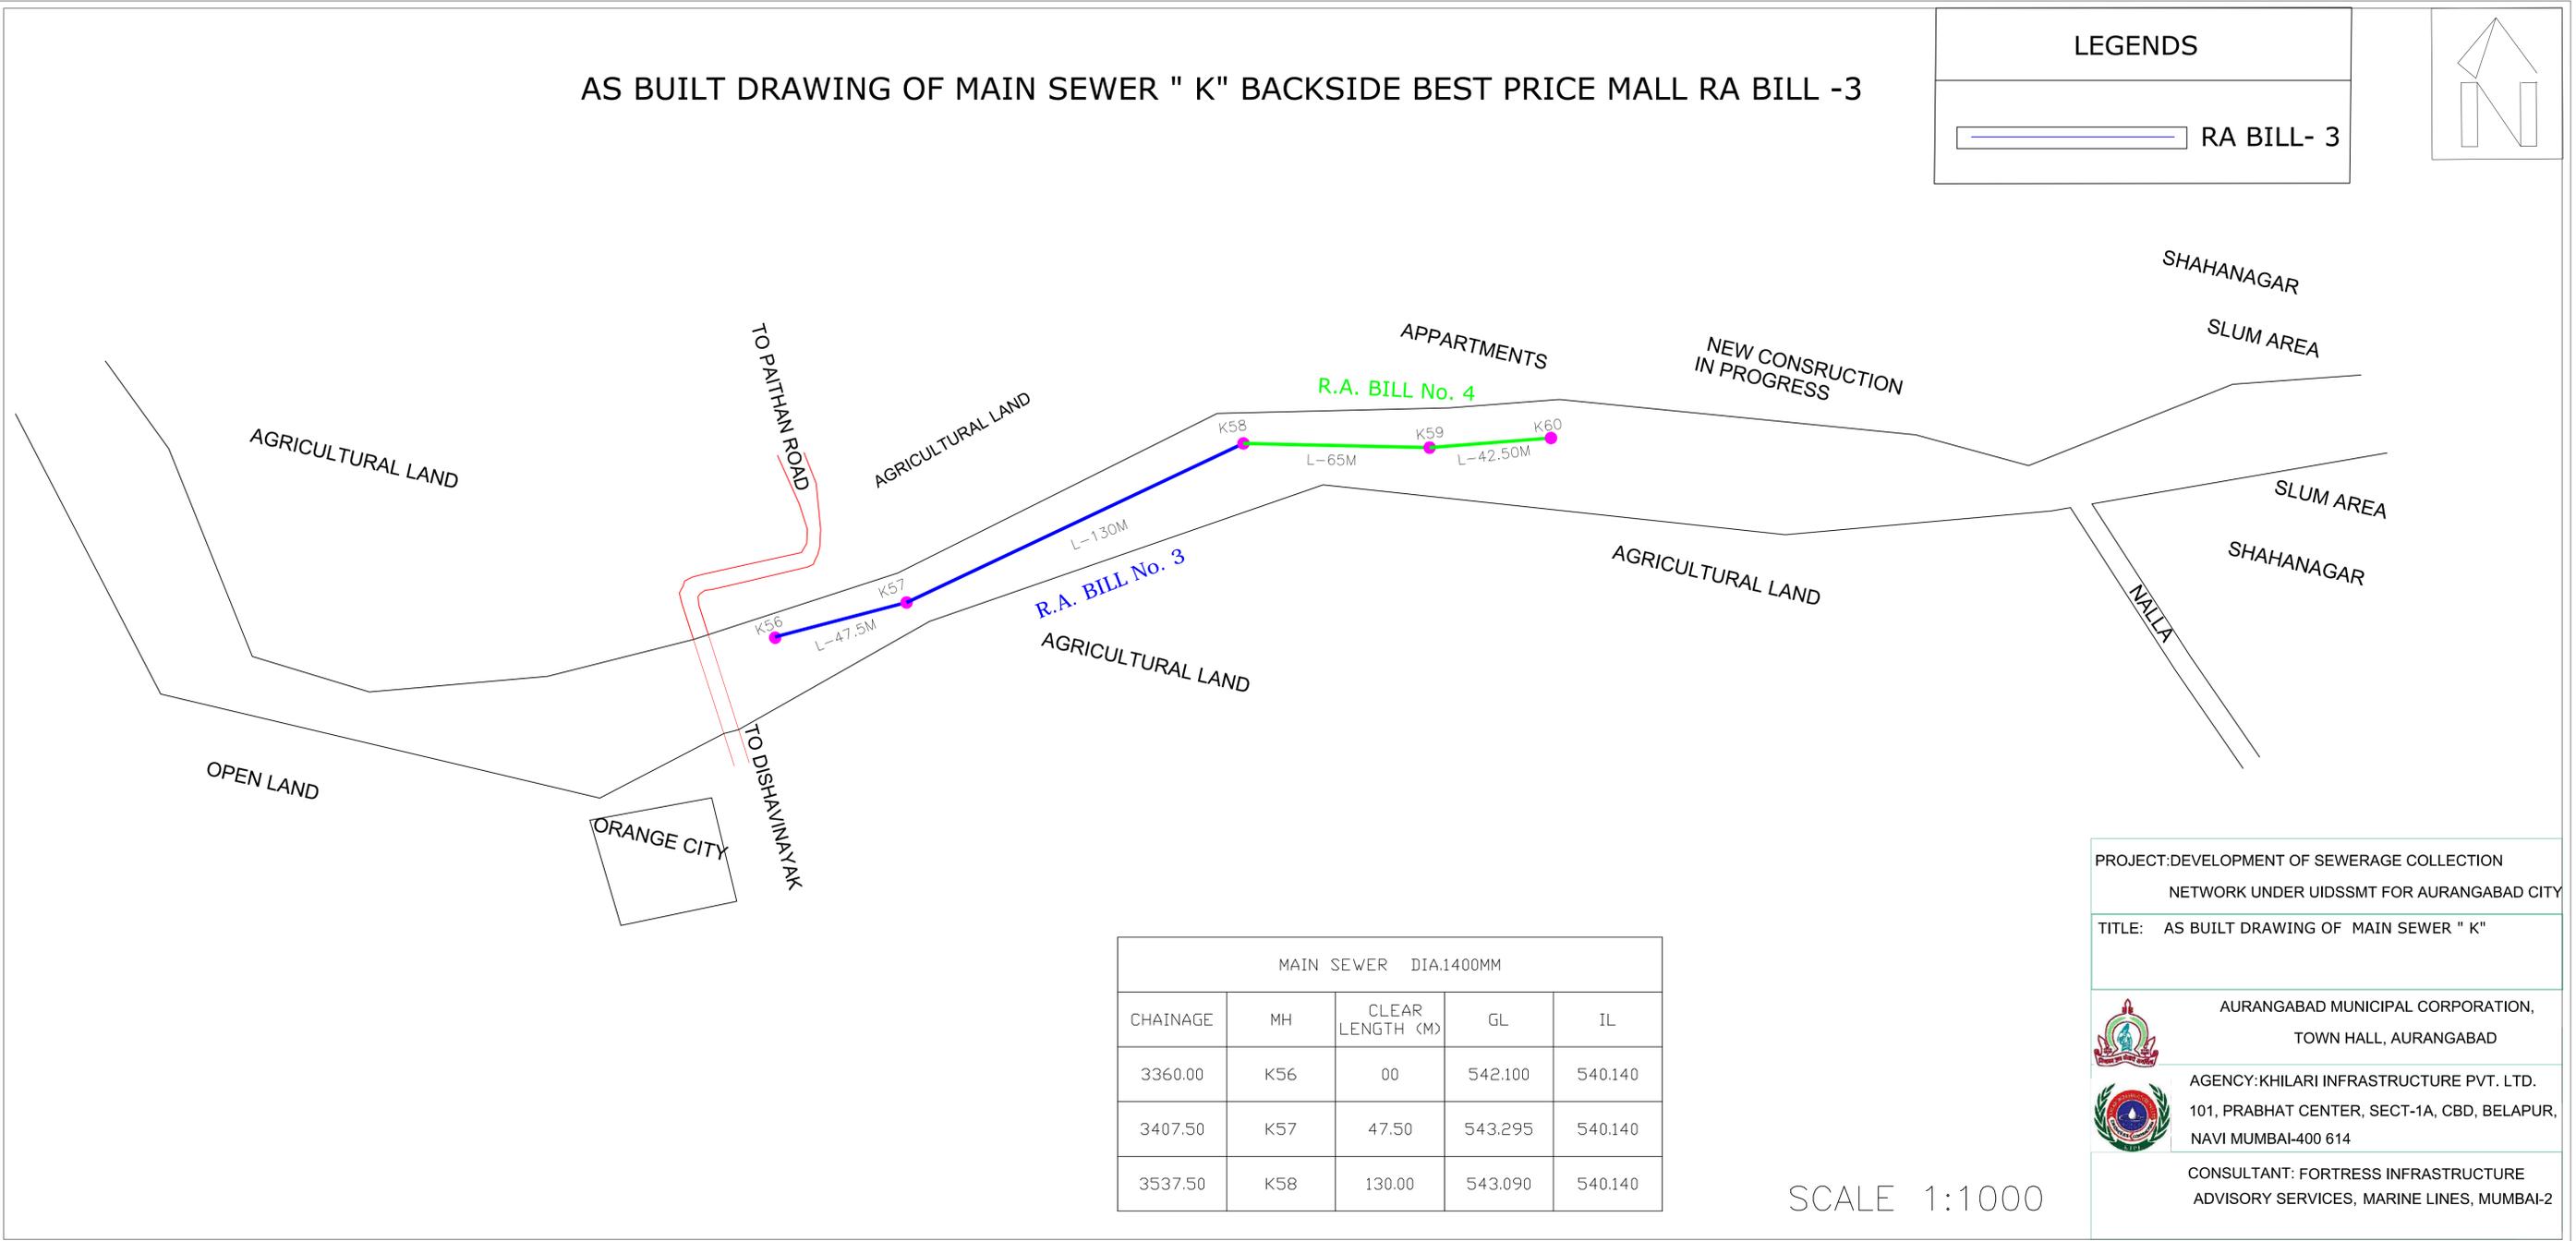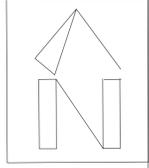

MAIN SEWER DIA.1400MM				
CHAINAGE	MH	CLEAR LENGTH (M)	GL	IL
3360.00	K56	00	542.100	540.140
3407.50	K57	47.50	543.295	540.140
3537.50	K58	130.00	543.090	540.140

SCALE 1:1000

PROJECT:DEVELOPMENT OF SEWERAGE COLLECTION NETWORK UNDER UIDSSMT FOR AURANGABAD CITY


TITLE: AS BUILT DRAWING OF MAIN SEWER " K"

 AURANGABAD MUNICIPAL CORPORATION, TOWN HALL, AURANGABAD

 AGENCY:KHILARI INFRASTRUCTURE PVT. LTD. 101, PRABHAT CENTER, SECT-1A, CBD, BELAPUR, NAVI MUMBAI-400 614

CONSULTANT: FORTRESS INFRASTRUCTURE ADVISORY SERVICES, MARINE LINES, MUMBAI-2

AS BUILT DRAWING OF MAIN SEWER " K " GOLWADI RA BILL -6

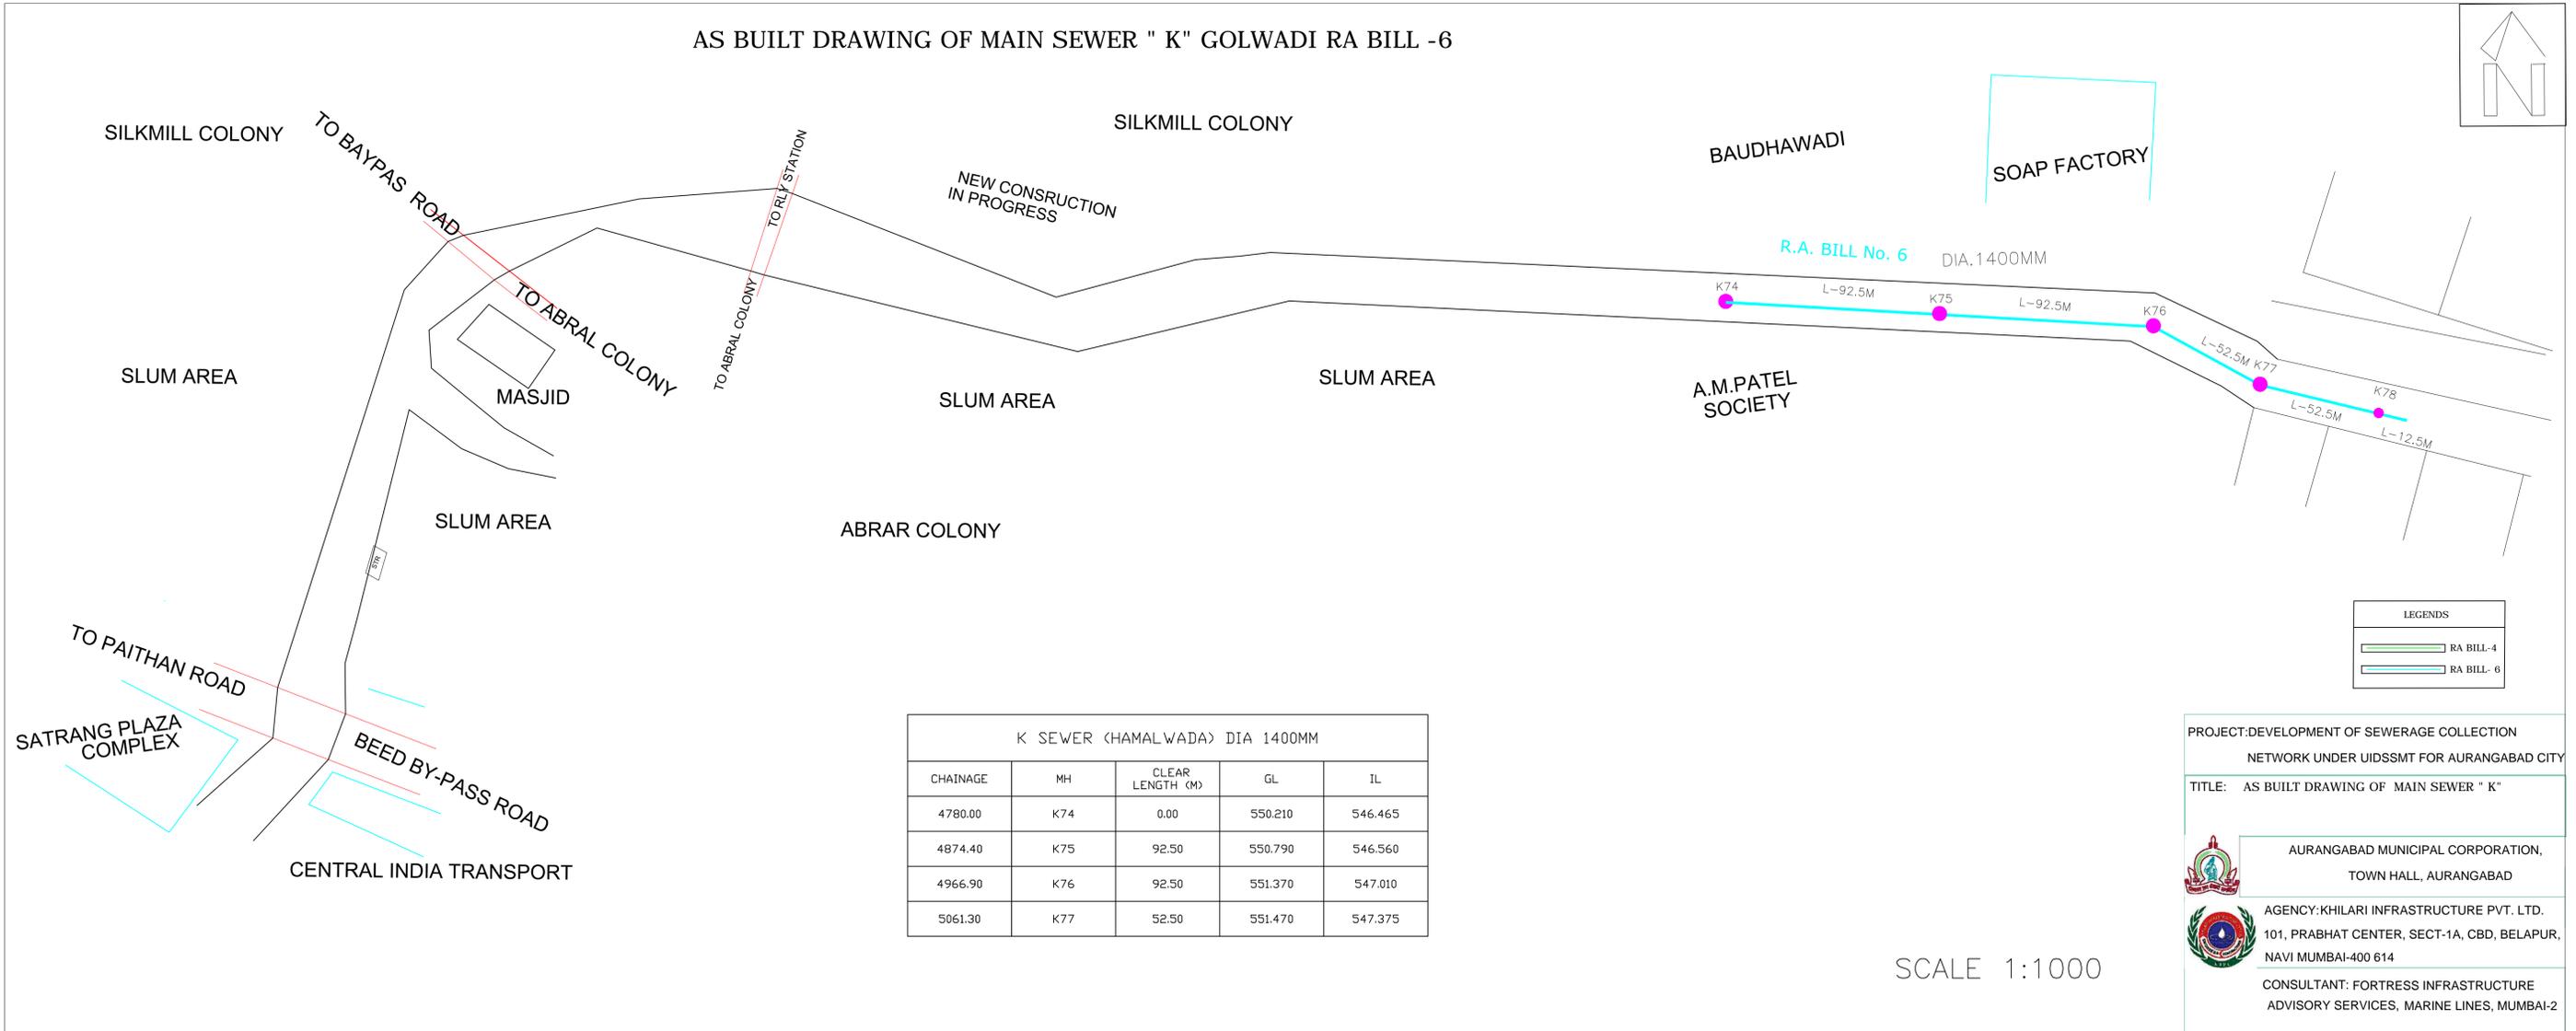

PROJECT: DEVELOPMENT OF SEWERAGE COLLECTION NETWORK UNDER UIDSSMT FOR AURANGABAD CITY

TITLE: AS BUILT DRAWING OF MAIN SEWER " K "



AURANGABAD MUNICIPAL CORPORATION,
TOWN HALL, AURANGABAD

AGENCY: KHILARI INFRASTRUCTURE PVT. LTD.
101, PRABHAT CENTER, SECT-1A, CBD, BELAPUR,
NAVI MUMBAI-400 614

CONSULTANT: FORTRESS INFRASTRUCTURE
ADVISORY SERVICES, MARINE LINES, MUMBAI-2

SCALE 1:1000

AS BUILT DRAWING OF MAIN SEWER " K" MIT COLLEGE TO SHANOORMIYA DARGA RA BILL-3 TO RA BILL-5

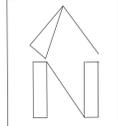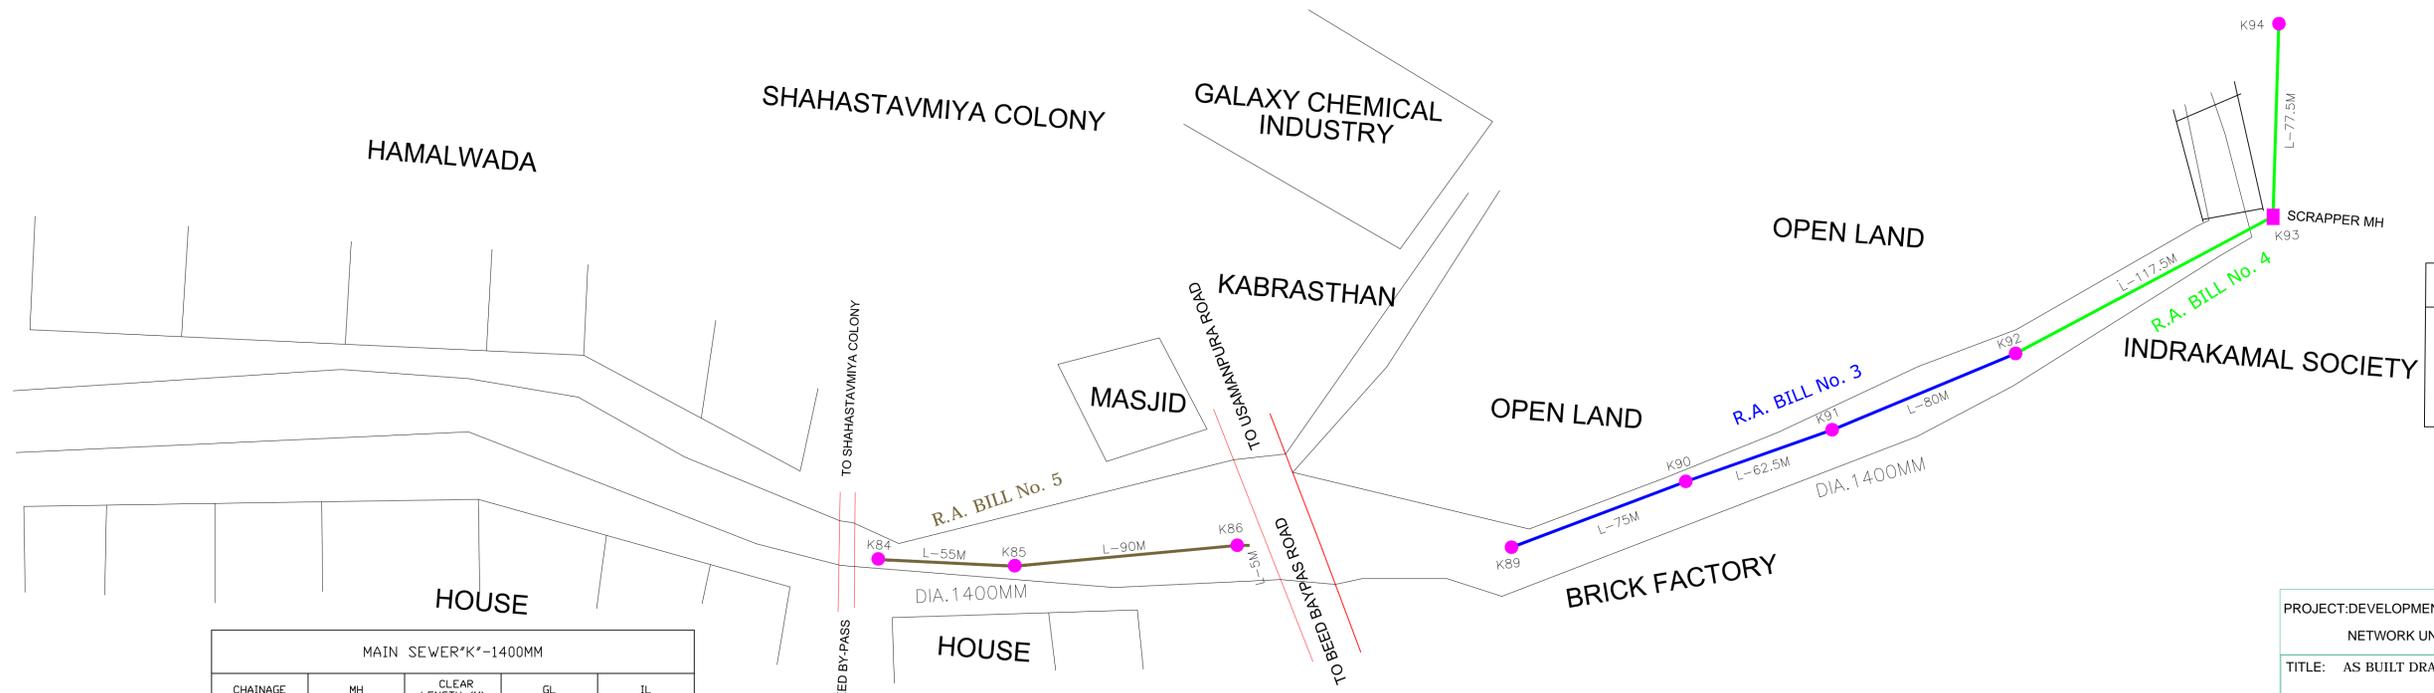

LEGENDS	
—	RA BILL- 3
—	RA BILL- 4
—	RA BILL- 5

MAIN SEWER "K" -1400MM				
CHAINAGE	MH	CLEAR LENGTH (M)	GL	IL
5400.00	K84	0.00	552.210	548.440
5457.50	K85	55.00	552.590	548.950
5550.00	K86	90.00	552.750	549.150
5556.25	K87	5.00	552.825	549.165
5845.80	K92	0.00	554.610	550.787
5965.15	K93	117.50	555.180	551.960
6043.25	K94	77.50	555.125	552.020

MAIN SEWER K DIA.1400MM				
CHAINAGE	MH	CLEAR LENGTH (M)	GL	IL
5625.00	K89	0.00	554.590	550.090
5700.00	K90	75	554.630	550.125
5763.60	K91	62.5	555.085	550.700
5845.80	K92	80	554.610	550.787


PROJECT: DEVELOPMENT OF SEWERAGE COLLECTION NETWORK UNDER UIDSSMT FOR AURANGABAD CITY
 TITLE: AS BUILT DRAWING OF MAIN SEWER " K"


AURANGABAD MUNICIPAL CORPORATION,
 TOWN HALL, AURANGABAD


AGENCY: KHILARI INFRASTRUCTURE PVT. LTD.
 101, PRABHAT CENTER, SECT-1A, CBD, BELAPUR,
 NAVI MUMBAI-400 614

CONSULTANT: FORTRESS INFRASTRUCTURE
 ADVISORY SERVICES, MARINE LINES, MUMBAI-2

AS BUILT DRAWING OF MAIN SEWER " K" MIT COLLEGE TO SHANOORMIYA DARGA RA BILL-4

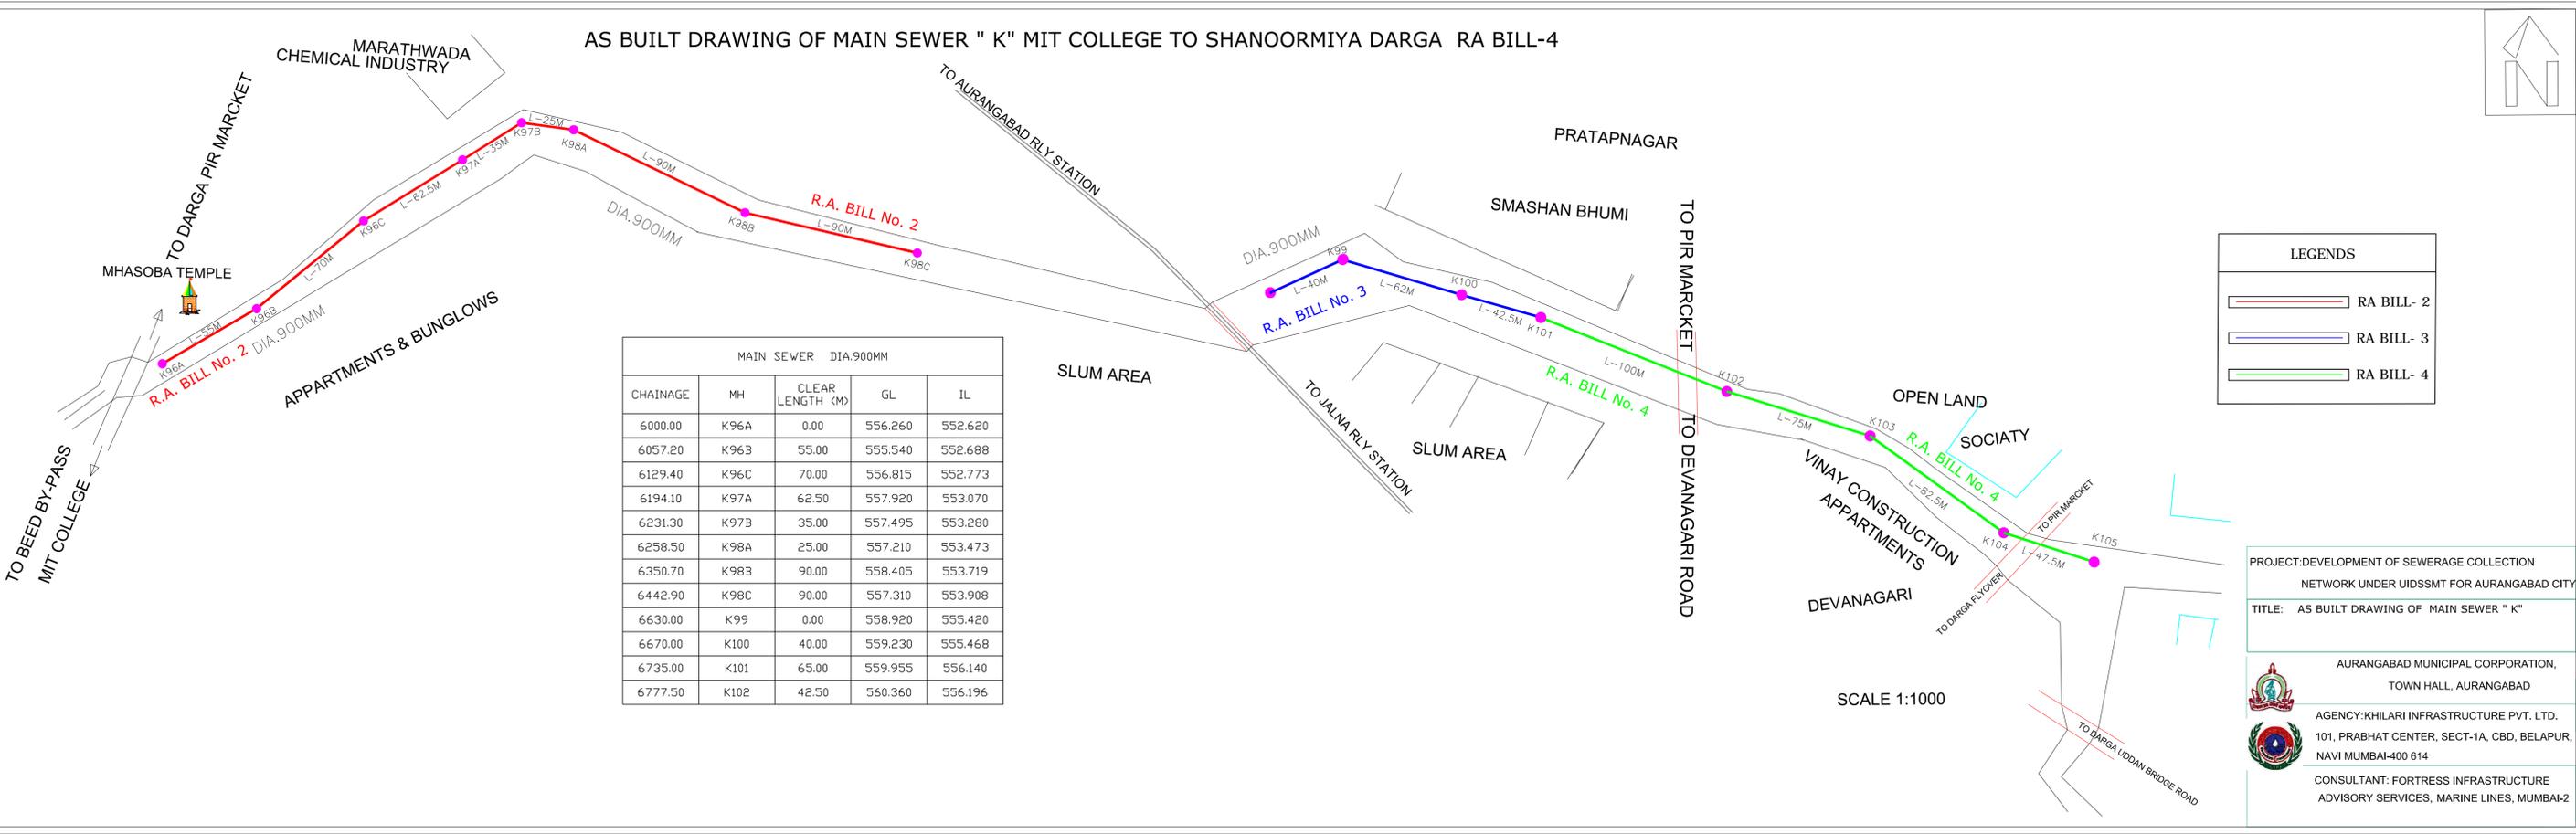

MAIN SEWER DIA.900MM				
CHAINAGE	MH	CLEAR LENGTH (M)	GL	IL
6000.00	K96A	0.00	556.260	552.620
6057.20	K96B	55.00	555.540	552.688
6129.40	K96C	70.00	556.815	552.773
6194.10	K97A	62.50	557.920	553.070
6231.30	K97B	35.00	557.495	553.280
6258.50	K98A	25.00	557.210	553.473
6350.70	K98B	90.00	558.405	553.719
6442.90	K98C	90.00	557.310	553.908
6630.00	K99	0.00	558.920	555.420
6670.00	K100	40.00	559.230	555.468
6735.00	K101	65.00	559.955	556.140
6777.50	K102	42.50	560.360	556.196


LEGENDS

- RA BILL- 2
- RA BILL- 3
- RA BILL- 4


PROJECT: DEVELOPMENT OF SEWERAGE COLLECTION NETWORK UNDER UIDSSMT FOR AURANGABAD CITY
 TITLE: AS BUILT DRAWING OF MAIN SEWER " K"

AURANGABAD MUNICIPAL CORPORATION,
 TOWN HALL, AURANGABAD
 AGENCY: KHILARI INFRASTRUCTURE PVT. LTD.
 101, PRABHAT CENTER, SECT-1A, CBD, BELAPUR,
 NAVI MUMBAI-400 614
 CONSULTANT: FORTRESS INFRASTRUCTURE ADVISORY SERVICES, MARINE LINES, MUMBAI-2

SCALE 1:1000

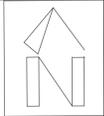

AS BUILT DRAWING OF MAIN SEWER " K" MIT COLLEGE TO SHANOORMIYA DARGA RA BILL-1 TO RA BILL -4

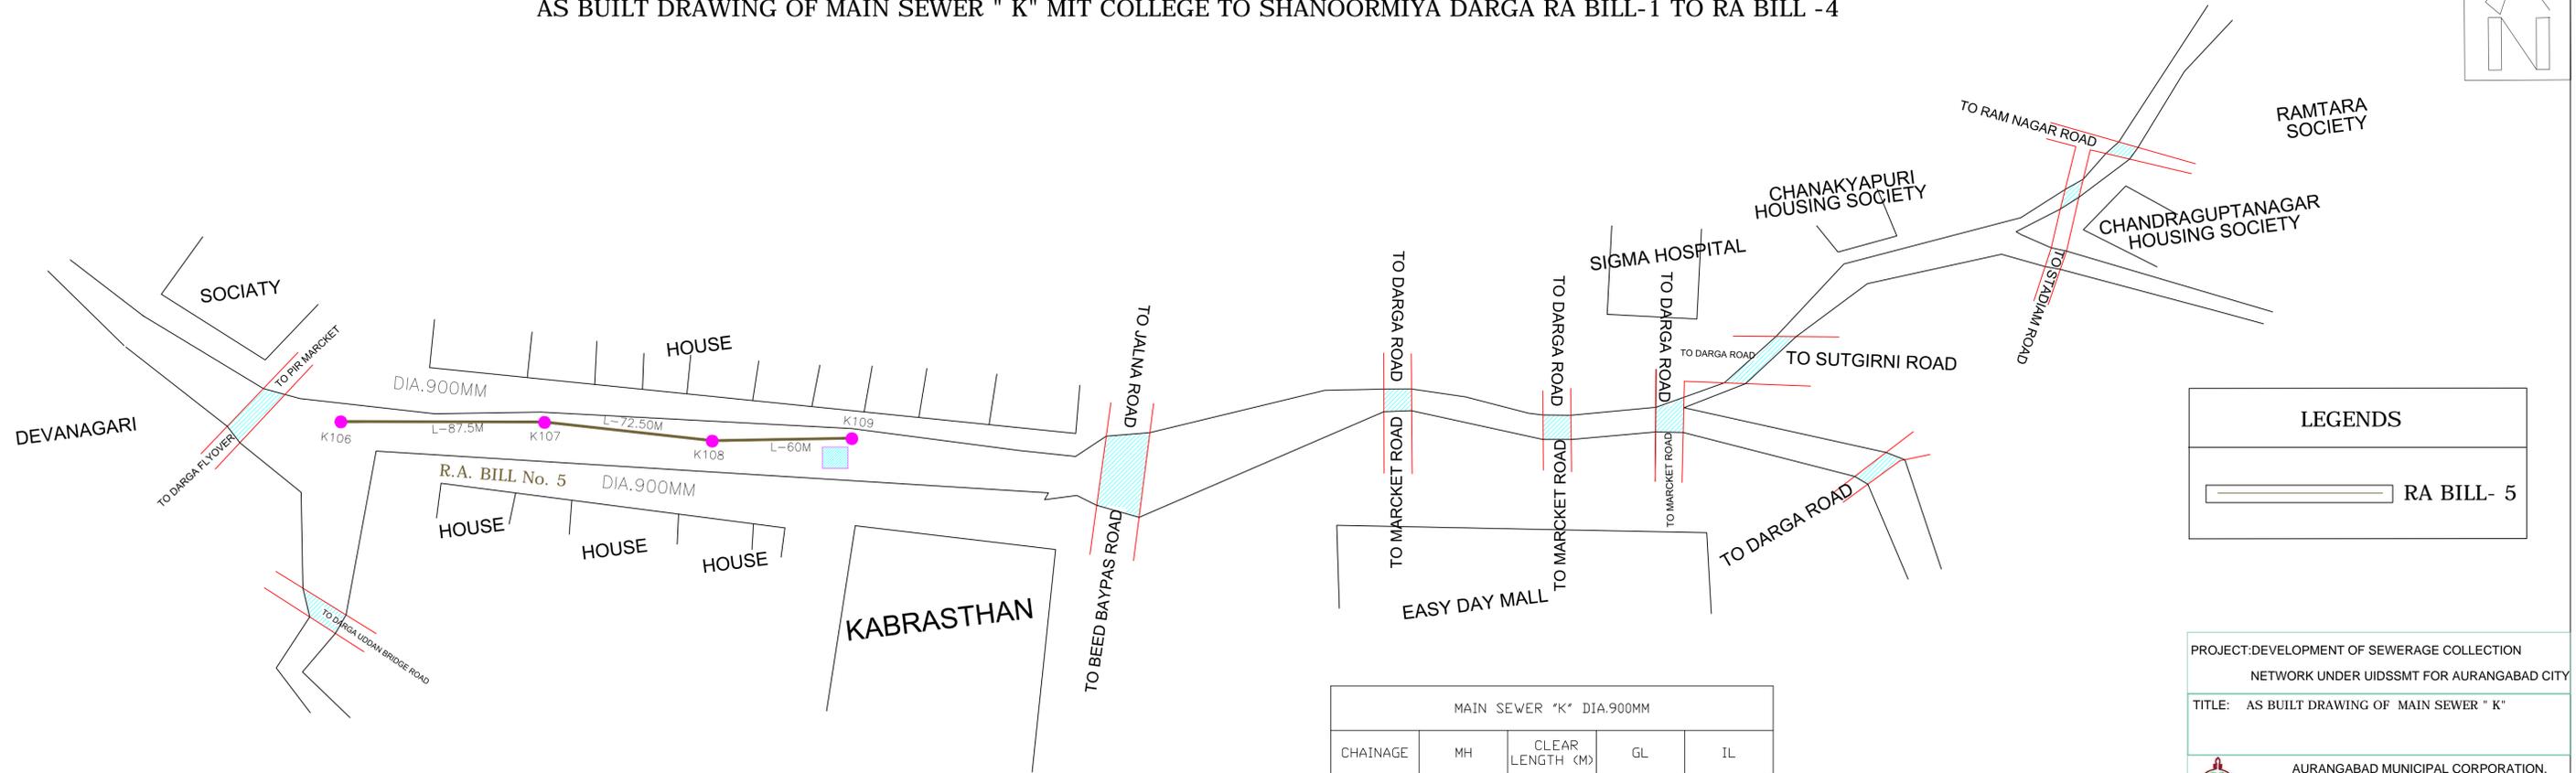

LEGENDS

— RA BILL- 5

MAIN SEWER "K" DIA.900MM				
CHAINAGE	MH	CLEAR LENGTH (M)	GL	IL
7091.30	K106	00.00	562.670	558.815
7181.00	K107	87.50	562.400	559.175
7255.70	K108	72.50	562.180	559.700
7317.90	K109	60.00	563.280	559.895

PROJECT: DEVELOPMENT OF SEWERAGE COLLECTION NETWORK UNDER UIDSSMT FOR AURANGABAD CITY

TITLE: AS BUILT DRAWING OF MAIN SEWER " K"



 AURANGABAD MUNICIPAL CORPORATION, TOWN HALL, AURANGABAD

 AGENCY: KHILARI INFRASTRUCTURE PVT. LTD. 101, PRABHAT CENTER, SECT-1A, CBD, BELAPUR, NAVI MUMBAI-400 614

CONSULTANT: FORTRESS INFRASTRUCTURE ADVISORY SERVICES, MARINE LINES, MUMBAI-2

SCALE 1:1000

AS BUILT DRAWING OF BRANCH SEWER " K" FROM EASYDAY MALL TO SHIVAJI NAGAR RA BILL -6

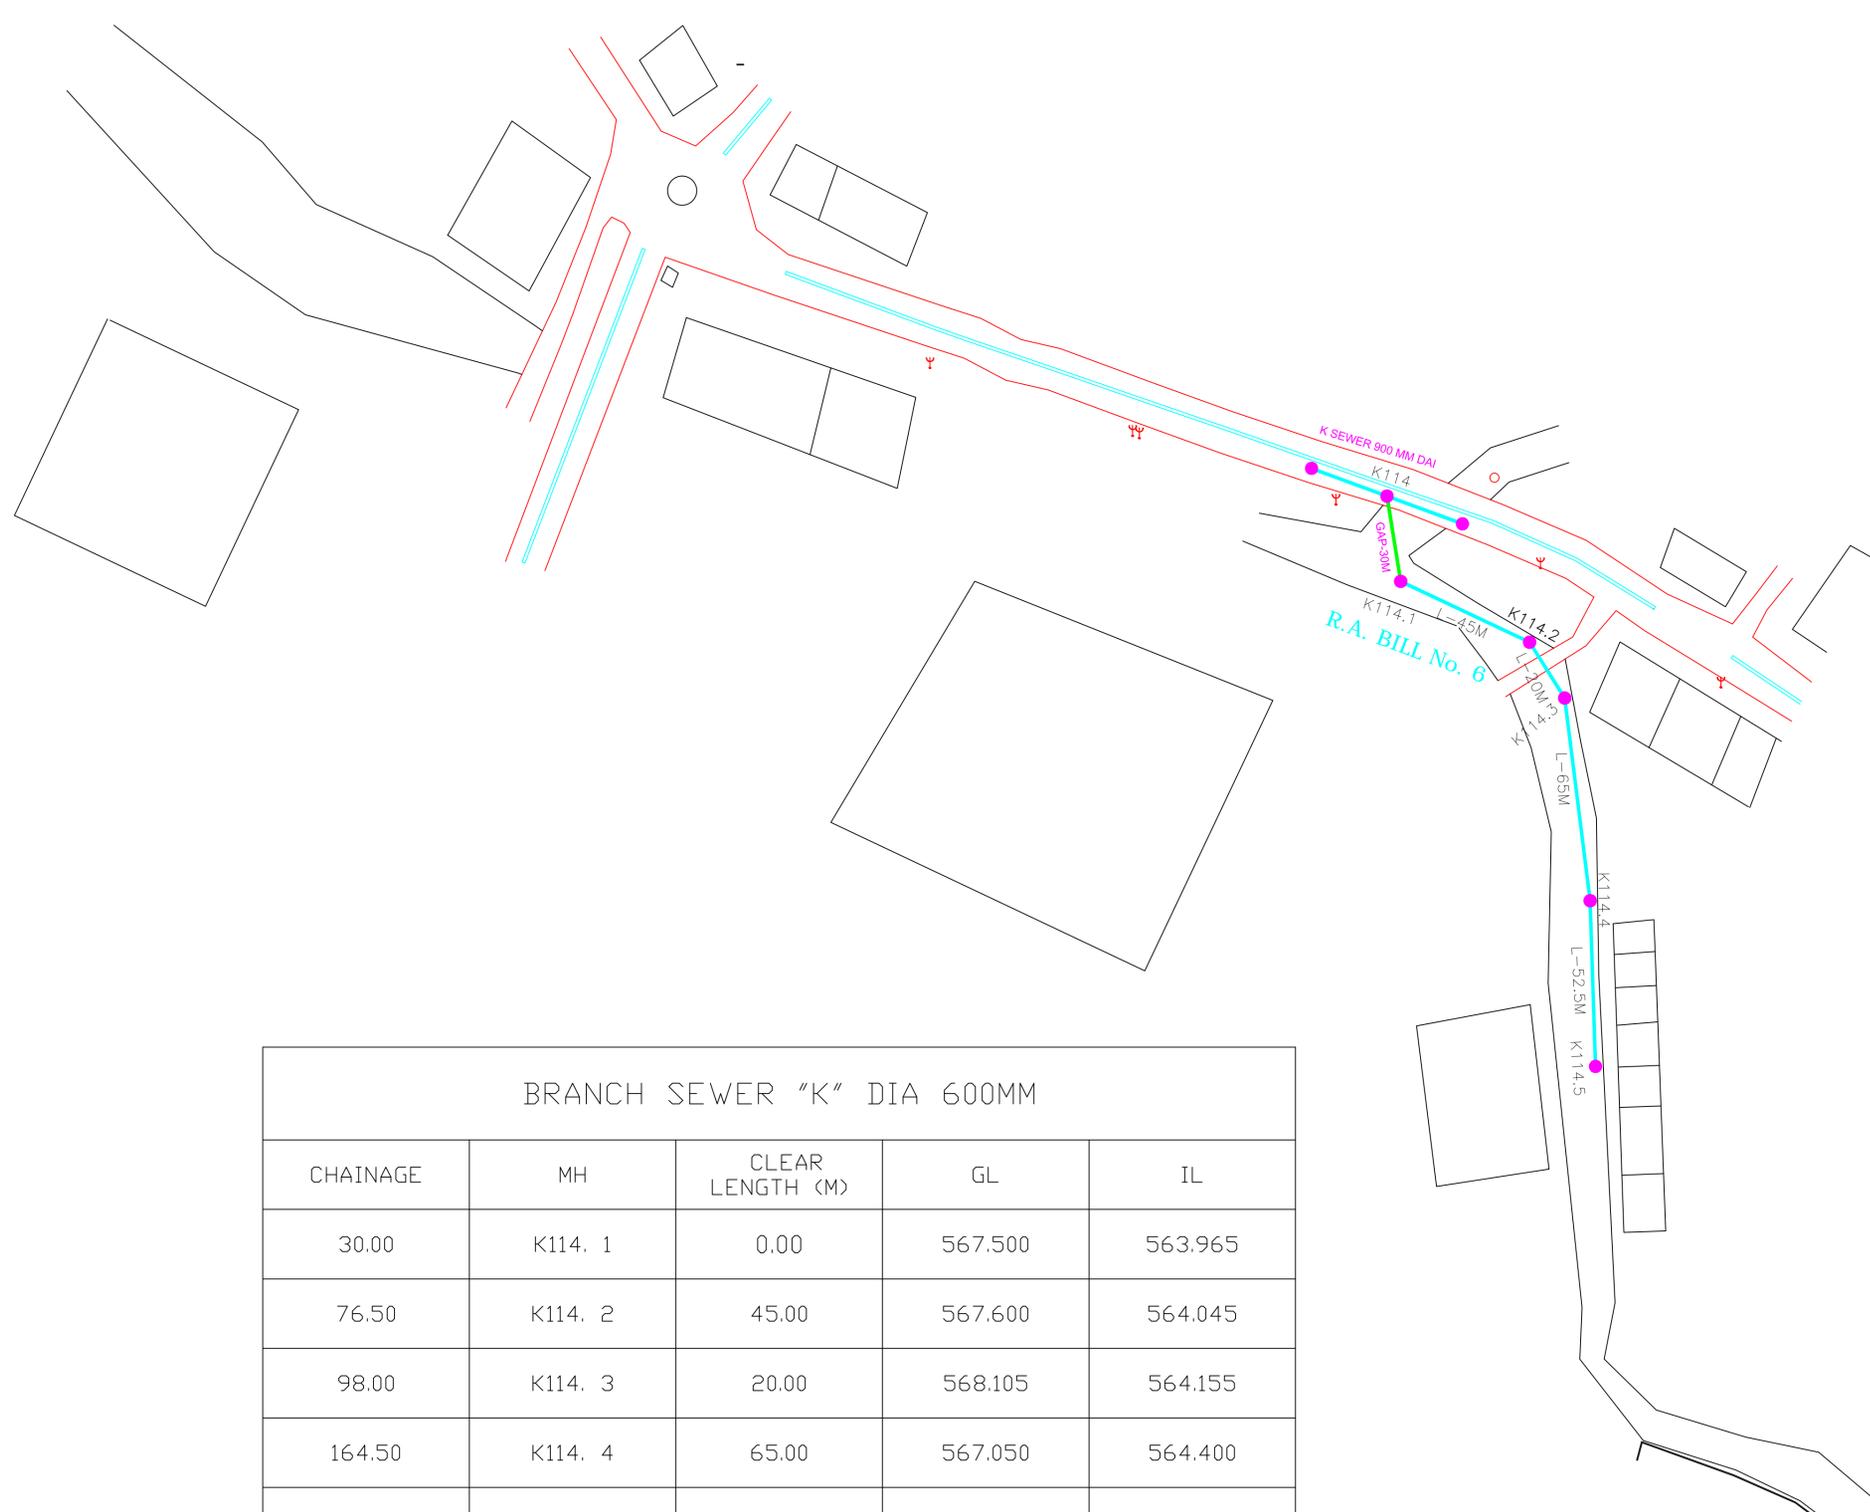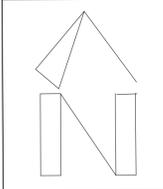

LEGENDS	
	RA BILL- 6

BRANCH SEWER "K" DIA 600MM				
CHAINAGE	MH	CLEAR LENGTH (M)	GL	IL
30.00	K114. 1	0.00	567.500	563.965
76.50	K114. 2	45.00	567.600	564.045
98.00	K114. 3	20.00	568.105	564.155
164.50	K114. 4	65.00	567.050	564.400
218.50	K114.5	52.50	567.790	564.575

SCALE 1:1000

PROJECT:DEVELOPMENT OF SEWERAGE COLLECTION NETWORK UNDER UIDSSMT FOR AURANGABAD CITY

TITLE: AS BUILT DRAWING OF BRANCH SEWER " K"





AURANGABAD MUNICIPAL CORPORATION,
TOWN HALL, AURANGABAD



AGENCY:KHILARI INFRASTRUCTURE PVT. LTD.
101, PRABHAT CENTER, SECT-1A, CBD, BELAPUR,
NAVI MUMBAI-400 614

CONSULTANT: FORTRESS INFRASTRUCTURE
ADVISORY SERVICES, MARINE LINES, MUMBAI-2

AS BUILT DRAWING OF BRANCH SEWER "K" DURGA CHOWK TO SUTGIRNI CHOWK RA BILL -6

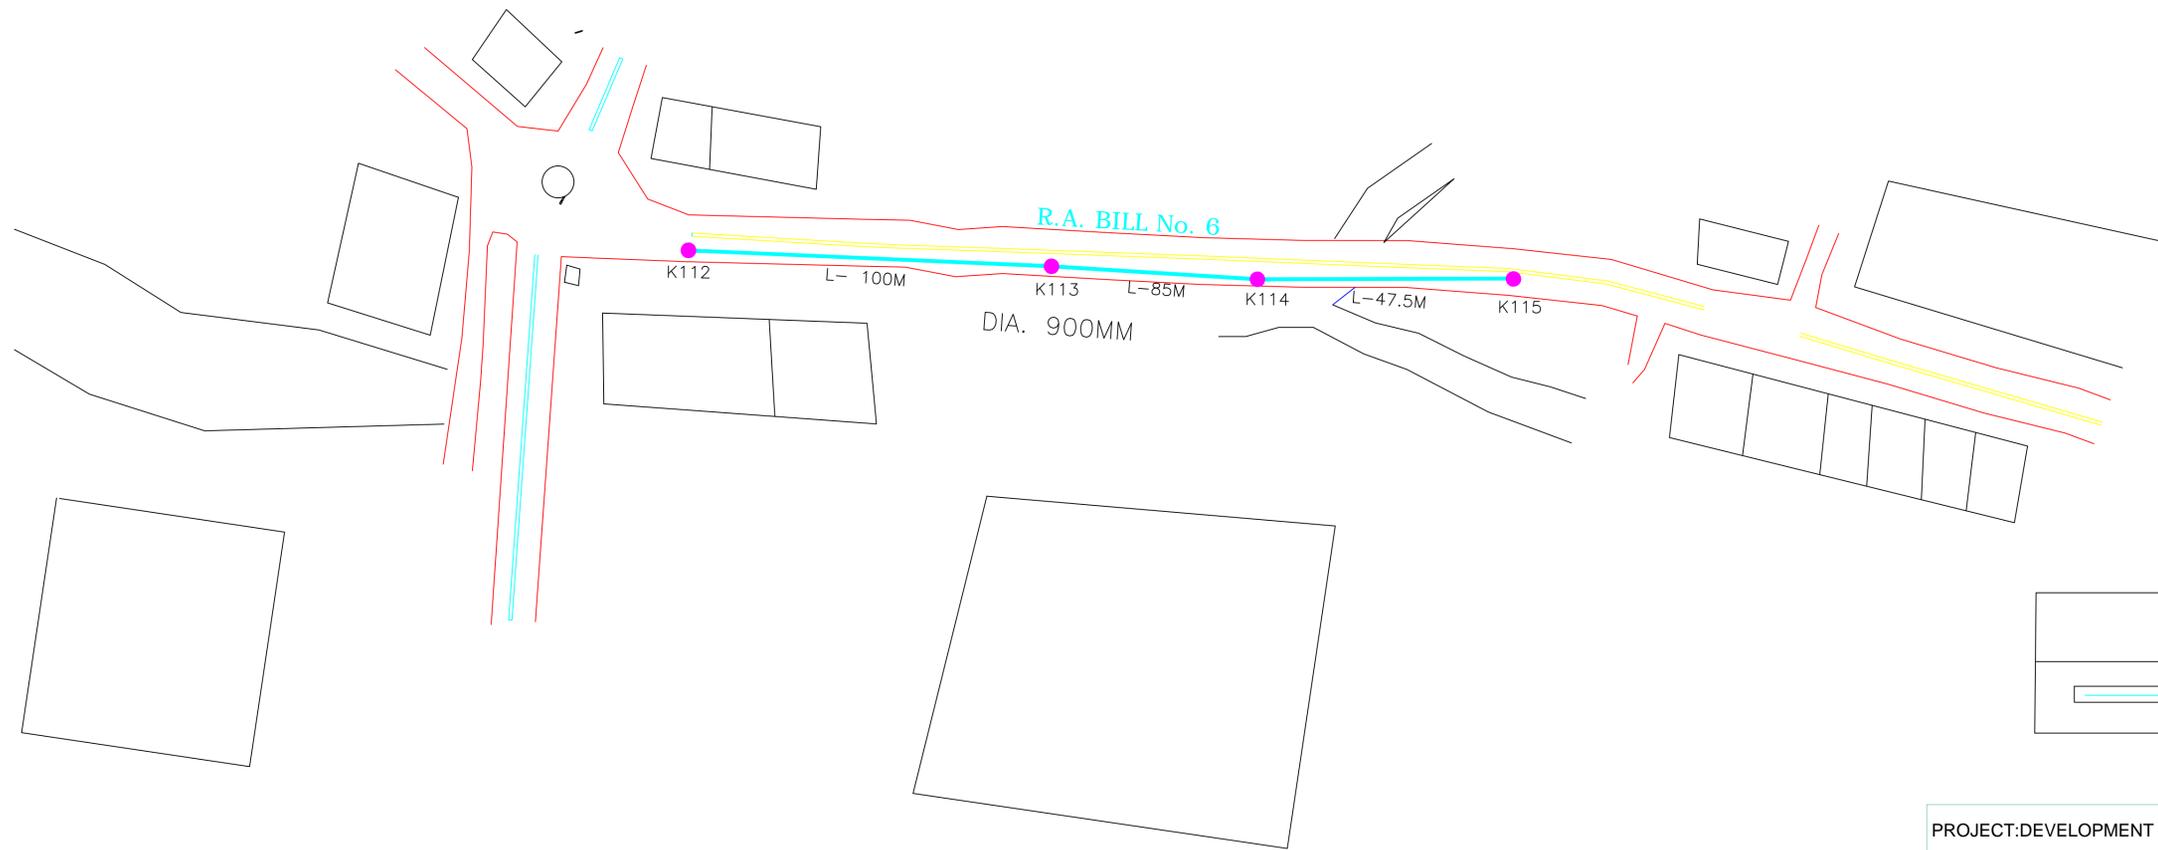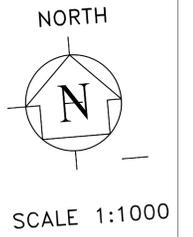

LEGENDS	
	RA BILL -6

K SEWER (DURGA CHAUK TO SUTGIRNI CHAUK) DIA 900MM				
CHAINAGE	MH	CLEAR LENGTH (M)	GL	IL
7517.90	K112	0.00	567.790	562.515
7619.70	K113	100.00	568.040	562.745
7681.50	K114	85.00	568.475	563.150
7756.70	K115	47.50	569.160	563.435

PROJECT: DEVELOPMENT OF SEWERAGE COLLECTION NETWORK UNDER UIDSSMT FOR AURANGABAD CITY

TITLE: LONGITUDINAL SECTION OF BRANCH SEWER "K"



AURANGABAD MUNICIPAL CORPORATION,
TOWN HALL, AURANGABAD


AGENCY: PHILARI INFRASTRUCTURE PVT. LTD.
101, PRABHAT CENTER, SECT-1A, CBD, BELAPUR,
NAVI MUMBAI-400 614

CONSULTANT: FORTRESS INFRASTRUCTURE ADVISORY SERVICES, MARINE LINES, MUMBAI-2

PRODUCED BY AN AUTODESK EDUCATIONAL PRODUCT

PRODUCED BY AN AUTODESK EDUCATIONAL PRODUCT

AS BUILT DRAWING OF MAIN SEWER "L" ZALTA STP TO CIDCO STP RA BILL-2 AND RA BILL-3

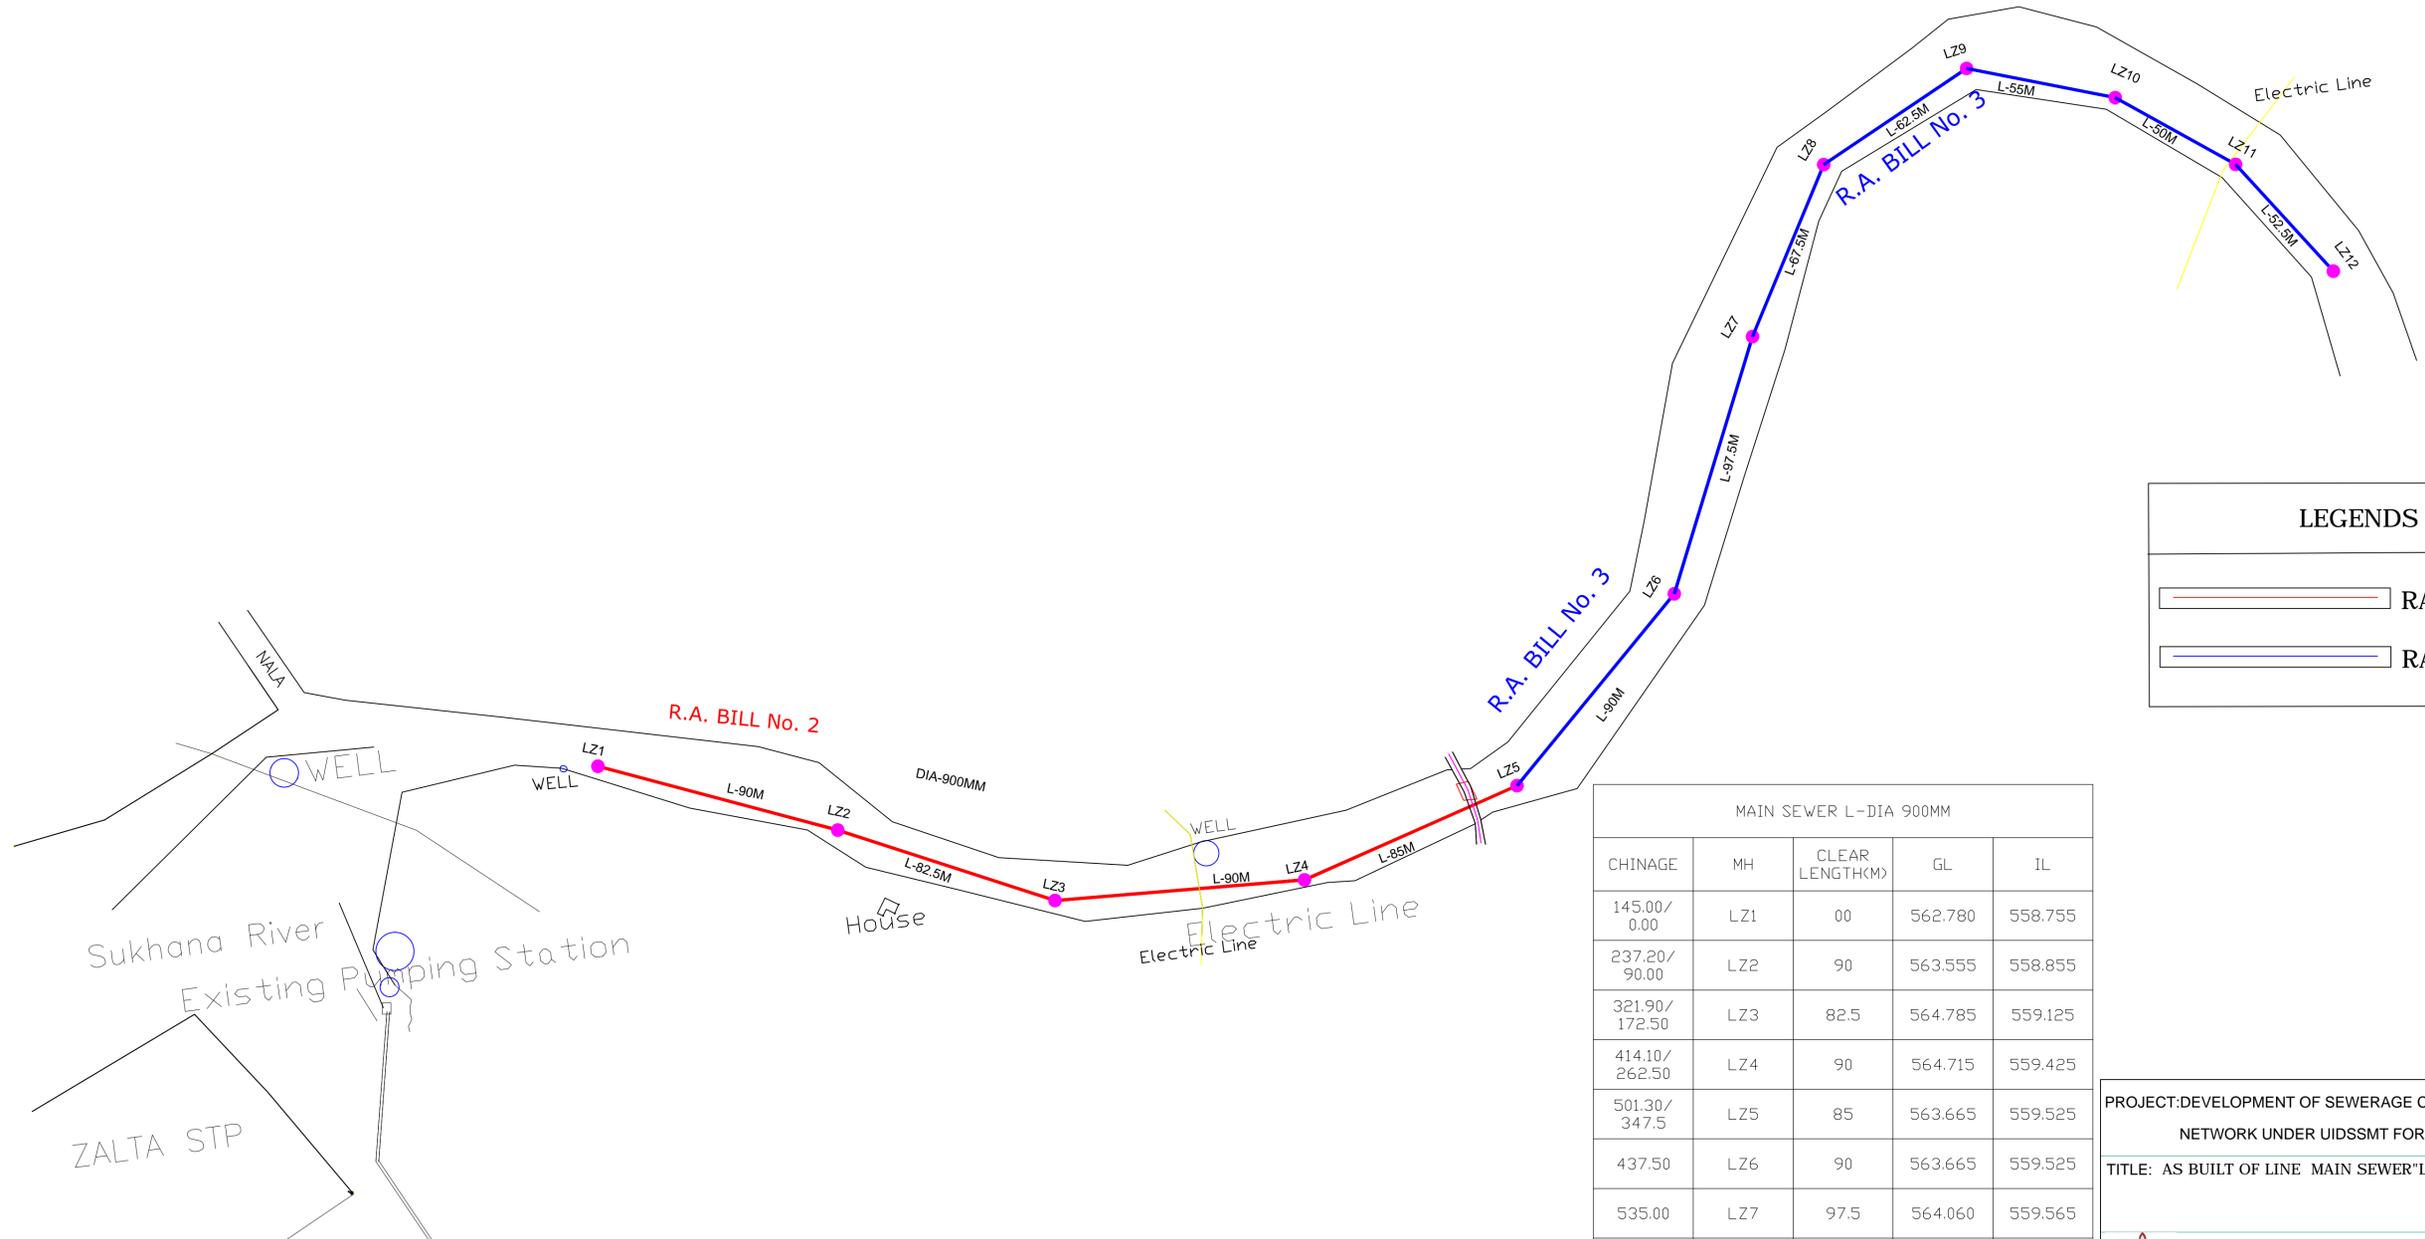

LEGENDS

RA BILL-2
 RA BILL-3

MAIN SEWER L-DIA 900MM				
CHINAGE	MH	CLEAR LENGTH(M)	GL	IL
145.00/ 0.00	LZ1	00	562.780	558.755
237.20/ 90.00	LZ2	90	563.555	558.855
321.90/ 172.50	LZ3	82.5	564.785	559.125
414.10/ 262.50	LZ4	90	564.715	559.425
501.30/ 347.5	LZ5	85	563.665	559.525
437.50	LZ6	90	563.665	559.525
535.00	LZ7	97.5	564.060	559.565
602.50	LZ8	67.5	566.780	560.450
665.00	LZ9	62.5	566.680	560.625
720.00	LZ10	55	566.120	560.625
770.00	LZ11	50	566.050	560.805
822.50	LZ12	52.5	566.170	560.930

PROJECT: DEVELOPMENT OF SEWERAGE COLLECTION NETWORK UNDER UIDSSMT FOR AURANGABAD CITY

TITLE: AS BUILT OF LINE MAIN SEWER "L"


AURANGABAD MUNICIPAL CORPORATION,
 TOWN HALL, AURANGABAD

AGENCY: KHILARI INFRASTRUCTURE PVT. LTD.
 101, PRABHAT CENTER, SECT-1A, CBD, BELAPUR,
 NAVI MUMBAI-400 614

CONSULTANT: FORTRESS INFRASTRUCTURE
 ADVISORY SERVICES,

SCALE 1:1000

AS BUILT DRAWING OF BRANCH SEWER "L" FROM THAKRE NAGAR TO MUKUNDWADI RA BILL-6

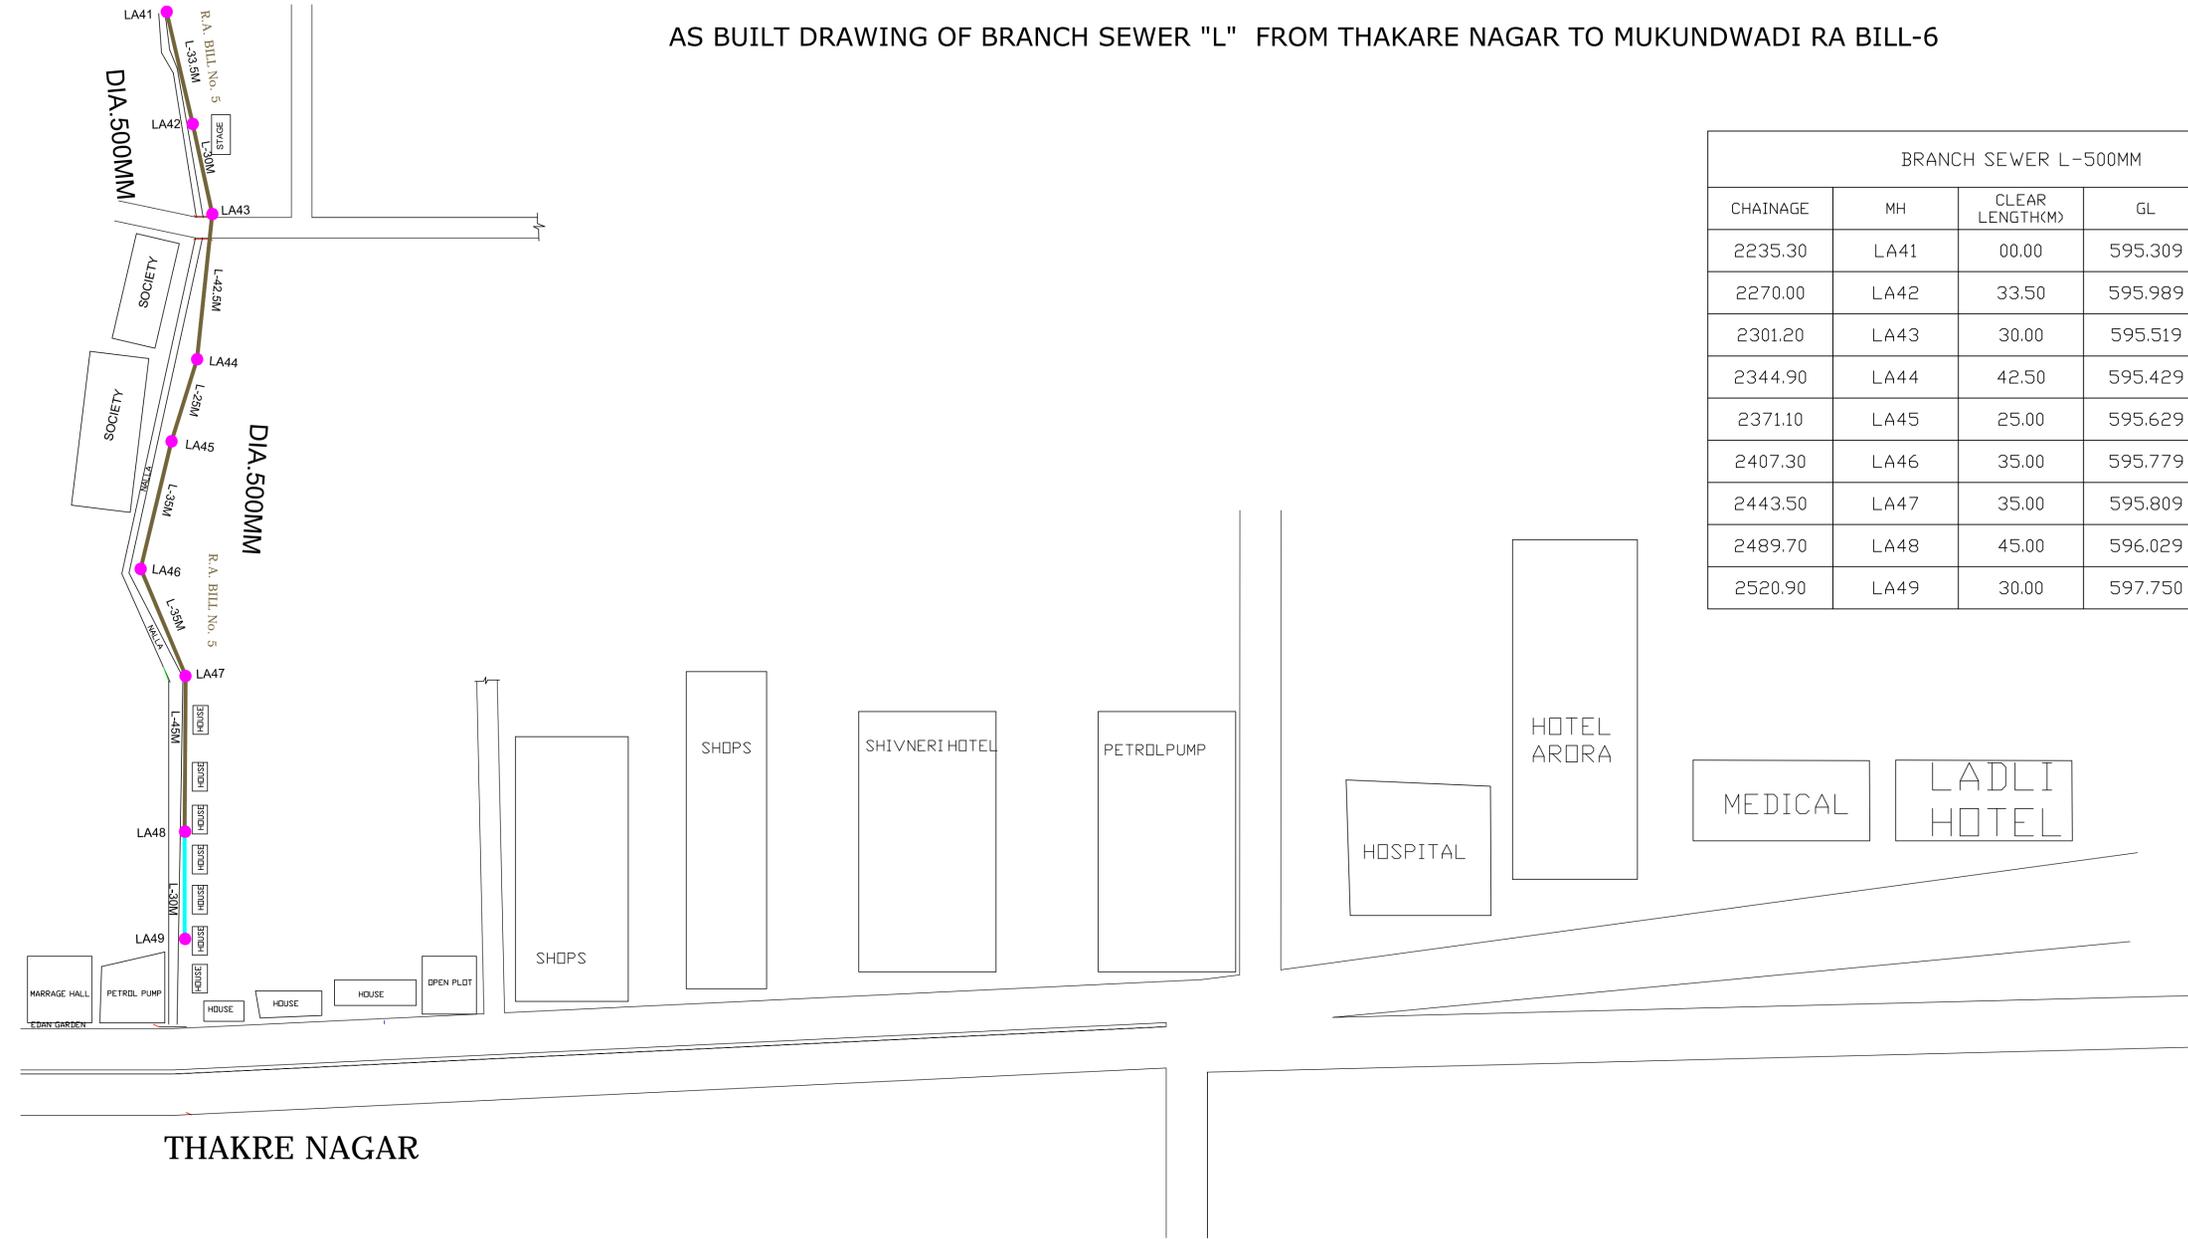

BRANCH SEWER L-500MM				
CHAINAGE	MH	CLEAR LENGTH(M)	GL	IL
2235.30	LA41	00.00	595.309	592.234
2270.00	LA42	33.50	595.989	592.689
2301.20	LA43	30.00	595.519	592.769
2344.90	LA44	42.50	595.429	592.879
2371.10	LA45	25.00	595.629	592.939
2407.30	LA46	35.00	595.779	594.029
2443.50	LA47	35.00	595.809	594.109
2489.70	LA48	45.00	596.029	593.229
2520.90	LA49	30.00	597.750	593.560

LEGENDS	
	RA BILL -5
	RA BILL -6

PROJECT: DEVELOPMENT OF SEWERAGE COLLECTION NETWORK UNDER UIDSSMT FOR AURANGABAD CITY

TITLE: AS BUILT DRAWING OF BRANCH SEWER "L"




AURANGABAD MUNICIPAL CORPORATION,
TOWN HALL, AURANGABAD

AGENCY: KHILARI INFRASTRUCTURE PVT. LTD.
101, PRABHAT CENTER, SECT-1A, CBD, BELAPUR,
NAVI MUMBAI-400 614

CONSULTANT: FORTRESS INFRASTRUCTURE
ADVISORY SERVICES, MARINE LINES, MUMBAI-2

SCALE 1:1000

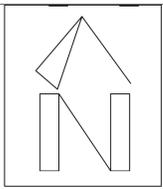


AS BUILT DRAWING OF MAIN SEWER "L"-SEWER TO SANGHARSHNAGAR BRANCH RA BILL-3



LEGENDS	
	RA BILL-1
	RA BILL-2
	RA BILL-3

MAIN SEWER DIA.500MM				
CHAINAGE	MH	LENGTH	GL	IL
0	LM6	0.00	583.639	580.694
62.200	LM6.1	60.00	585.629	581.674
124.400	LM6.2	60.00	584.609	580.934
186.600	LM6.3	60.00	585.209	581.204
248.800	LM6.4	60.00	586.204	581.279
293.500	LM6.5	42.50	585.629	581.474
330.000	LM6.6	35.00	586.465	582.355
330.000	LM6.7	60.00	586.465	582.355
391.5000	LM6.8	30.00	586.650	582.495
423.000	LM6.9	30.00	587.292	582.905
454.500	LM6.10	35.00	587.344	583.605
490.250	LM6.11	50.00	587.500	583.715
583.250	LM6.12	40.00	587.599	584.324
612.250	LM6.13	27.50	588.090	584.900
643.750	LM6.14	30.00	588.0900	584.984

CHAINAGE	MH	LENGTH	GL	IL
687.750	LM6.15	42.500	588.180	585.059
721.750	LM6.16	32.500	587.810	585.164
755.750	LM6.17	32.500	588.400	585.244
794.750	LM6.18	37.500	588.580	585.325
828.750	LM6.18.1	32.500	589.120	585.576
862.750	LM6.18.2	32.500	589.300	585.576
931.750	LM6.18.3	67.500	588.885	585.615
955.750	LM6.19	22.500	589.680	585.970
987.250	LM6.20	30	589.690	586.345
1026.250	LM6.21	37.500	590.300	586.440
1073.750	LM6.22	47.500	590.420	586.860
1106.250	LM6.23	32.500	588.910	586.860
1136.250	LM6.24	30.000	591.155	587.605
1173.750	LM6.25	37.500	590.245	587.995
1203.750	LM6.26	30.000	591.920	588.170
1231.250	LM6.27	27.500	590.500	588.250

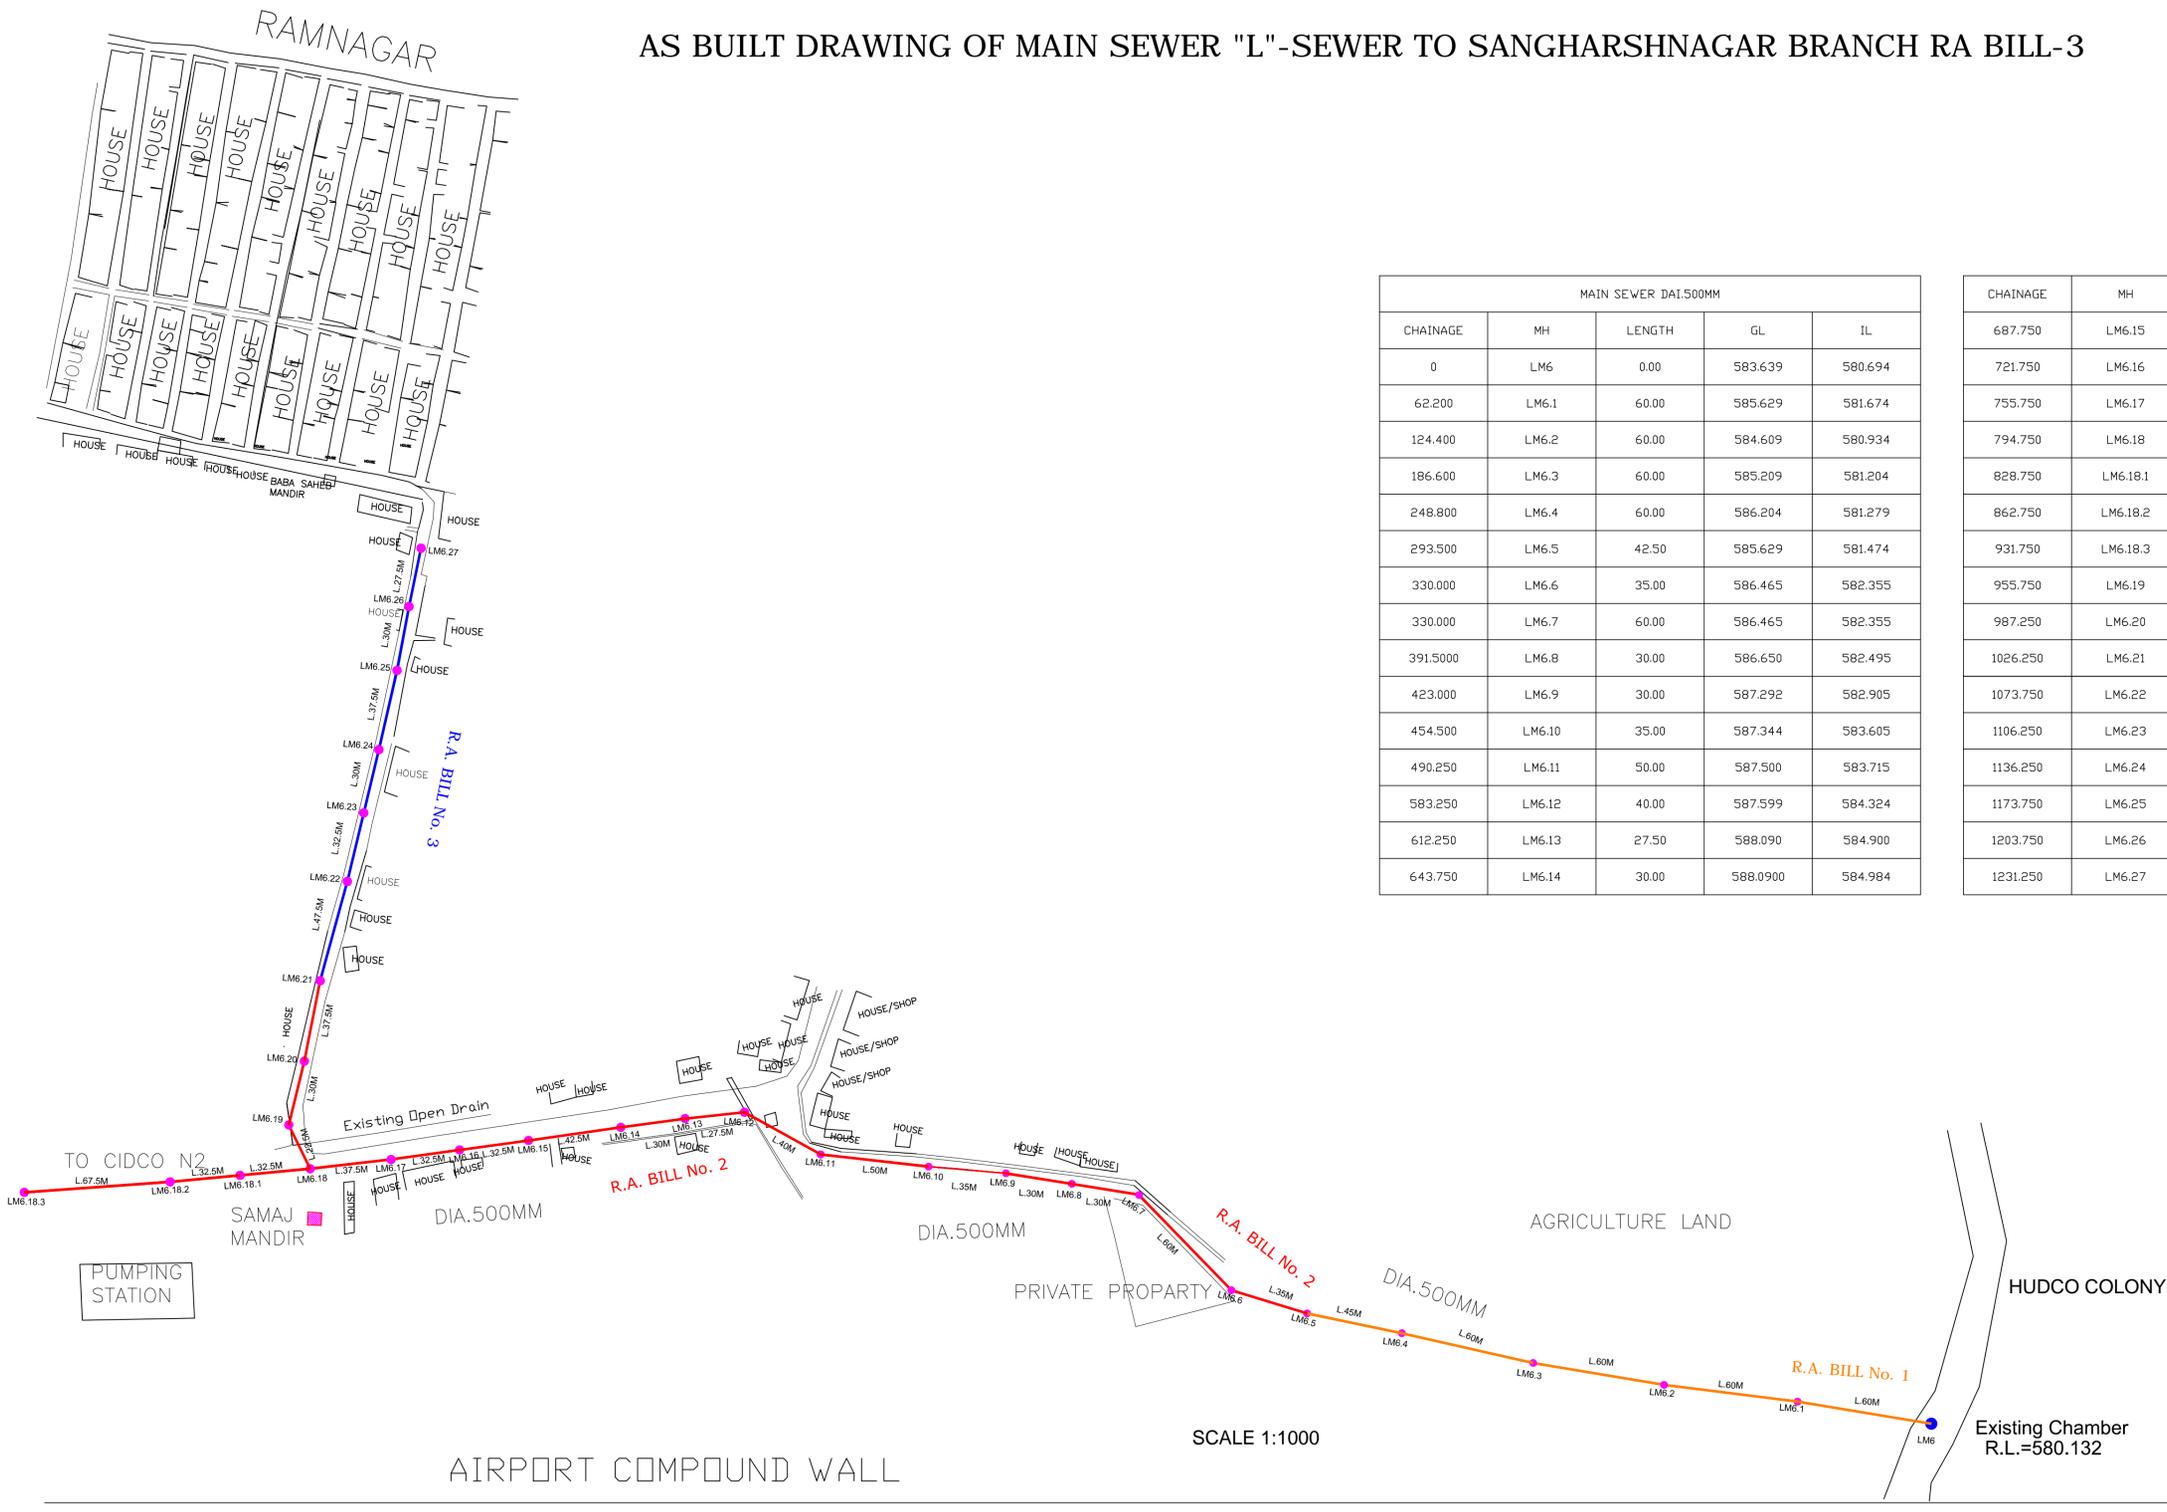

SCALE 1:1000



PROJECT: DEVELOPMENT OF SEWERAGE COLLECTION NETWORK UNDER UIDSSMT FOR AURANGABAD CITY
 TITLE: BUILT OF MAIN SEWER "L" SANGHARSHNAGAR

AURANGABAD MUNICIPAL CORPORATION, TOWN HALL, AURANGABAD

AGENCY: KHILARI INFRASTRUCTURE PVT. LTD. 101, PRABHAT CENTER, SECT-1A, CBD, BELAPUR, NAVI MUMBAI-400 614

CONSULTANT: FORTRESS INFRASTRUCTURE ADVISORY SERVICES, MARINE LINES, MUMBAI-2

AS BUILT DRAWING OF SEWER "L" JALNA ROAD CROSSING RA BILL-6

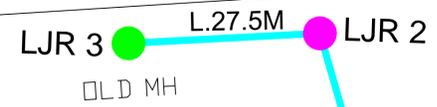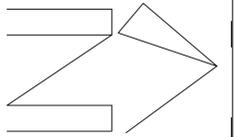

LEGENDS	
	RA BILL -6

JALNA ROAD CROSSING

CHAINAGE	MH	CLEAR LENGTH (M)	GL	IL
CH0.00	LJR 1	0.00	603.824	601.324
CH60.90	LJR 2	60.00	605.194	601.405
CH89.60	LJR 3	27.50	605.205	601.450

PROJECT:DEVELOPMENT OF SEWERAGE COLLECTION NETWORK UNDER UIDSSMT FOR AURANGABAD CITY

TITLE: AS BUILT DRAWING OF SEWER "L"





AURANGABAD MUNICIPAL CORPORATION,
TOWN HALL, AURANGABAD

AGENCY:KHILARI INFRASTRUCTURE PVT. LTD.
101, PRABHAT CENTER, SECT-1A, CBD, BELAPUR,
NAVI MUMBAI-400 614

CONSULTANT: FORTRESS INFRASTRUCTURE
ADVISORY SERVICES, MARINE LINES, MUMBAI-2

SCALE 1:1000

AS BUILT DRAWING OF SEWER "L" PRAKASH NAGAR RA BILL-6

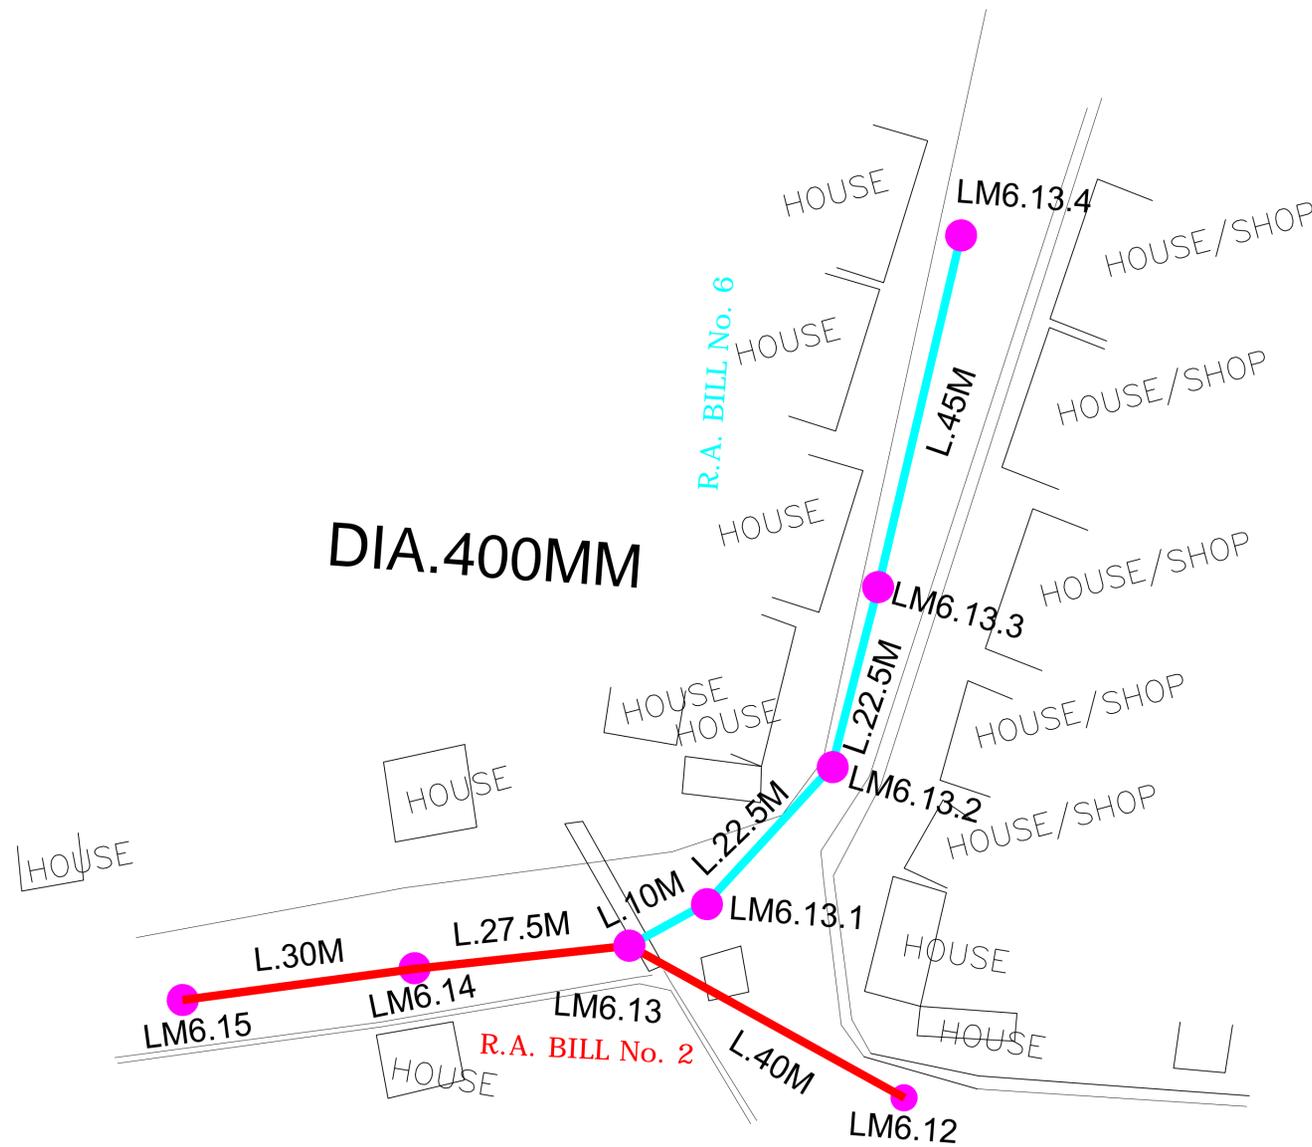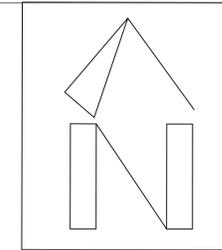

LEGENDS	
	RA BILL -2
	RA BILL -6

CHAINAGE	MH	CLEAR LENGTH (M)	GL	IL
0.00	LM6.13	0.00	588.090	585.590
11.20	LM6.13.1	10.00	588.100	585.620
34.90	LM6.13.2	22.50	588.105	585.695
58.60	LM6.13.3	22.50	588.360	585.750
104.80	LM6.13.4	45.00	588.815	585.870

SCALE 1:1000

PROJECT: DEVELOPMENT OF SEWERAGE COLLECTION NETWORK UNDER UIDSSMT FOR AURANGABAD CITY

TITLE: AS BUILT DRAWING OF SEWER "L"




AURANGABAD MUNICIPAL CORPORATION,
TOWN HALL, AURANGABAD

AGENCY: KHILARI INFRASTRUCTURE PVT. LTD.
101, PRABHAT CENTER, SECT-1A, CBD, BELAPUR,
NAVI MUMBAI-400 614


CONSULTANT: FORTRESS INFRASTRUCTURE
ADVISORY SERVICES, MARINE LINES, MUMBAI-2

AS BUILT DRAWING OF BRANCH SEWER "M" CHIKALTHANA BILL-6

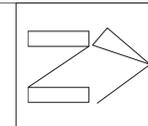

JALNA ROAD

LEGENDS	
	RA BILL- 6

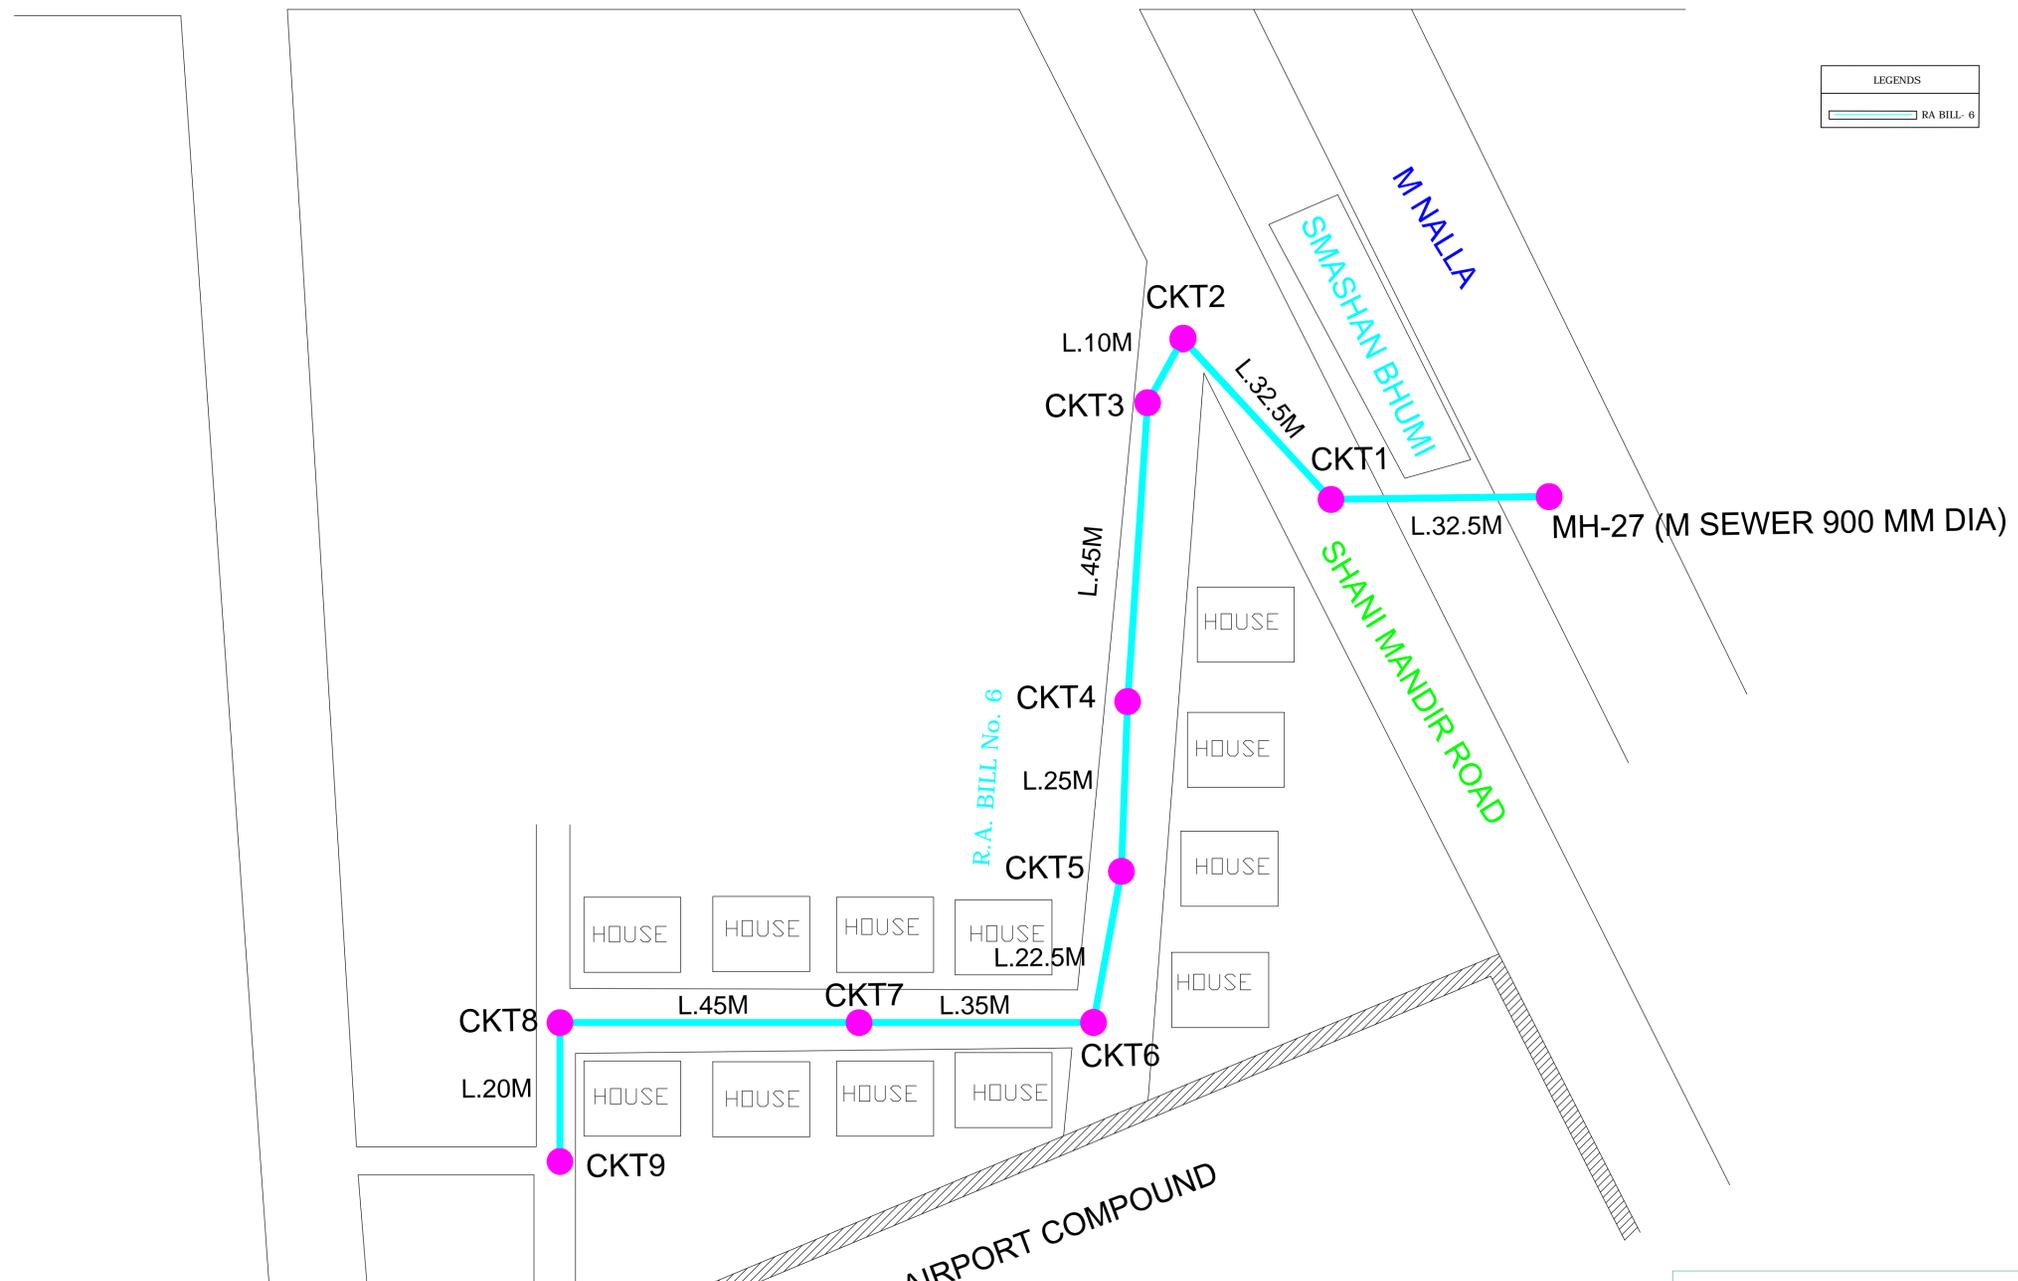

BRANCH SEWER "M" (CHIKALTHANA) DIA 400MM				
CHAINAGE	MH	CLEAR LENGTH(M)	GL	IL
0.00	MH27	0.00	566.720	565.040
33.70	CKT-1	32.50	568.674	565.629
67.40	CKT-2	32.50	569.300	566.210
78.60	CKT-3	10.00	570.425	566.430
124.80	CKT-4	45.00	570.735	566.550
151.00	CKT-5	25.00	570.295	566.615
174.70	CKT-6	22.50	570.165	566.675
210.90	CKT-7	35.00	570.050	566.760
257.10	CKT-8	45.00	570.165	567.175
278.30	CKT-9	20.00	570.415	567.225

SCALE 1:1000

PROJECT:DEVELOPMENT OF SEWERAGE COLLECTION NETWORK UNDER UIDSSMT FOR AURANGABAD CITY
 TITLE: AS BUILT OF BRANCH SEWER "M" DIA-400mm

AURANGABAD MUNICIPAL CORPORATION,
 TOWN HALL, AURANGABAD


AGENCY:KHILARI INFRASTRUCTURE PVT. LTD.
 101, PRABHAT CENTER, SECT-1A, CBD, BELAPUR,
 NAVI MUMBAI-400 614

CONSULTANT: FORTRESS INFRASTRUCTURE ADVISORY SERVICES.

AS BUILT OF LINE MAIN SEWER "L" ZALTA STP TO CIDCO STP RA BILL-3

MAIN SEWER L-DIA 900MM				
CHINAGE	MH	CLEAR LENGTH(M)	GL	IL
822.50	LZ12	52.5	566.170	560.930
910.00	LZ13	87.5	567.390	561.135
965.00	LZ14	55	567.220	561.510
1040.00	LZ15	75	567.715	562.009
1125.00	LZ16	85	567.430	562.321
1220.00	LZ17	95	567.00	562.850
1282.50	LZ18	62.5	567.30	563.350
1302.50	LZ19	20	569.700	563.375
1400.00	LZ20	97.5	567.800	563.905
1452.5	LZ21	52.5	568.245	564.275
1517.5	LZ22	65	568.500	564.660

1572.5	LZ23	55	569.000	565.330
1635.0	LZ24	62.5	569.535	566.815
1717.50	LZ25	82.5	570.315	566.790
1797.50	LZ26	80	571.288	567.550
1847.50	LZ27	50	571.685	568.250

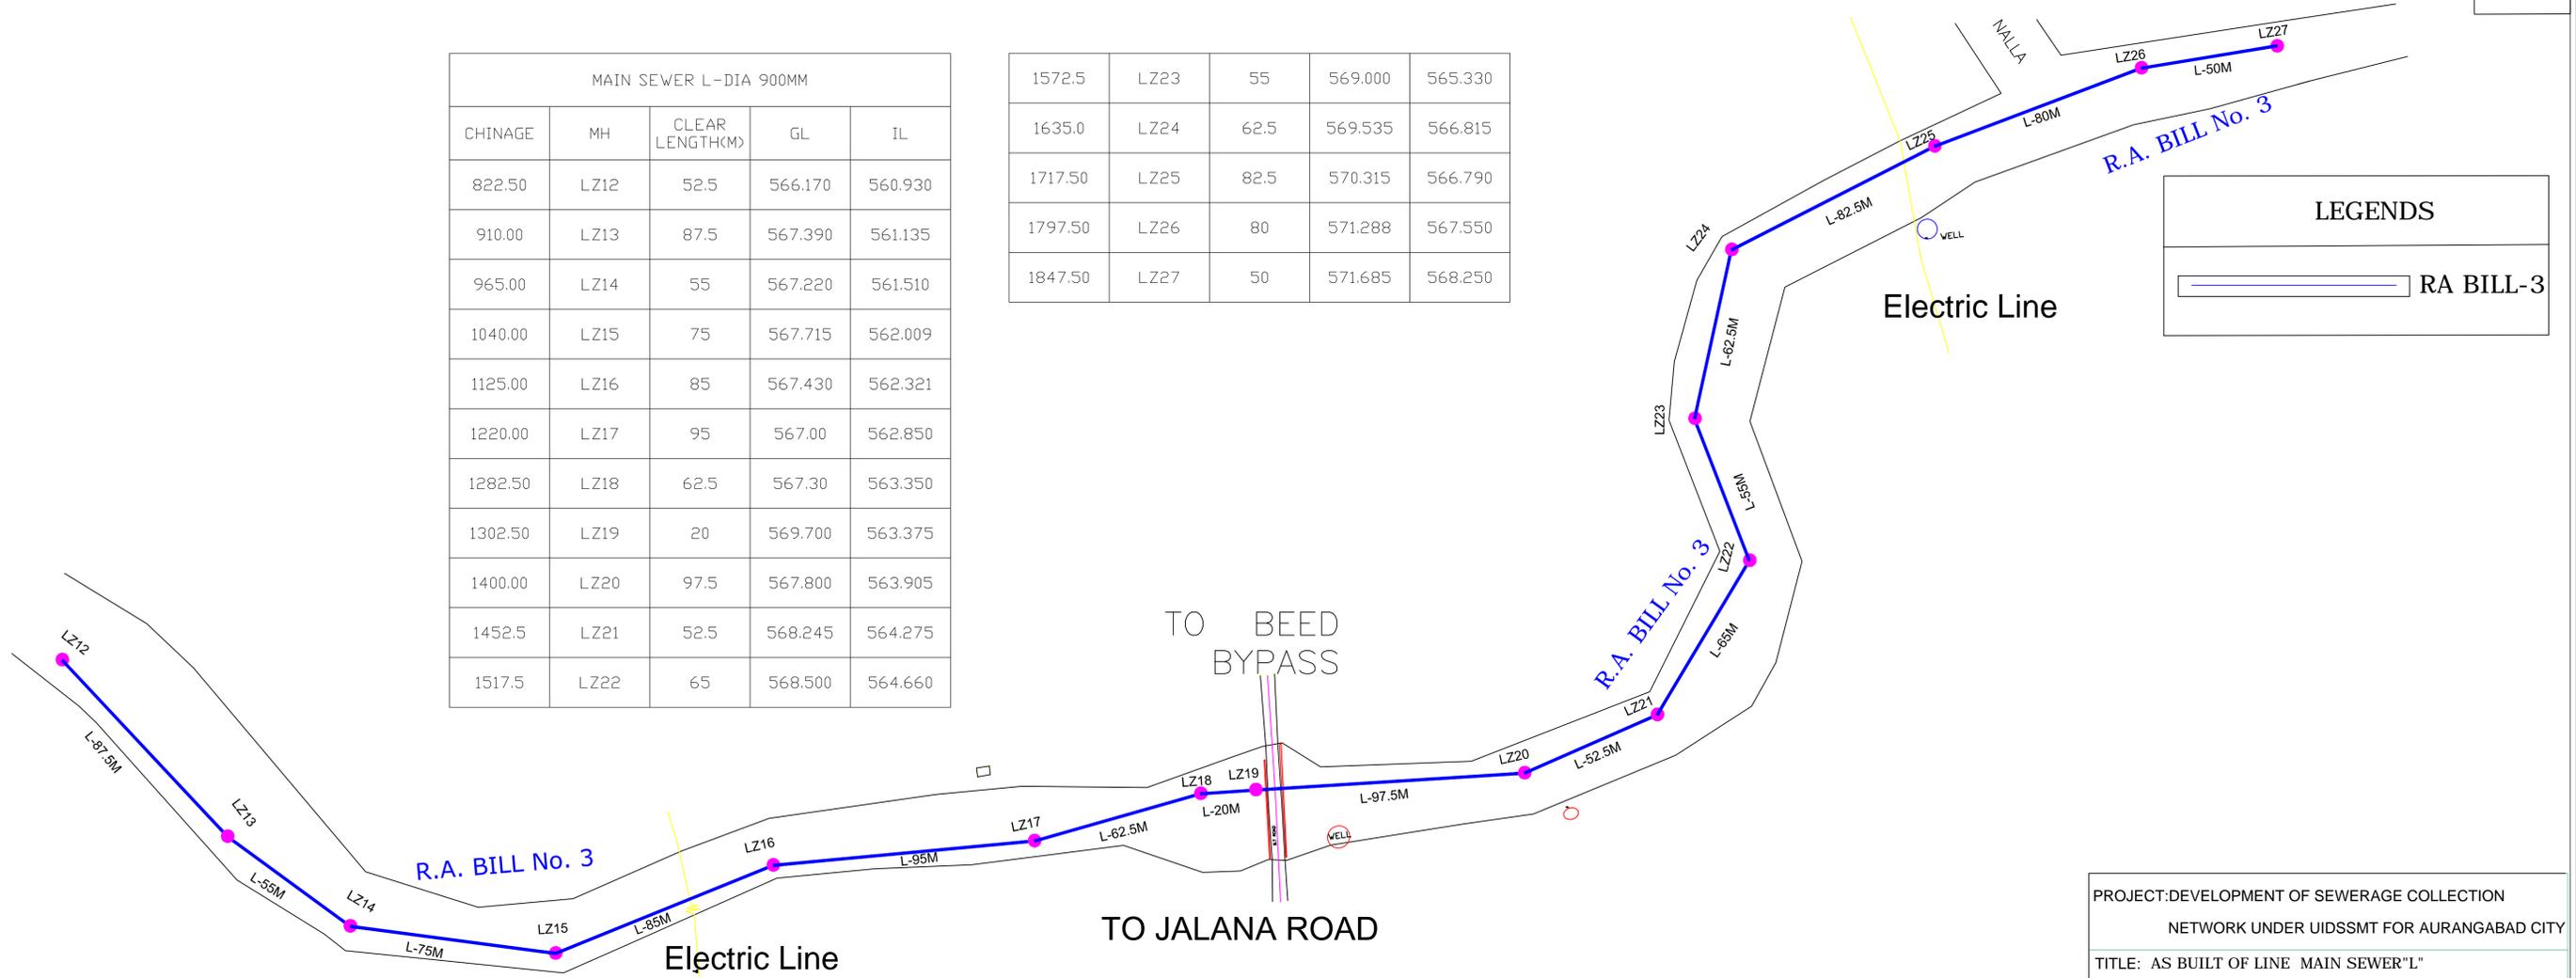

LEGENDS

RA BILL-3

PROJECT: DEVELOPMENT OF SEWERAGE COLLECTION NETWORK UNDER UIDSSMT FOR AURANGABAD CITY

TITLE: AS BUILT OF LINE MAIN SEWER "L"


 AURANGABAD MUNICIPAL CORPORATION, TOWN HALL, AURANGABAD

 AGENCY: KHILARI INFRASTRUCTURE PVT. LTD. 101, PRABHAT CENTER, SECT-1A, CBD, BELAPUR, NAVI MUMBAI-400 614

CONSULTANT: FORTRESS INFRASTRUCTURE ADVISORY SERVICES.

SCALE 1:1000

AS BUILT OF LINE MAIN SEWER "L" ZALTA STP TO CIDCO STP RA BILL-3

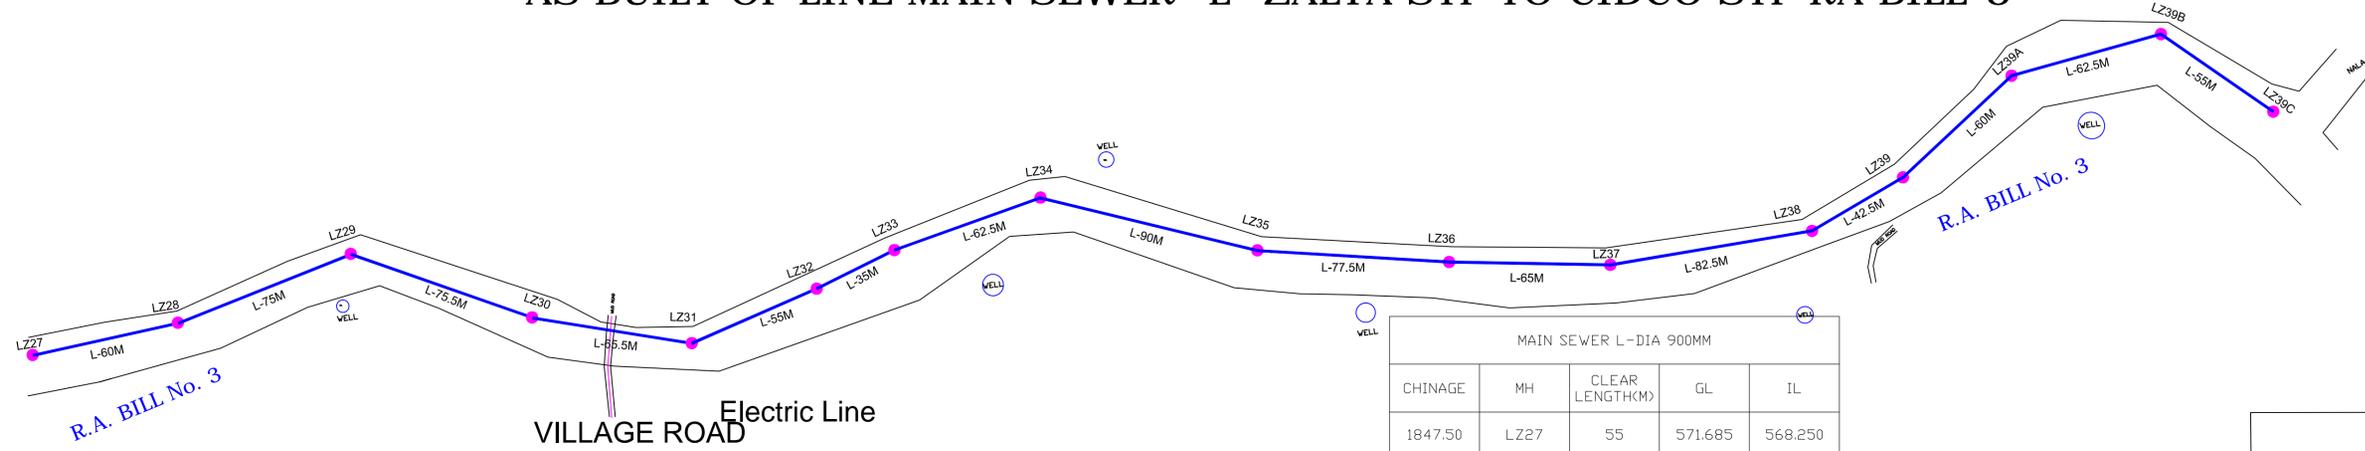


MAIN SEWER L-DIA 900MM				
CHINAGE	MH	CLEAR LENGTH(M)	GL	IL
1847.50	LZ27	55	571.685	568.250
1907.50	LZ28	60	571.305	568.950
1982.50	LZ29	75	572.730	569.700
2060.00	LZ30	75.5	573.565	570.430
2125.00	LZ31	65.5	573.970	571.050
2180.00	LZ32	55	575.850	571.120
2215.00	LZ33	35	575.730	571.730
2277.50	LZ34	62.5	575.380	571.890
2367.50	LZ35	90	576.210	572.050
2445.00	LZ36	77.5	575.960	572.210
2510.00	LZ37	65	576.310	572.350
92.5025	LZ38	82.5	576.270	572.830
2635.00	LZ39	42.5	576.672	573.322
2695.00	LZ39-A	60	576.827	573.410
2757.50	LZ39-B	62.5	576.897	573.557
2812.50	LZ29-C	55	577.120	573.690

LEGENDS	
	RA BILL-3

PROJECT: DEVELOPMENT OF SEWERAGE COLLECTION NETWORK UNDER UIDSSMT FOR AURANGABAD CITY	
TITLE: AS BUILT OF LINE MAIN SEWER "L"	
 AURANGABAD MUNICIPAL CORPORATION, TOWN HALL, AURANGABAD	
 AGENCY: KHILARI INFRASTRUCTURE PVT. LTD. 101, PRABHAT CENTER, SECT-1A, CBD, BELAPUR, NAVI MUMBAI-400 614	
CONSULTANT: FORTRESS INFRASTRUCTURE ADVISORY SERVICES.	

SCALE 1:1000

AS BUILT OF LINE MAIN SEWER "L" ZALTA STP TO CIDCO STP RA BILL-2 AND RA BILL-3

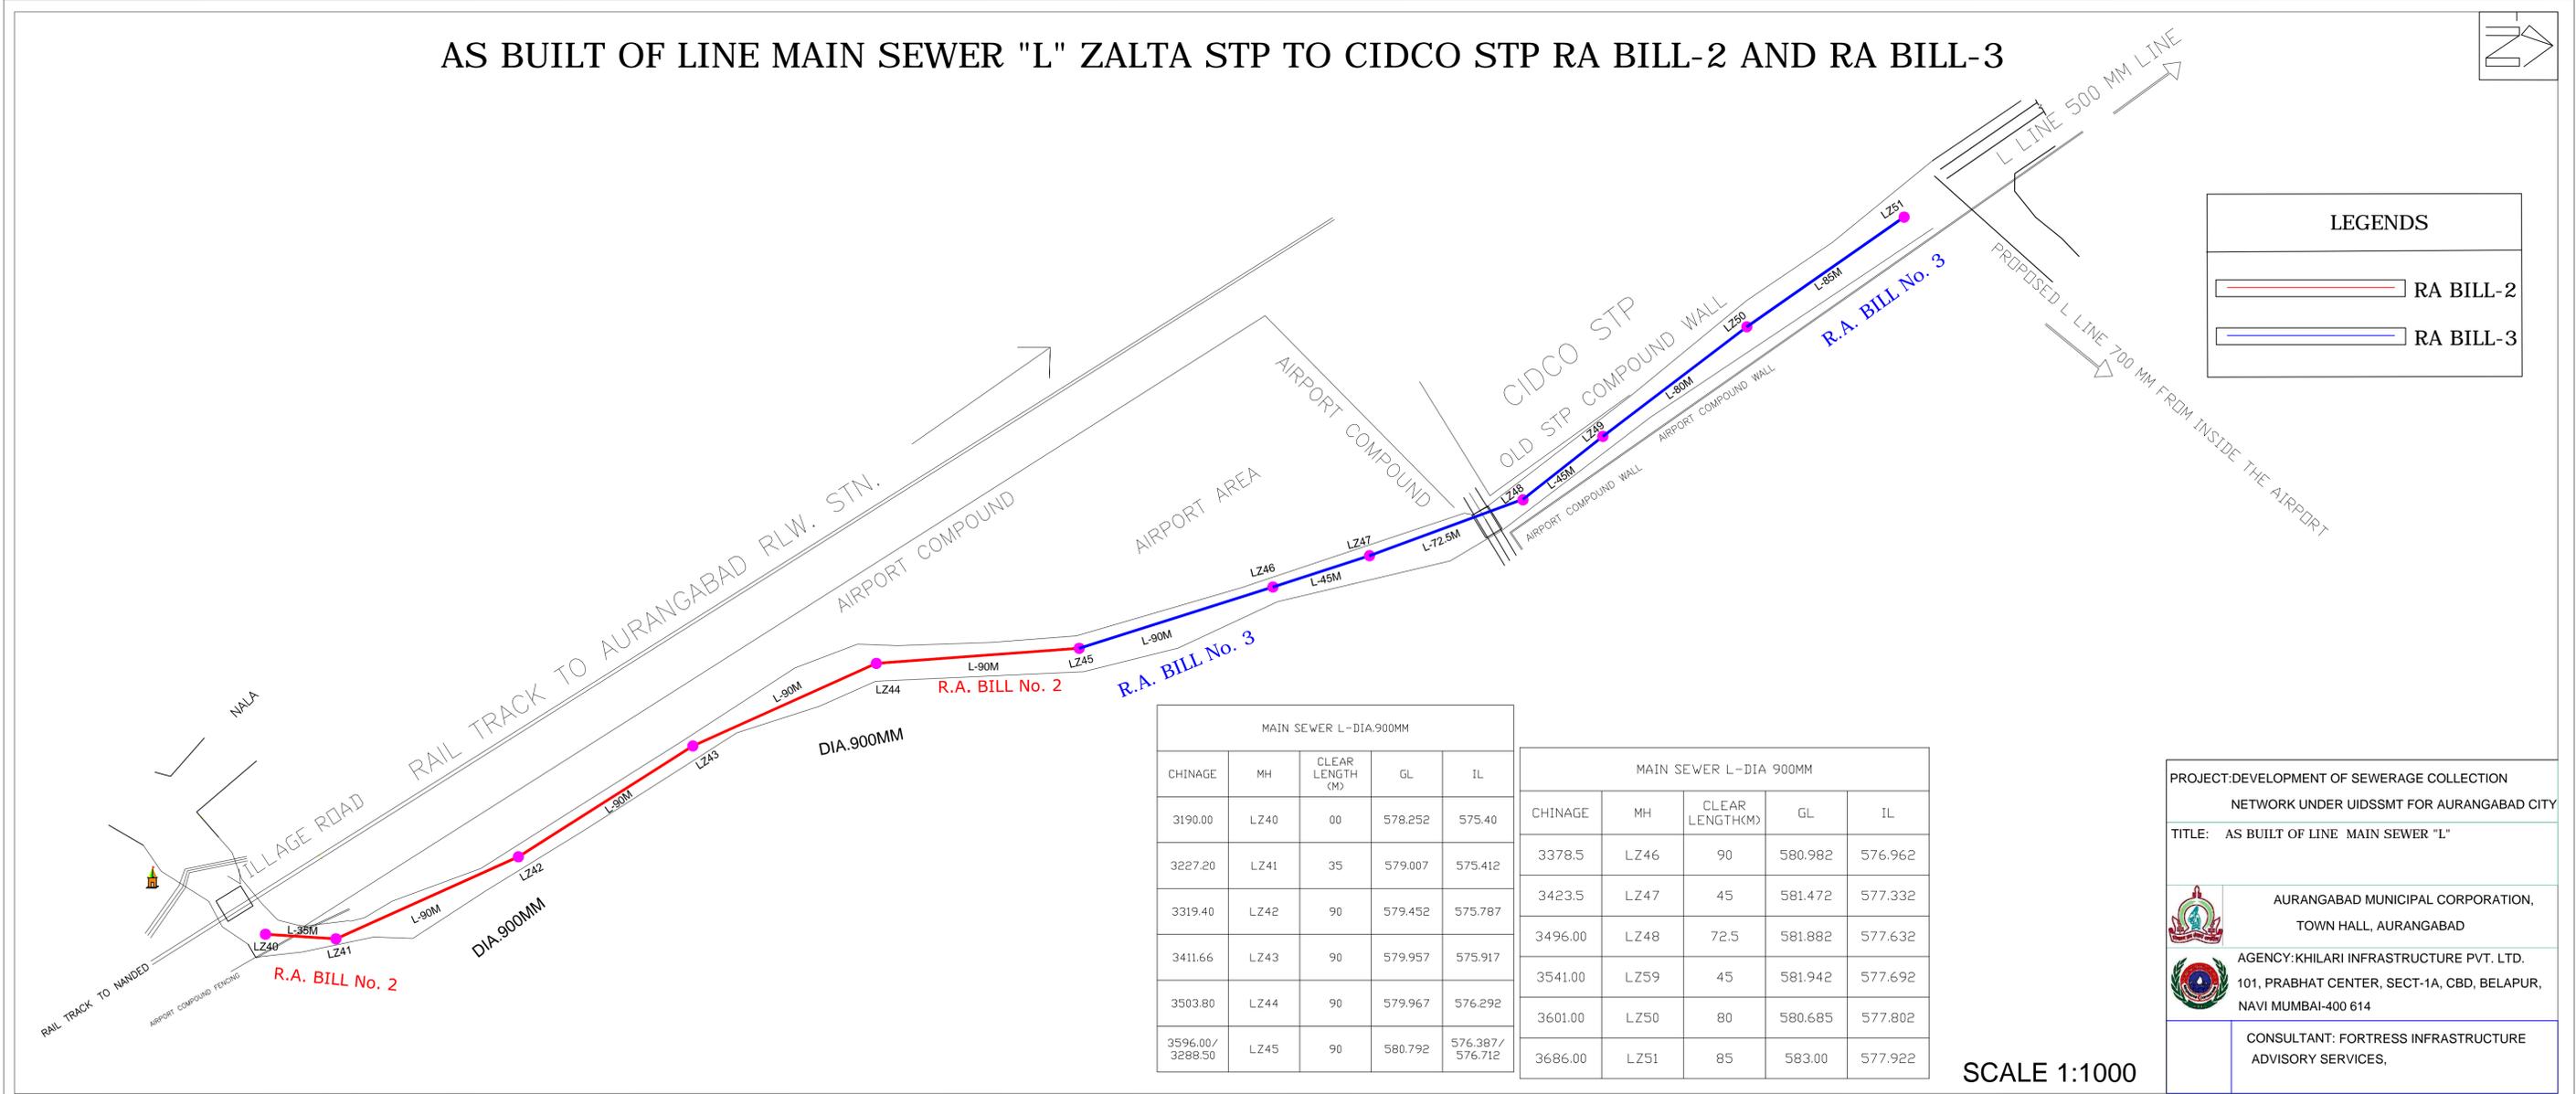

MAIN SEWER L-DIA.900MM				
CHINAGE	MH	CLEAR LENGTH (M)	GL	IL
3190.00	LZ40	00	578.252	575.40
3227.20	LZ41	35	579.007	575.412
3319.40	LZ42	90	579.452	575.787
3411.66	LZ43	90	579.957	575.917
3503.80	LZ44	90	579.967	576.292
3596.00/ 3288.50	LZ45	90	580.792	576.387/ 576.712

MAIN SEWER L-DIA 900MM				
CHINAGE	MH	CLEAR LENGTH(M)	GL	IL
3378.5	LZ46	90	580.982	576.962
3423.5	LZ47	45	581.472	577.332
3496.00	LZ48	72.5	581.882	577.632
3541.00	LZ49	45	581.942	577.692
3601.00	LZ50	80	580.685	577.802
3686.00	LZ51	85	583.00	577.922

LEGENDS

- RA BILL-2
- RA BILL-3

PROJECT: DEVELOPMENT OF SEWERAGE COLLECTION NETWORK UNDER UIDSSMT FOR AURANGABAD CITY

TITLE: AS BUILT OF LINE MAIN SEWER "L"



 AURANGABAD MUNICIPAL CORPORATION,
TOWN HALL, AURANGABAD

 AGENCY: KHILARI INFRASTRUCTURE PVT. LTD.
101, PRABHAT CENTER, SECT-1A, CBD, BELAPUR,
NAVI MUMBAI-400 614

CONSULTANT: FORTRESS INFRASTRUCTURE ADVISORY SERVICES,

SCALE 1:1000

AS BUILT DRAWING OF SEWER "L" RAMNAGAR TO MUKUNDWADI RA BILL-6

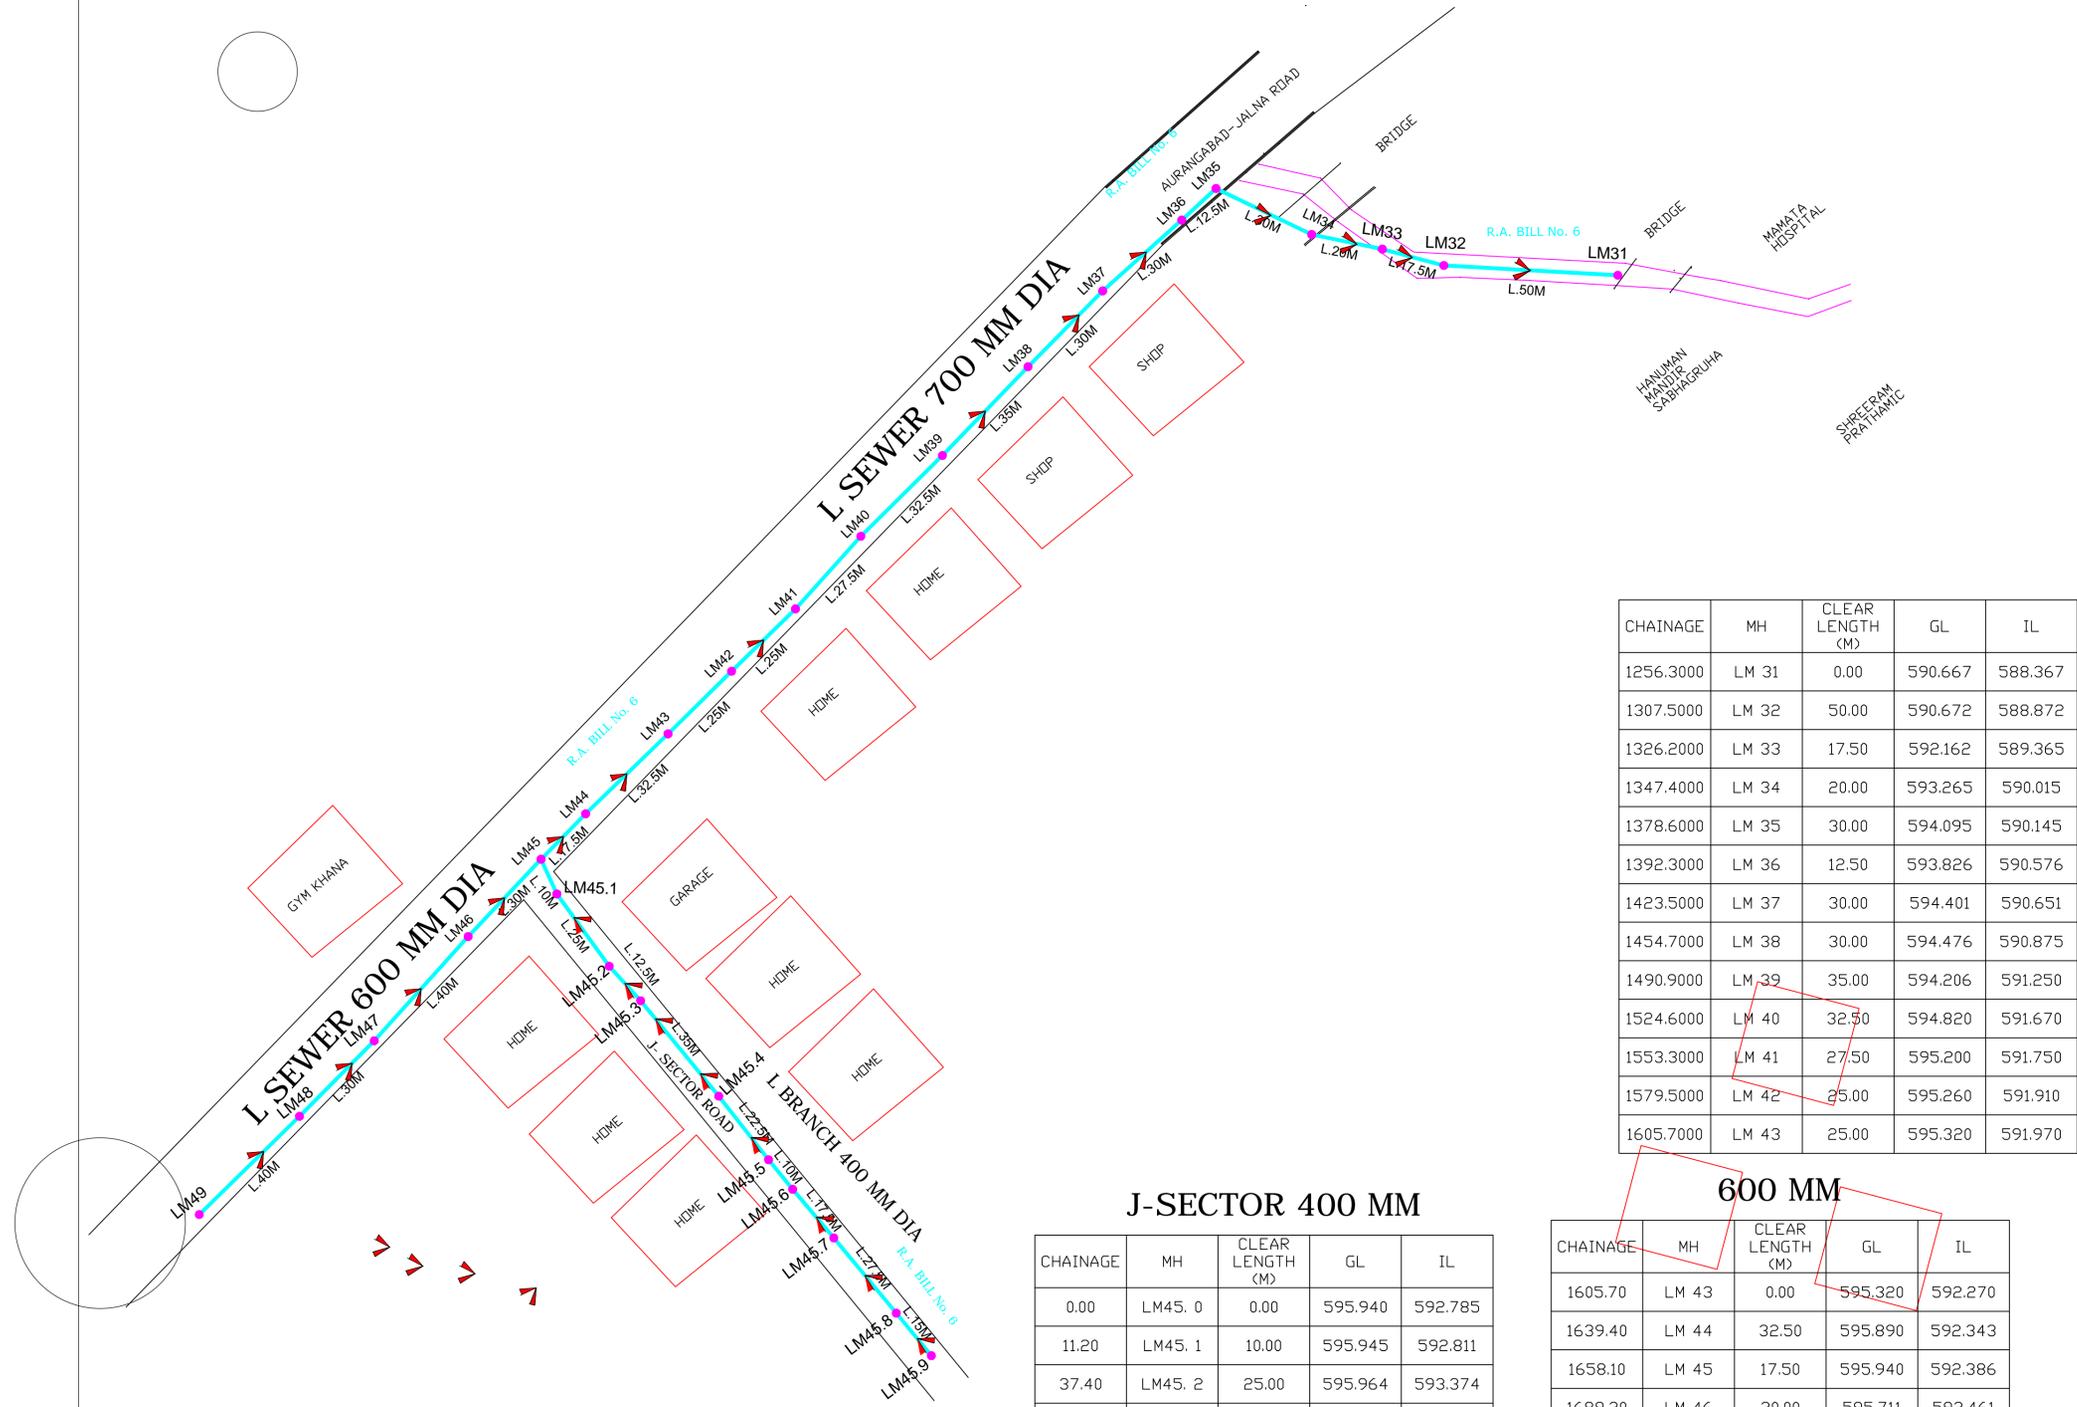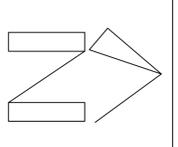

LEGENDS	
	RA BILL -6

CHAINAGE	MH	CLEAR LENGTH (M)	GL	IL
1256.3000	LM 31	0.00	590.667	588.367
1307.5000	LM 32	50.00	590.672	588.872
1326.2000	LM 33	17.50	592.162	589.365
1347.4000	LM 34	20.00	593.265	590.015
1378.6000	LM 35	30.00	594.095	590.145
1392.3000	LM 36	12.50	593.826	590.576
1423.5000	LM 37	30.00	594.401	590.651
1454.7000	LM 38	30.00	594.476	590.875
1490.9000	LM 39	35.00	594.206	591.250
1524.6000	LM 40	32.50	594.820	591.670
1553.3000	LM 41	27.50	595.200	591.750
1579.5000	LM 42	25.00	595.260	591.910
1605.7000	LM 43	25.00	595.320	591.970

J-SECTOR 400 MM

CHAINAGE	MH	CLEAR LENGTH (M)	GL	IL
0.00	LM45. 0	0.00	595.940	592.785
11.20	LM45. 1	10.00	595.945	592.811
37.40	LM45. 2	25.00	595.964	593.374
51.10	LM45. 3	12.50	596.494	594.104
87.30	LM45. 4	35.00	596.874	594.384
111.00	LM45. 5	22.50	597.134	594.644
122.20	LM45. 6	10.00	597.360	594.670
140.90	LM45. 7	17.50	597.410	594.720
169.60	LM45. 8	27.50	597.485	594.795
185.80	LM45. 9	15.00	597.525	594.835

600 MM

CHAINAGE	MH	CLEAR LENGTH (M)	GL	IL
1605.70	LM 43	0.00	595.320	592.270
1639.40	LM 44	32.50	595.890	592.343
1658.10	LM 45	17.50	595.940	592.386
1689.30	LM 46	30.00	595.711	592.461
1730.50	LM 47	40.00	595.910	592.860
1761.70	LM 48	30.00	596.985	592.935
1802.90	LM 49	40.00	597.085	593.035

SCALE 1:1000



PROJECT: DEVELOPMENT OF SEWERAGE COLLECTION NETWORK UNDER UIDSSMT FOR AURANGABAD CITY

TITLE: AS BUILT DRAWING OF BRANCH SEWER "L"

AURANGABAD MUNICIPAL CORPORATION,
TOWN HALL, AURANGABAD

AGENCY: KHILARI INFRASTRUCTURE PVT. LTD.
101, PRABHAT CENTER, SECT-1A, CBD, BELAPUR,
NAVI MUMBAI-400 614

CONSULTANT: FORTRESS INFRASTRUCTURE ADVISORY SERVICES, MARINE LINES, MUMBAI-2

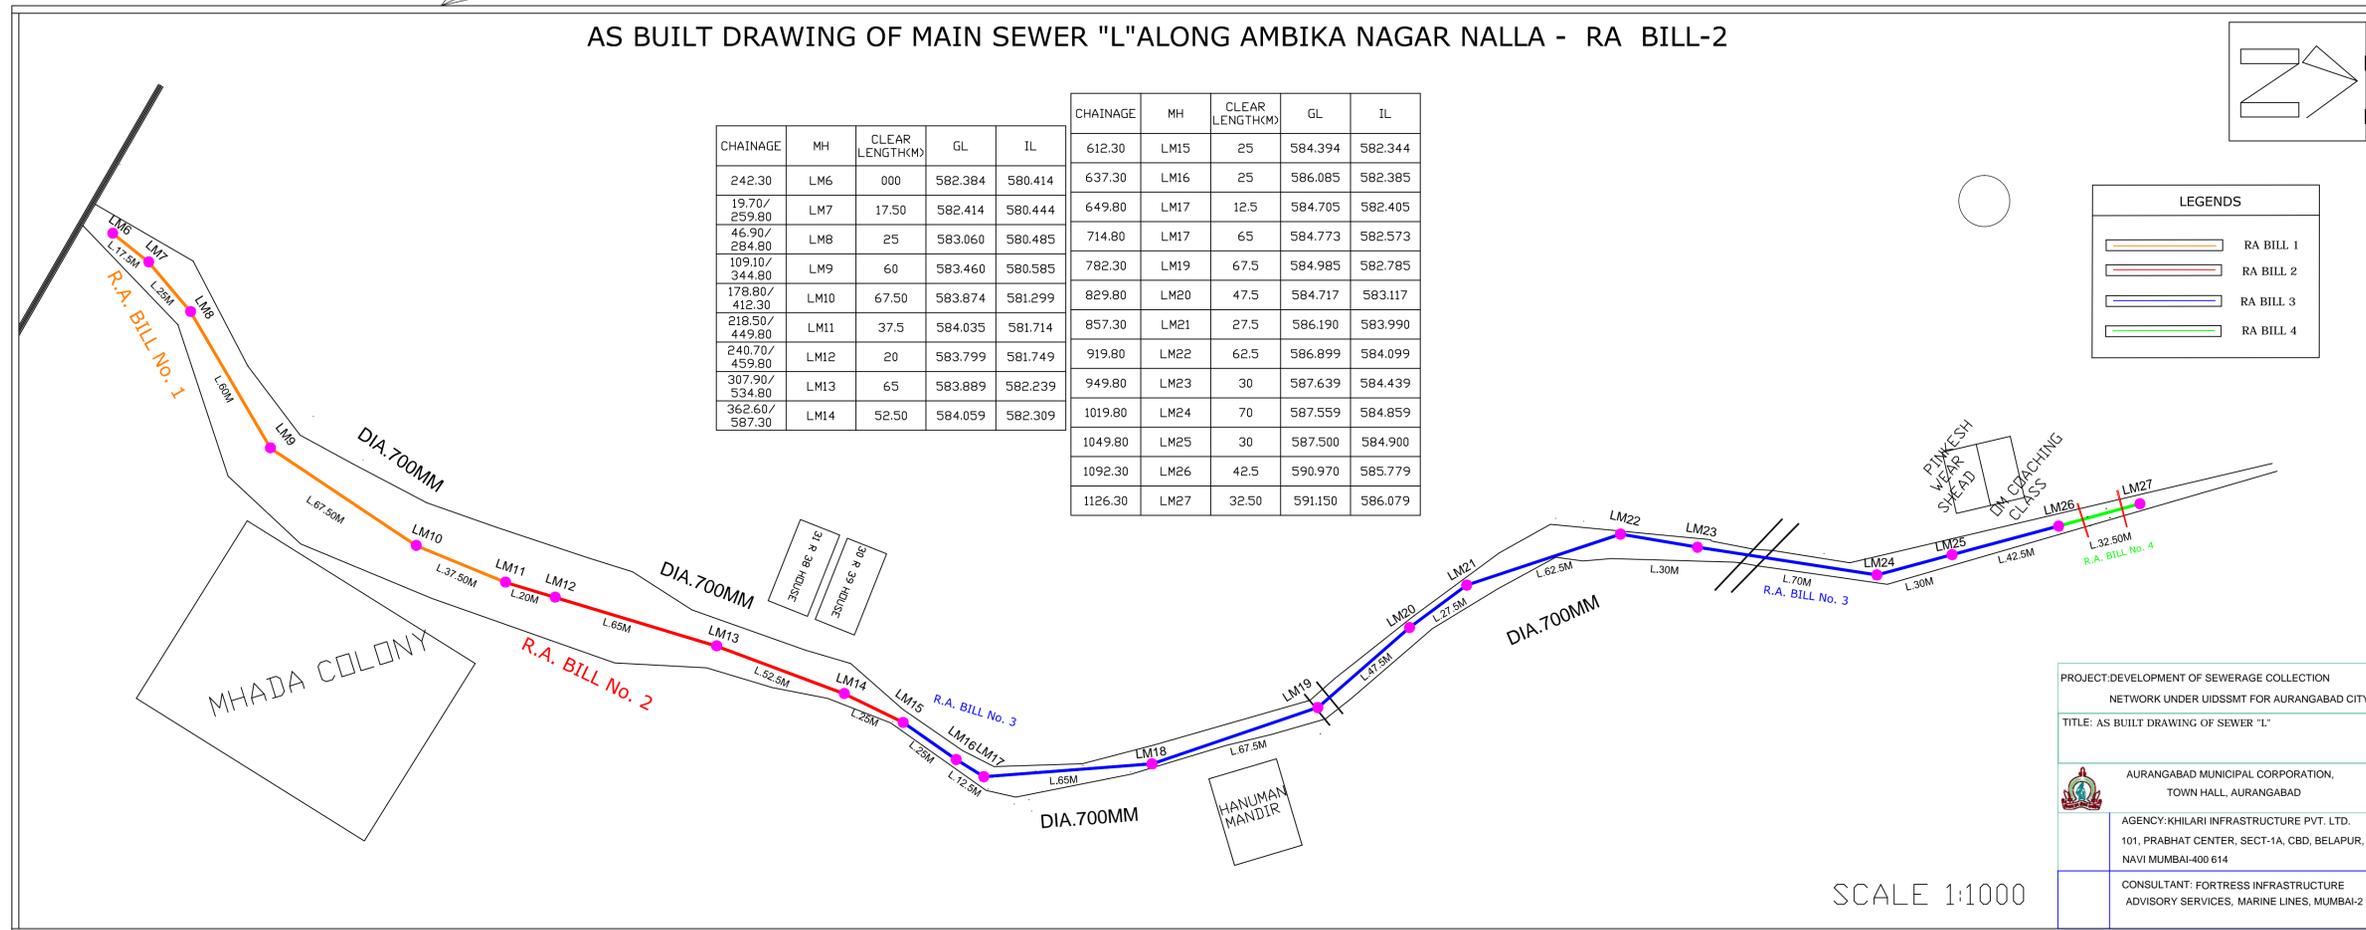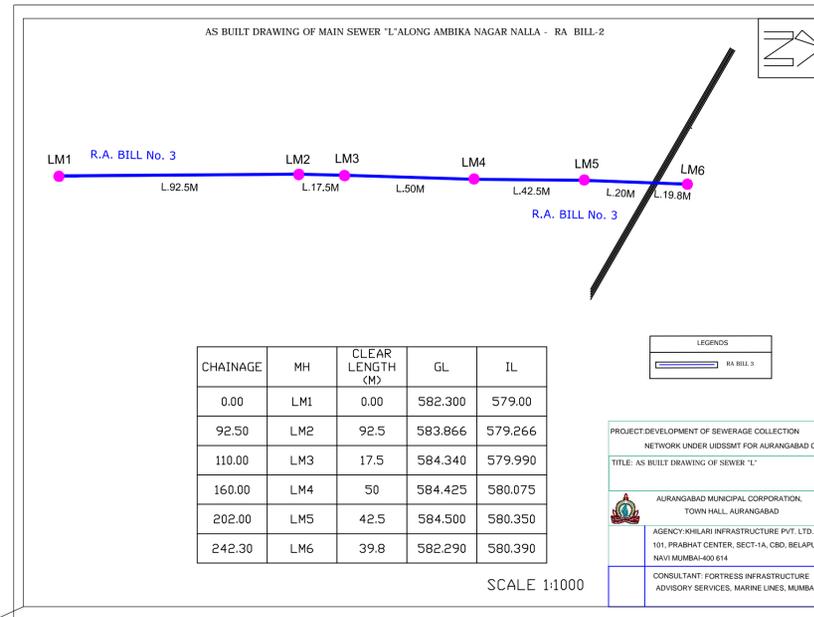


AS BUILT DRAWING OF BRANCH SEWER TO L-AMBIKANAGAR TO BABA PAILETNAGAR - RA BILL-4



AIRPORT COMPOUND

LEGENDS	
	RA BILL 1
	RA BILL 3
	RA BILL 4

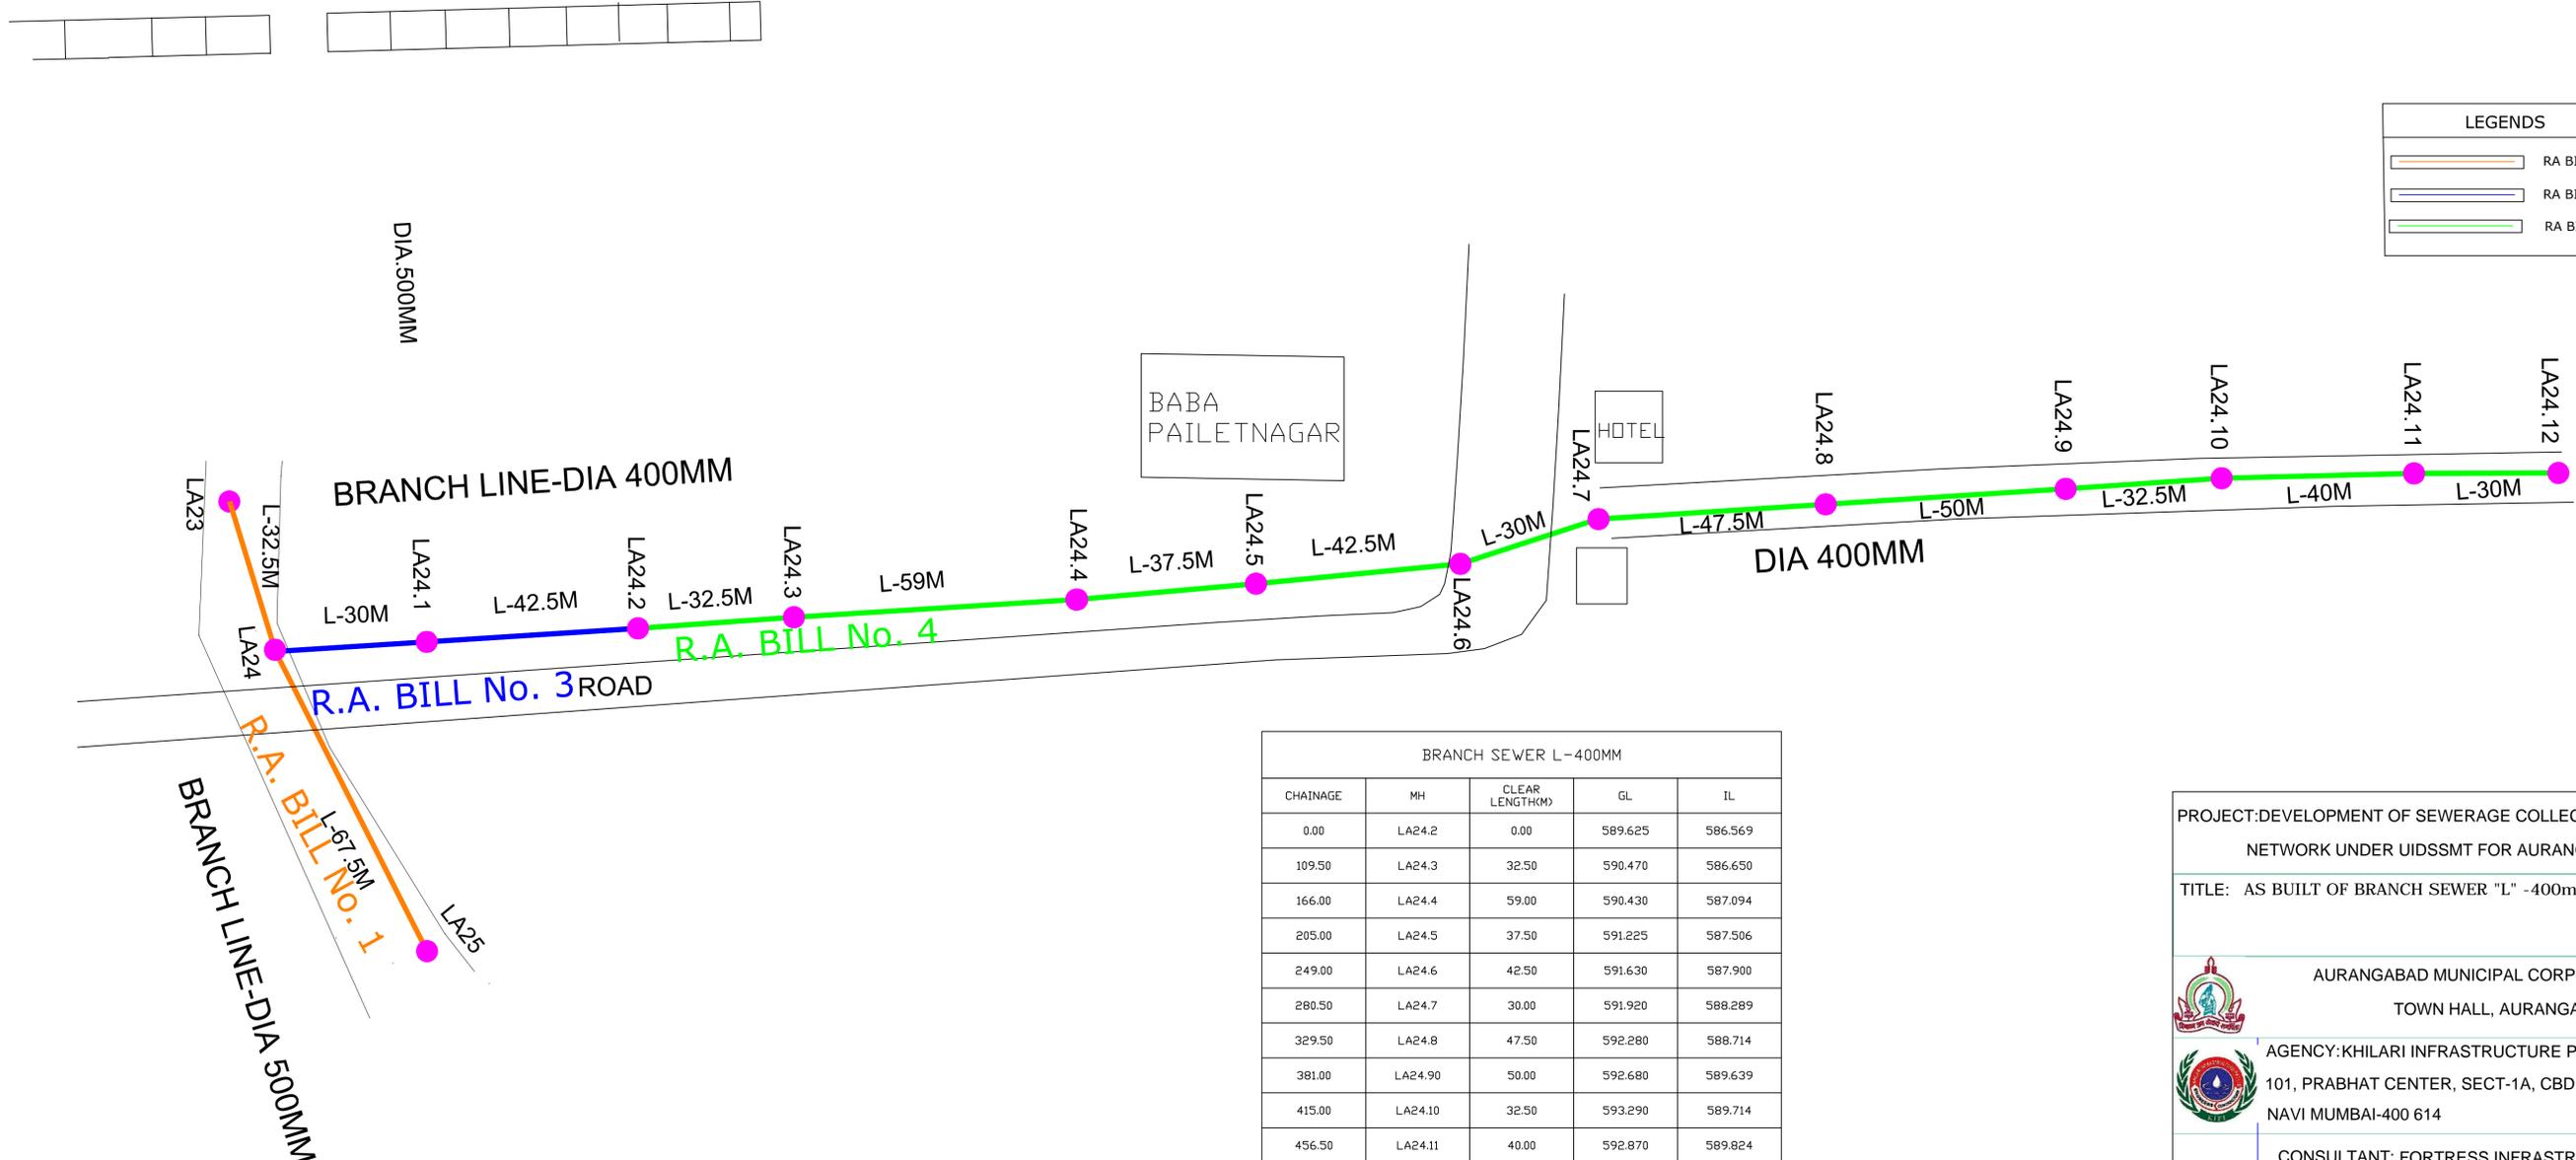

BRANCH SEWER L-400MM				
CHAINAGE	MH	CLEAR LENGTH(M)	GL	IL
0.00	LA24.2	0.00	589.625	586.569
109.50	LA24.3	32.50	590.470	586.650
166.00	LA24.4	59.00	590.430	587.094
205.00	LA24.5	37.50	591.225	587.506
249.00	LA24.6	42.50	591.630	587.900
280.50	LA24.7	30.00	591.920	588.289
329.50	LA24.8	47.50	592.280	588.714
381.00	LA24.90	50.00	592.680	589.639
415.00	LA24.10	32.50	593.290	589.714
456.50	LA24.11	40.00	592.870	589.824
488.00	LA24.12	30.00	592.730	589.899

SCALE 1:1000

PROJECT: DEVELOPMENT OF SEWERAGE COLLECTION NETWORK UNDER UIDSSMT FOR AURANGABAD CITY

TITLE: AS BUILT OF BRANCH SEWER "L" -400mm


 AURANGABAD MUNICIPAL CORPORATION,
TOWN HALL, AURANGABAD

 AGENCY: KHILARI INFRASTRUCTURE PVT. LTD.
101, PRABHAT CENTER, SECT-1A, CBD, BELAPUR,
NAVI MUMBAI-400 614

CONSULTANT: FORTRESS INFRASTRUCTURE ADVISORY SERVICES,

AS BUILT DRAWING OF BRANCH SEWER "L" AT RAJNAGAR NEAR RAILWAY TRACK RA BILL-4

TO JALNA RLY STATION RAILWAY TRACK TO AURANGABAD RLY STATION

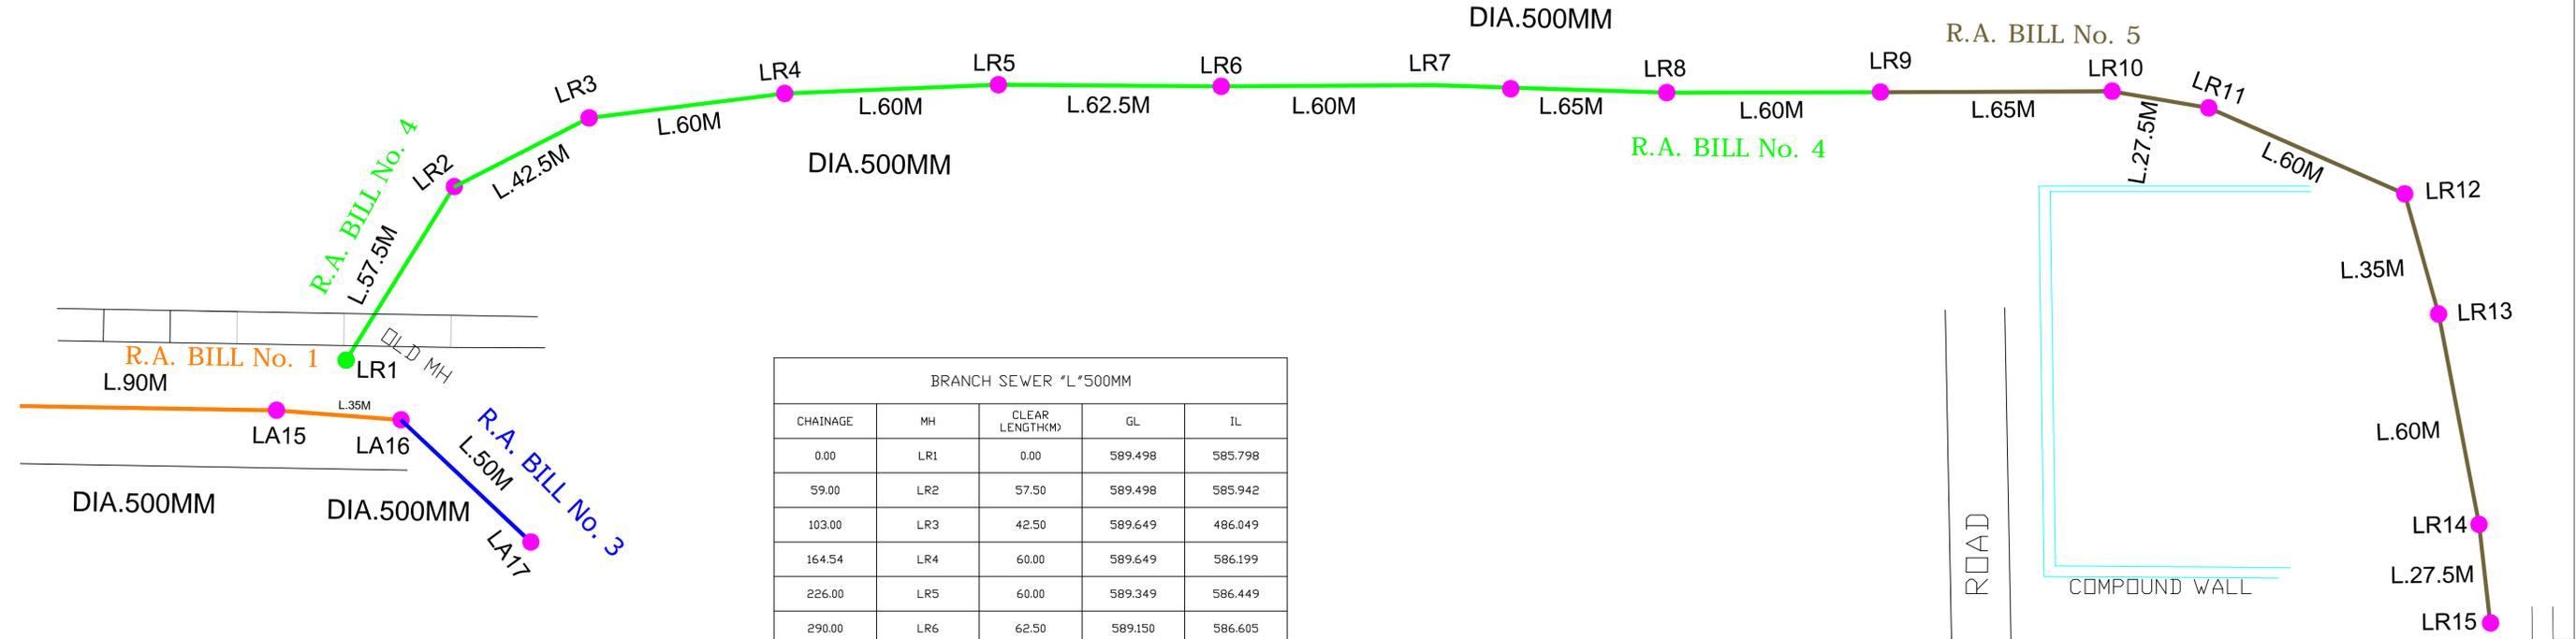

BRANCH SEWER "L" 500MM				
CHAINAGE	MH	CLEAR LENGTH(M)	GL	IL
0.00	LR1	0.00	589.498	585.798
59.00	LR2	57.50	589.498	585.942
103.00	LR3	42.50	589.649	486.049
164.54	LR4	60.00	589.649	586.199
226.00	LR5	60.00	589.349	586.449
290.00	LR6	62.50	589.150	586.605
351.50	LR7	60.00	589.670	586.761
418.00	LR8	65.00	589.650	586.920
479.50	LR9	60.00	590.750	587.000
545.70	LR10	65.00	590.680	587.230
574.40	LR11	27.50	590.650	587.300
635.60	LR12	60.00	590.780	587.430
671.80	LR13	35.00	591.012	587.612
733.00	LR14	60.00	591.037	588.087
761.70	LR15	27.50	592.000	588.155

LEGENDS	
	RA BILL - 1
	RA BILL - 2
	RA BILL - 3
	RA BILL - 4
	RA BILL - 5

PROJECT: DEVELOPMENT OF SEWERAGE COLLECTION NETWORK UNDER UIDSSMT FOR AURANGABAD CITY


TITLE: AS BUILT OF BRANCH SEWER "L"-500MM DIA AT RAJNAGAR NEAR RAILWAY TRACK

AURANGABAD MUNICIPAL CORPORATION, TOWN HALL, AURANGABAD


AGENCY: KHILARI INFRASTRUCTURE PVT. LTD.
101, PRABHAT CENTER, SECT-1A, CBD, BELAPUR, NAVI MUMBAI-400 614

CONSULTANT: FORTRESS INFRASTRUCTURE ADVISORY SERVICES.

SCALE 1:1000

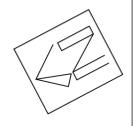

AS BUILT DRAWING OF MAIN SEWER "L" AMBIKA NAGAR RA BILL-6

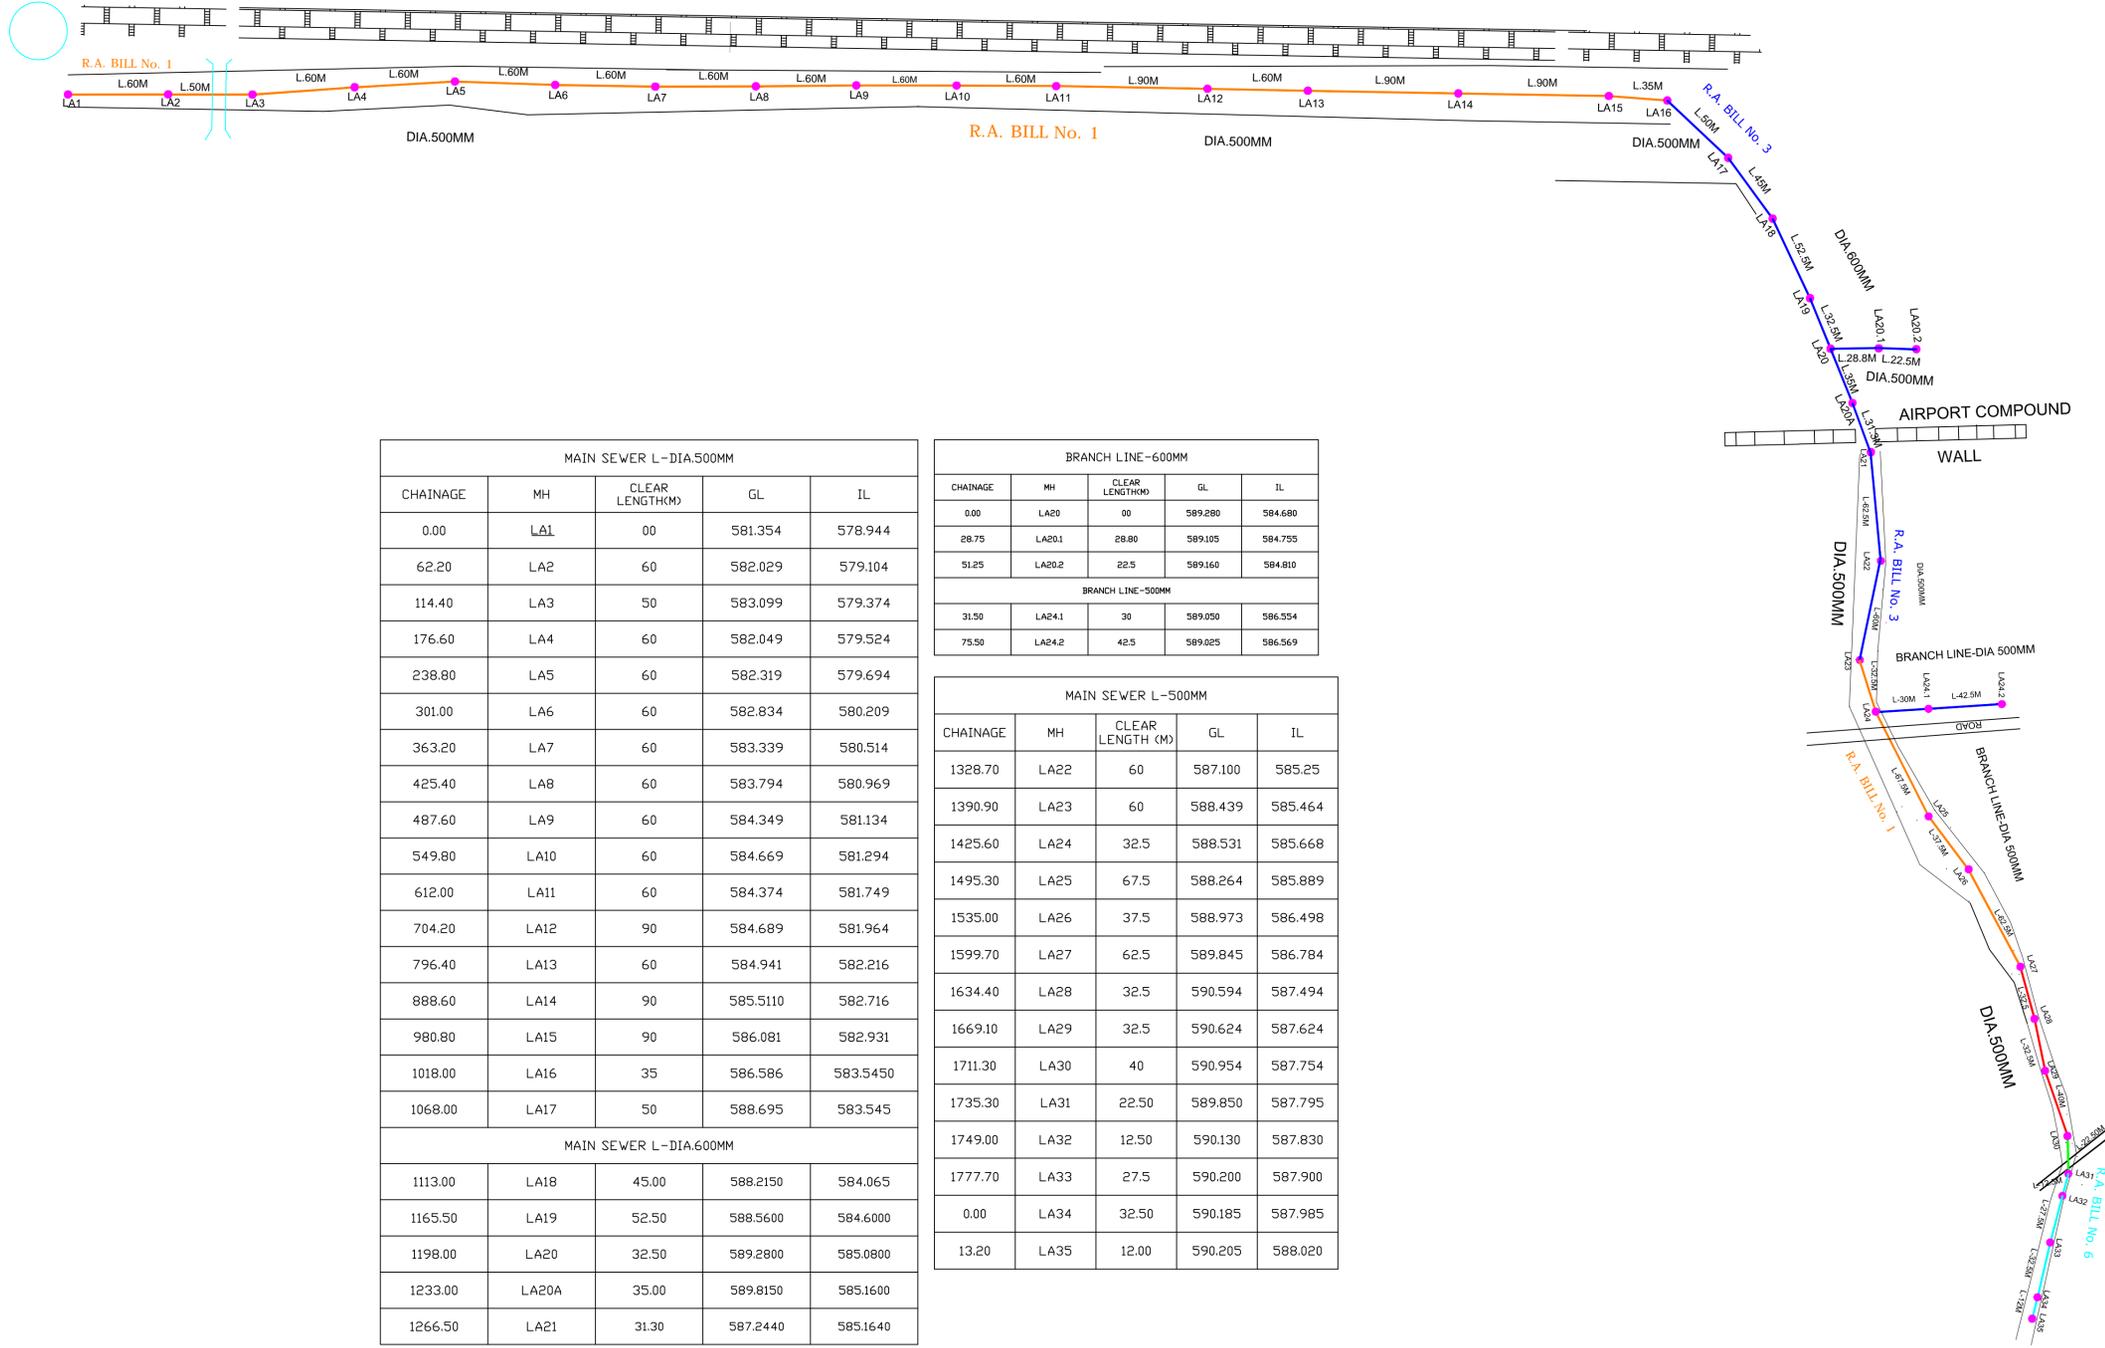

MAIN SEWER L-DIA.500MM				
CHAINAGE	MH	CLEAR LENGTH(M)	GL	IL
0.00	LA1	00	581.354	578.944
62.20	LA2	60	582.029	579.104
114.40	LA3	50	583.099	579.374
176.60	LA4	60	582.049	579.524
238.80	LA5	60	582.319	579.694
301.00	LA6	60	582.834	580.209
363.20	LA7	60	583.339	580.514
425.40	LA8	60	583.794	580.969
487.60	LA9	60	584.349	581.134
549.80	LA10	60	584.669	581.294
612.00	LA11	60	584.374	581.749
704.20	LA12	90	584.689	581.964
796.40	LA13	60	584.941	582.216
888.60	LA14	90	585.5110	582.716
980.80	LA15	90	586.081	582.931
1018.00	LA16	35	586.586	583.5450
1068.00	LA17	50	588.695	583.545
MAIN SEWER L-DIA.600MM				
1113.00	LA18	45.00	588.2150	584.065
1165.50	LA19	52.50	588.5600	584.6000
1198.00	LA20	32.50	589.2800	585.0800
1233.00	LA20A	35.00	589.8150	585.1600
1266.50	LA21	31.30	587.2440	585.1640

BRANCH LINE-600MM				
CHAINAGE	MH	CLEAR LENGTH(M)	GL	IL
0.00	LA20	00	589.280	584.680
28.75	LA20.1	28.80	589.105	584.755
51.25	LA20.2	22.5	589.160	584.810
BRANCH LINE-500MM				
31.50	LA24.1	30	589.050	586.554
75.50	LA24.2	42.5	589.025	586.569

MAIN SEWER L-500MM				
CHAINAGE	MH	CLEAR LENGTH (M)	GL	IL
1328.70	LA22	60	587.100	585.25
1390.90	LA23	60	588.439	585.464
1425.60	LA24	32.5	588.531	585.668
1495.30	LA25	67.5	588.264	585.889
1535.00	LA26	37.5	588.973	586.498
1599.70	LA27	62.5	589.845	586.784
1634.40	LA28	32.5	590.594	587.494
1669.10	LA29	32.5	590.624	587.624
1711.30	LA30	40	590.954	587.754
1735.30	LA31	22.50	589.850	587.795
1749.00	LA32	12.50	590.130	587.830
1777.70	LA33	27.5	590.200	587.900
0.00	LA34	32.50	590.185	587.985
13.20	LA35	12.00	590.205	588.020

LEGENDS	
	RA BILL 1
	RA BILL 2
	RA BILL 3
	RA BILL 4
	RA BILL 6

SCALE 1:1000

PROJECT: DEVELOPMENT OF SEWERAGE COLLECTION NETWORK UNDER UIDSSMT FOR AURANGABAD CITY


TITLE: AS BUILT OF SEWER "L" -500mm

AURANGABAD MUNICIPAL CORPORATION, TOWN HALL, AURANGABAD

AGENCY: KHILARI INFRASTRUCTURE PVT. LTD. 101, PRABHAT CENTER, SECT-1A, CBD, BELAPUR, NAVI MUMBAI-400 614

CONSULTANT: FORTRESS INFRASTRUCTURE ADVISORY SERVICES,

AS BUILT DRAWING OF MAIN SEWER "M" FROM JADHAVWADI TO MAYUR PARK RA BILL-5

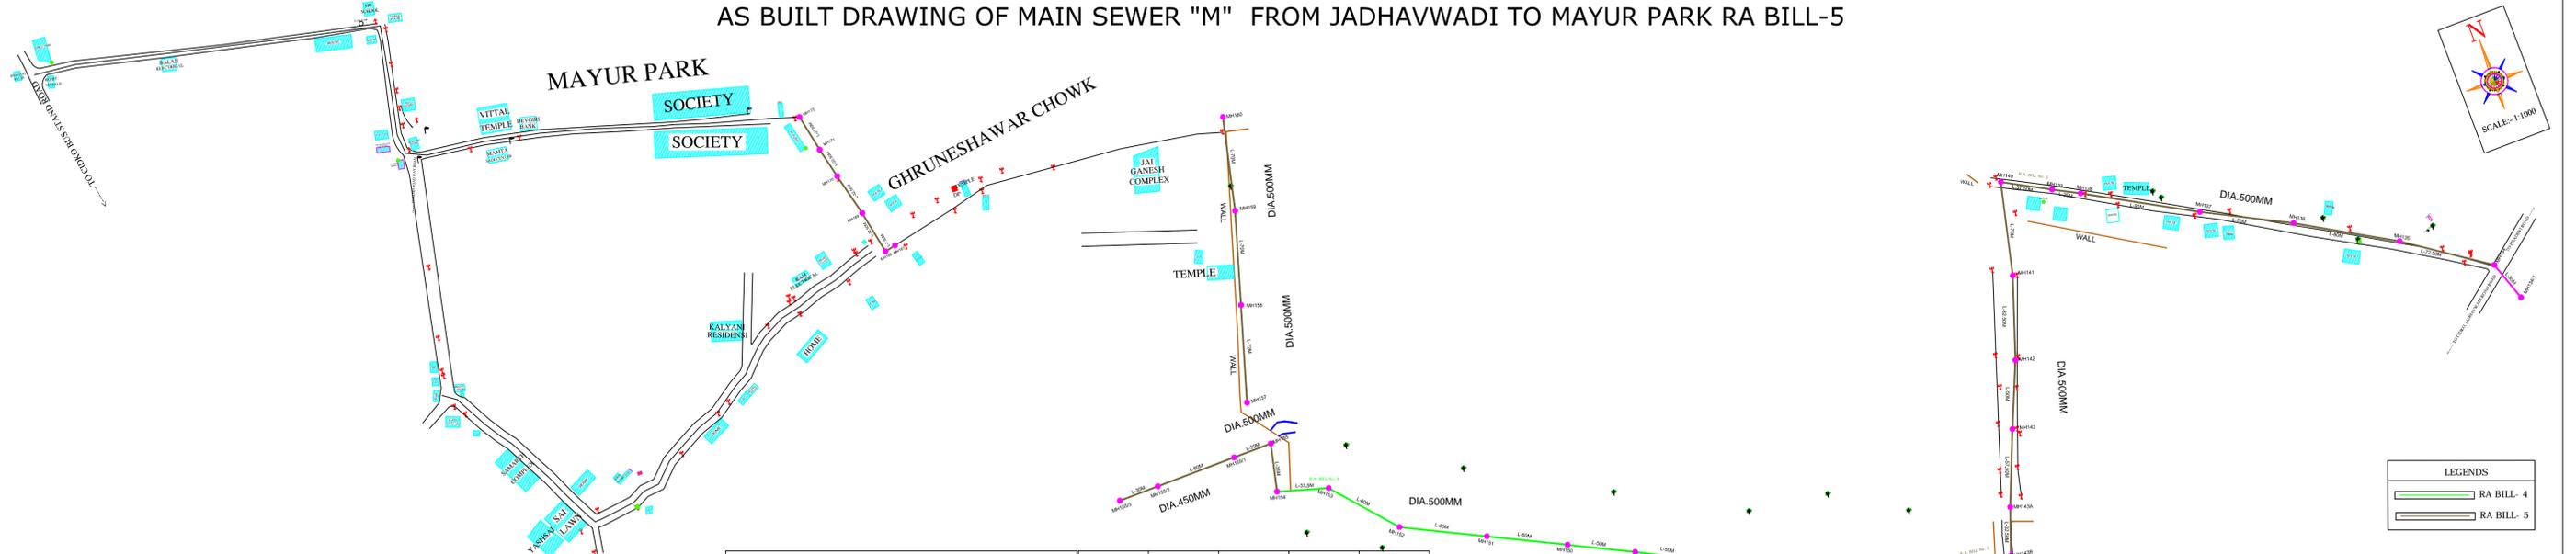

BRANCH SEWER "M" 500MM AND 400MM				
CHAINAGE	MH	CLEAR LENGTH(M)	GL	IL
8682.50	MH134		595.896	591.62
8757.00	MH135	72.50	596.131	591.72
8839.00	MH136	80.00	596.131	591.81
8911.00	MH137	70.00	596.556	591.93
9003.00	MH138	90.00	596.516	592.11
9025.00	MH139	20.00	596.816	592.30
9064.50	MH140	37.50	596.586	592.50
9136.50	MH141	70.00	596.536	592.65
9201.00	MH142	62.50	597.036	592.68
9253.00	MH143	50.00	596.721	592.71
9312.50	MH143A	57.50	596.506	592.75
9347.00	MH143B	32.50	596.481	592.79
9389.00	MH144	40.00	595.835	592.84
9424.00	MH145	35.00	595.94	592.94
9469.00	MH146	45.00	596.050	593.05
9519.00	MH147	50.00	596.155	593.16
9569.00	MH148	50.00	596.275	593.275
9619.00	MH149	50.00	596.315	593.315
9669.00	MH150	50.00	596.450	593.450
9729.00	MH151	60.00	596.540	593.540
9794.00	MH152	65.0000	597.320	593.720
9854.00	MH153	60.00	597.130	593.930
9891.50	MH154	37.50	598.550	594.150
9928.50	MH155	35.00	598.226	594.484
9963.50	MH156		598.860	594.850
10038.00	MH157	72.50	599.734	594.994
10110.00	MH158	70.00	600.104	595.224
10182.00	MH159	70.00	599.974	595.345
10482.00	MH167		600.517	596.277
10491.50	MH168	7.50	600.677	596.307
10526.00	MH169	32.50	600.917	596.617
10560.50	MH170	32.50	601.797	596.957
10585.00	MH171	22.50	601.747	597.207
10614.50	MH172	27.50	602.297	597.452

BRANCH SEWER "M" 300MM AND 450MM				
CHAINAGE	MH	CLEAR LENGTH(M)	GL	IL
00.00	MH134	00.00	595.896	594.561
31.20	MH134/1	30.00	596.251	594.571
0.0000	MH155	00.00	598.226	594.984
31.50	MH155/1	30.0000	598.376	595.434
93.00	MH155/2	60.00	598.636	595.674
124.50	MH155/3	30.00	598.686	595.674

LEGENDS

- RA BILL- 4
- RA BILL- 5

PROJECT: DEVELOPMENT OF SEWERAGE COLLECTION NETWORK UNDER UIDSSMT FOR AURANGABAD CITY

TITLE: AS BUILT OF MAIN SEWER "M"



AURANGABAD MUNICIPAL CORPORATION,
TOWN HALL, AURANGABAD

AGENCY: KHILARI INFRASTRUCTURE PVT. LTD.
101, PRABHAT CENTER, SECT-1A, CBD, BELAPUR,
NAVI MUMBAI-400 614

CONSULTANT: FORTRESS INFRASTRUCTURE ADVISORY SERVICES.

SCALE 1:1000

AS BUILT DRAWING OF BRANCH SEWER "M" RAMANAGAR RA BILL -4

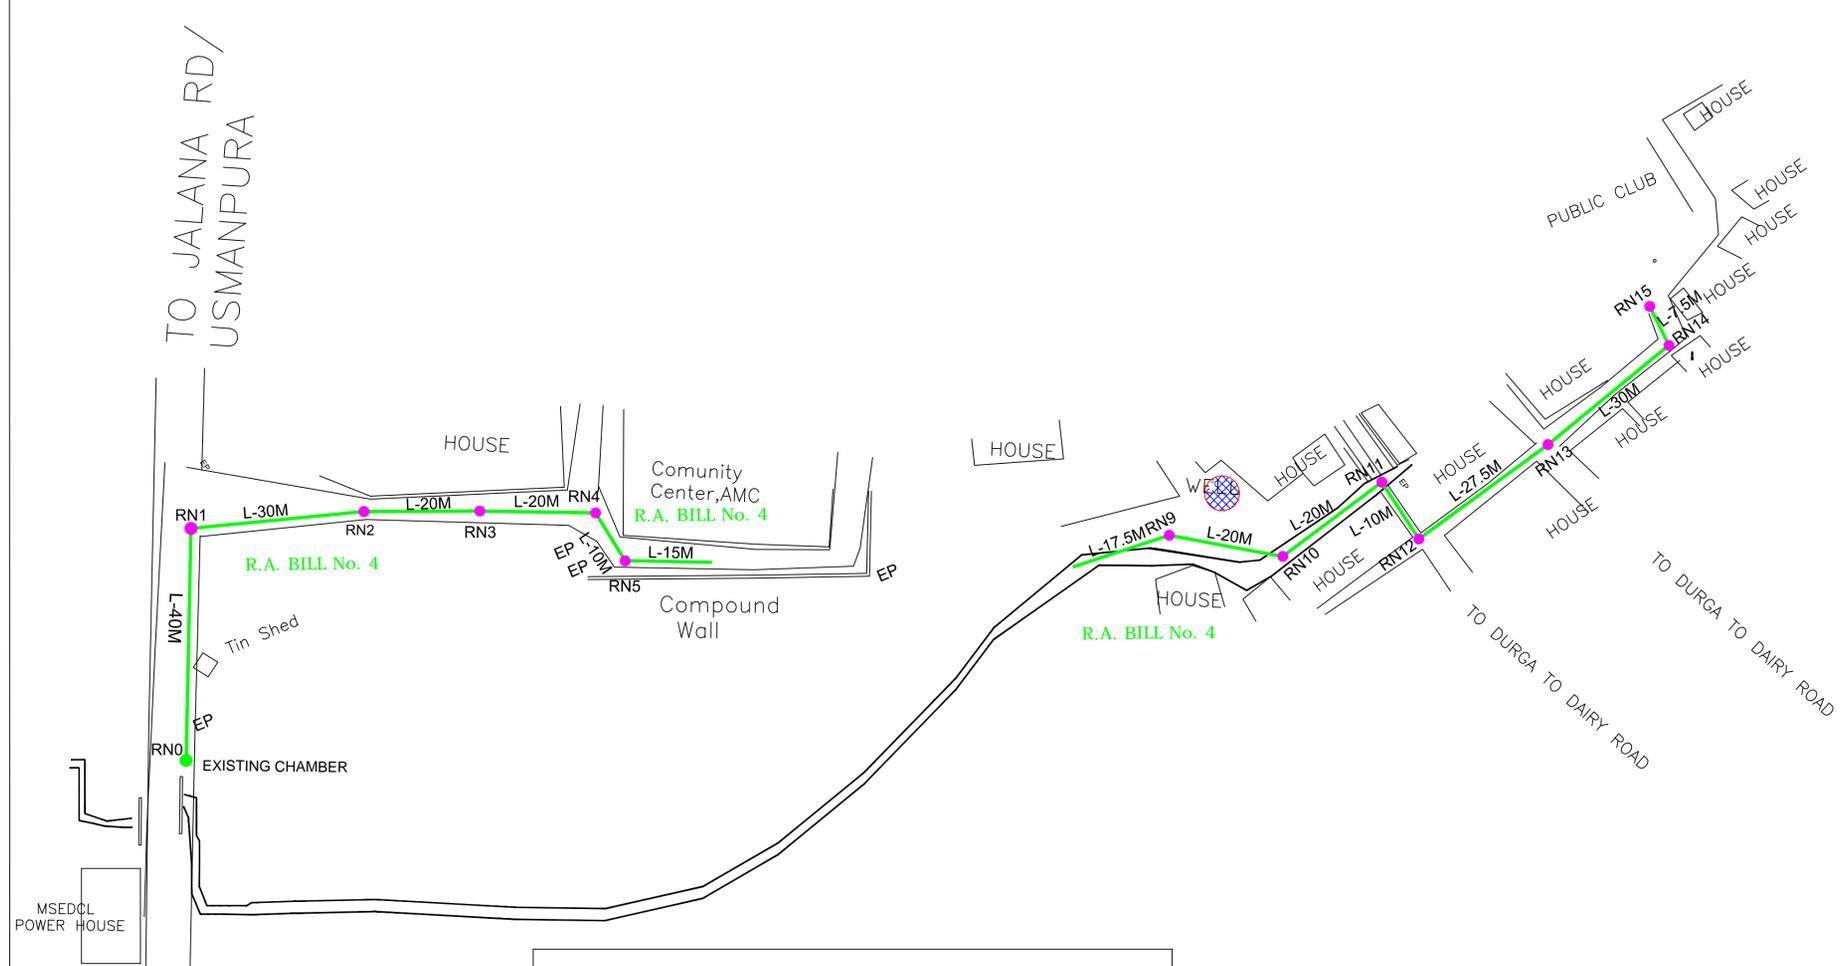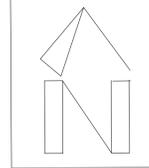

LEGENDS	
	RA BILL- 4

BRANCH SEWER "M" DIA,400MM				
CHAINAGE	MH	CLEAR LENGTH(M)	GL	IL
0.00	RN0	0.00	576.825	575.200
41.50	RN1	40.00	577.950	575.300
73.00	RN2	30.00	577.915	575.375
94.5	RN3	20.00	578.310	575.725
116.00	RN4	20.00	578.555	575.775
27.0	RN5	10.00	578.610	576.100
228.25	RN9	17.50	579.765	578.170
249.75	RN10	20	579.875	578.425
276.25	RN11	25.00	580.265	578.785
287.75	RN12	10	580.815	579.115
316.75	RN13	27.50	581.510	579.495
348.25	RN14	30.00	581.670	579.880
357.25	RN15	7.50	581.880	579.900

PROJECT:DEVELOPMENT OF SEWERAGE COLLECTION NETWORK UNDER UIDSSMT FOR AURANGABAD CITY

TITLE:AS BUILT DRAWING OF BRANCH SEWER " M"


AURANGABAD MUNICIPAL CORPORATION,
TOWN HALL, AURANGABAD

AGENCY:KHILARI INFRASTRUCTURE PVT. LTD.
101, PRABHAT CENTER, SECT-1A, CBD, BELAPUR,
NAVI MUMBAI-400 614


CONSULTANT: FORTRESS INFRASTRUCTURE ADVISORY SERVICES, MARINE LINES, MUMBAI-2

SCALE 1:1000


AS BUILT DRAWING OF BRANCH SEWER "M" BRIJWADI RA BILL-6

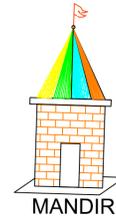

ROAD

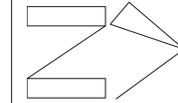

LEGENDS	
	RA BILL- 4
	RA BILL- 6

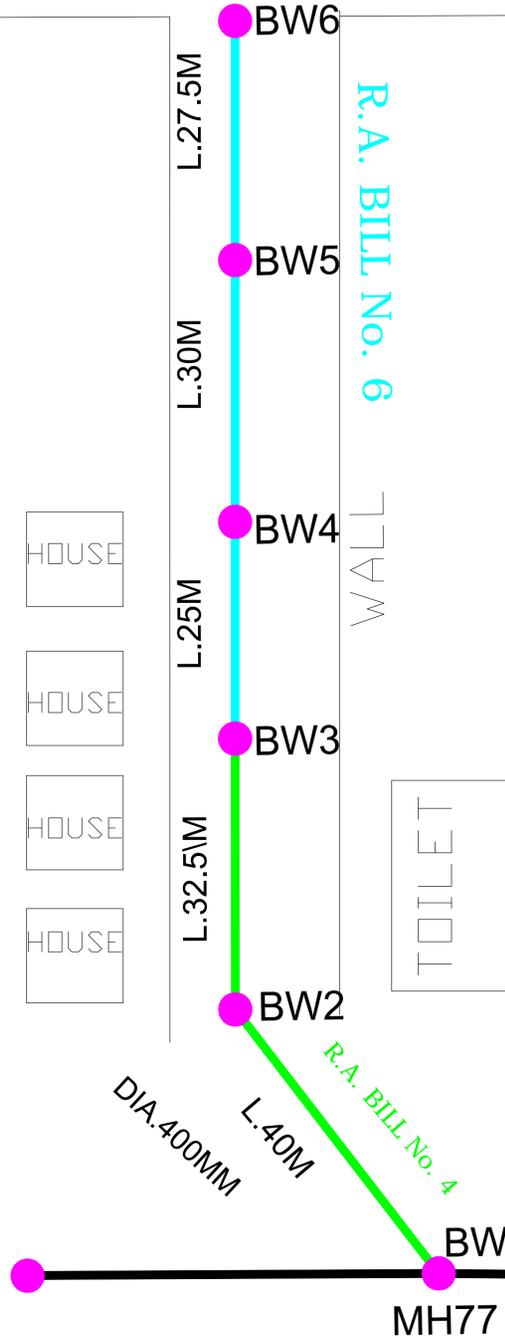

BRANCH SEWER 'M' (BRIJWADI) DIA 400MM				
CHAINAGE	MH	CLEAR LENGTH(M)	GL	IL
25.00	BW1	0.00	581.080	578.510
66.50	BW2	40.00	581.465	578.910
100.50	BW3	35.00	582.035	579.790
126.50	BW4	25.00	583.890	580.840
157.90	BW5	30.00	584.050	580.200
186.60	BW6	27.50	584.400	580.550

PROJECT:DEVELOPMENT OF SEWERAGE COLLECTION NETWORK UNDER UIDSSMT FOR AURANGABAD CITY
TITLE: AS BUILT OF BRANCH SEWER "M" DIA-400mm





AURANGABAD MUNICIPAL CORPORATION,
TOWN HALL, AURANGABAD



AGENCY:KHILARI INFRASTRUCTURE PVT. LTD.
101, PRABHAT CENTER, SECT-1A, CBD, BELAPUR,
NAVI MUMBAI-400 614

CONSULTANT: FORTRESS INFRASTRUCTURE ADVISORY SERVICES,

AS BUILT DRAWING OF MAIN SEWER WARD NO-98 RA BILL -4

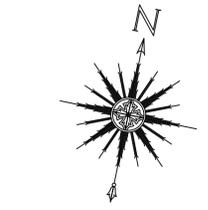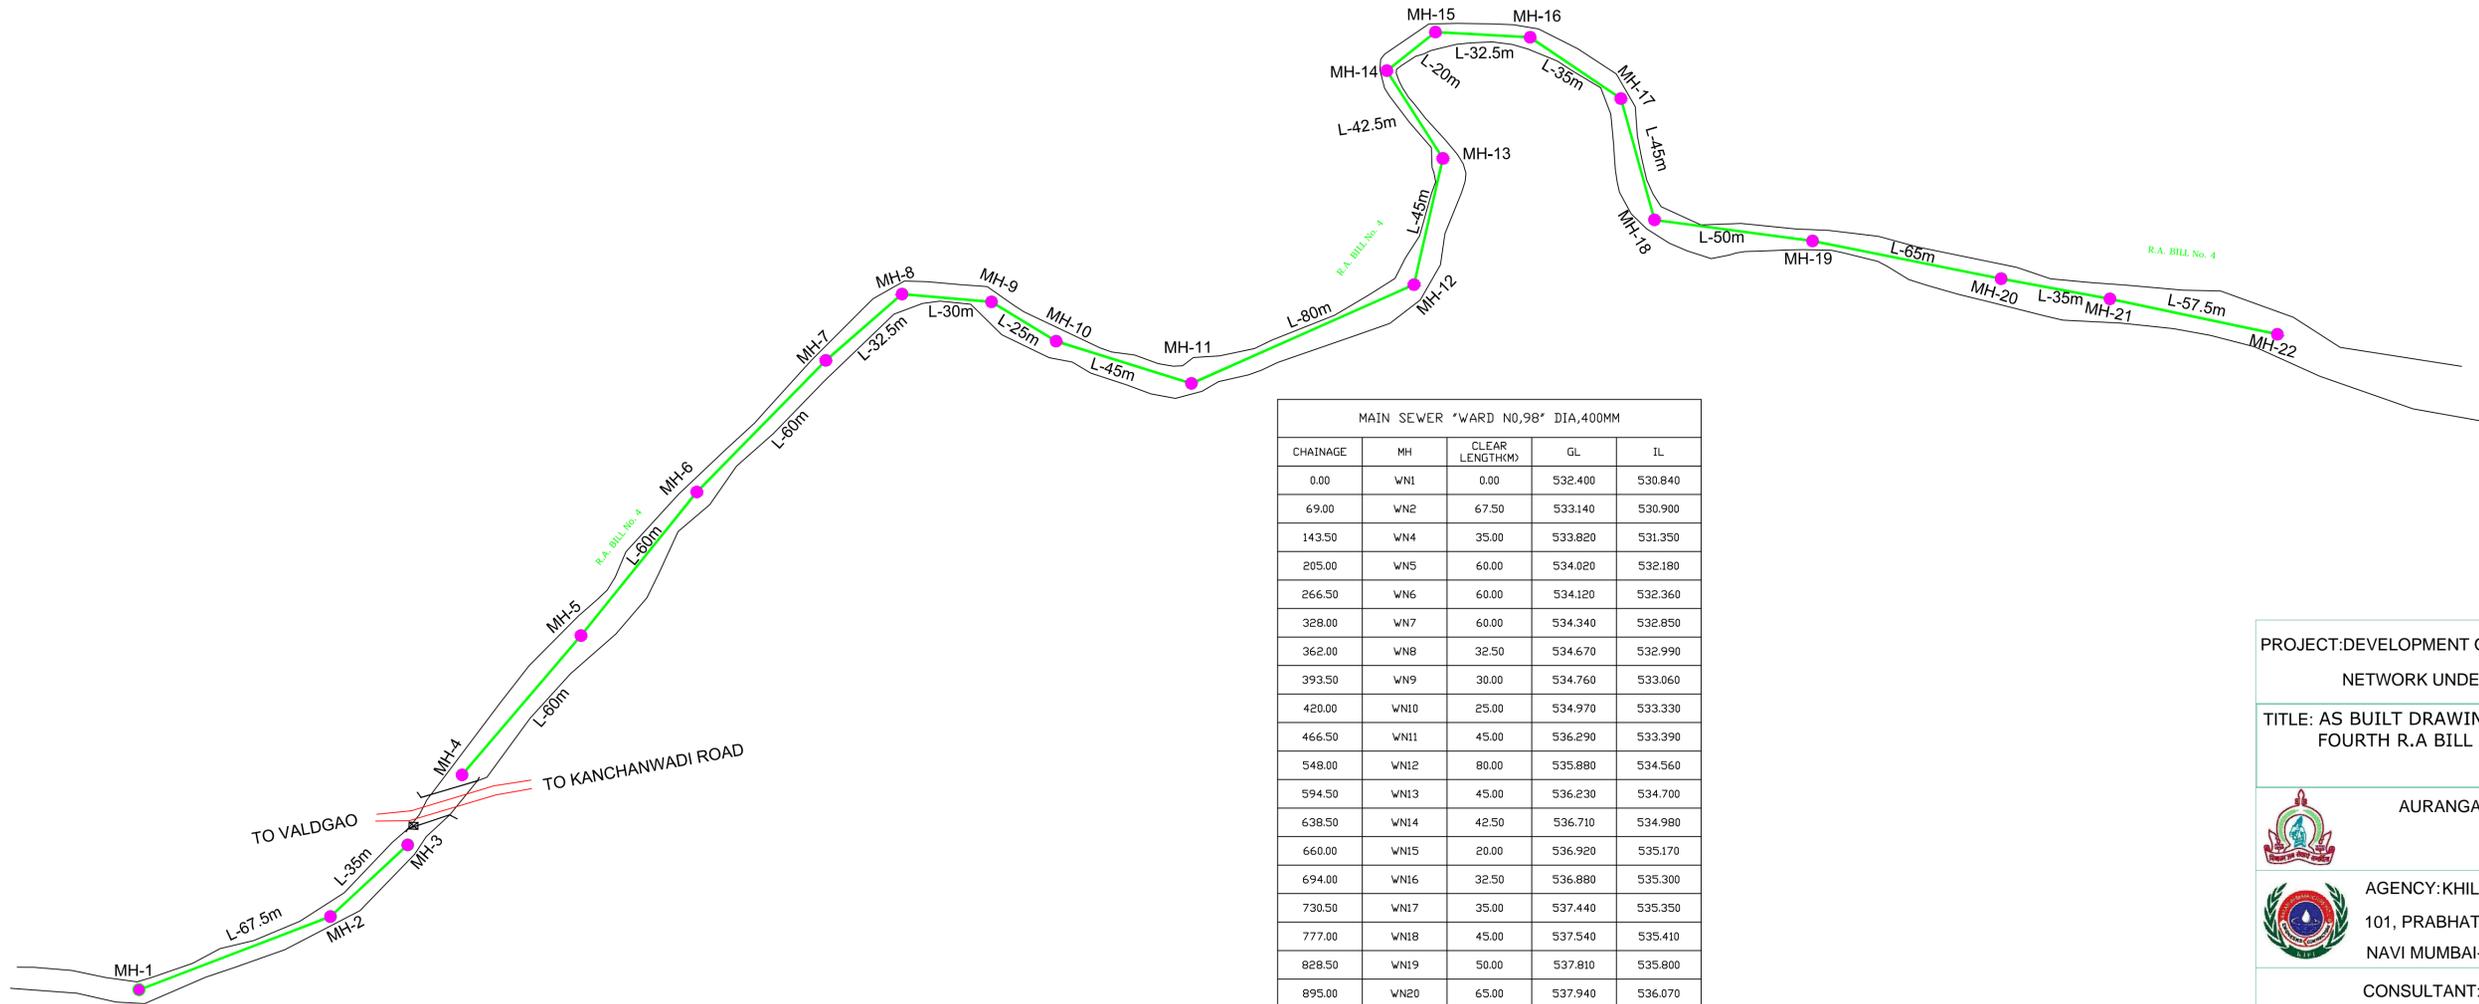

LEGENDS	
—	RA BILL - 4

MAIN SEWER "WARD NO,98" DIA,400MM				
CHAINAGE	MH	CLEAR LENGTH(M)	GL	IL
0.00	WN1	0.00	532.400	530.840
69.00	WN2	67.50	533.140	530.900
143.50	WN4	35.00	533.820	531.350
205.00	WN5	60.00	534.020	532.180
266.50	WN6	60.00	534.120	532.360
328.00	WN7	60.00	534.340	532.850
362.00	WN8	32.50	534.670	532.990
393.50	WN9	30.00	534.760	533.060
420.00	WN10	25.00	534.970	533.330
466.50	WN11	45.00	536.290	533.390
548.00	WN12	80.00	535.880	534.560
594.50	WN13	45.00	536.230	534.700
638.50	WN14	42.50	536.710	534.980
660.00	WN15	20.00	536.920	535.170
694.00	WN16	32.50	536.880	535.300
730.50	WN17	35.00	537.440	535.350
777.00	WN18	45.00	537.540	535.410
828.50	WN19	50.00	537.810	535.800
895.00	WN20	65.00	537.940	536.070
931.50	WN21	35.00	538.230	536.300
990.50	WN22	57.50	538.430	536.620

PROJECT:DEVELOPMENT OF SEWERAGE COLLECTION NETWORK UNDER UIDSSMT FOR AURANGABAD CITY
 TITLE: AS BUILT DRAWING OF MAIN SEWER WARD NO-98 FOURTH R.A BILL

 AURANGABAD MUNICIPAL CORPORATION,
 TOWN HALL, AURANGABAD


 AGENCY:KHILARI INFRASTRUCTURE PVT. LTD.
 101, PRABHAT CENTER, SECT-1A, CBD, BELAPUR, NAVI MUMBAI-400 614

CONSULTANT: FORTRESS INFRASTRUCTURE ADVISORY SERVICES, MARINE LINES, MUMBAI-2

AS BUILT DRAWING OF MAIN SEWER "WARD NO.98" NEAR STP PART-I AS BUILT RA BILL-6



SCALE:- 1:1000

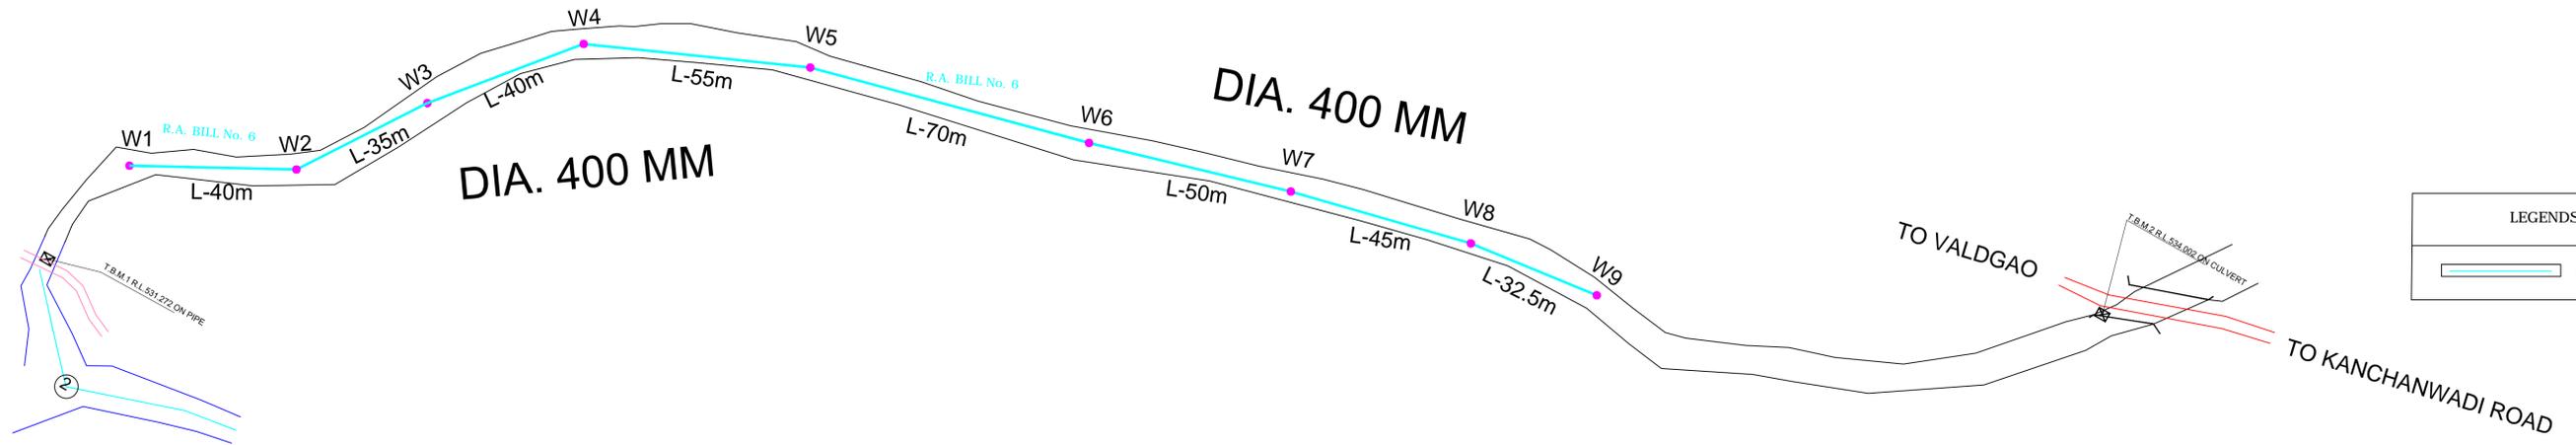

MAIN SEWER WARD-98 (NEAR STP PART-I) DIA 400MM				
CHAINAGE	MH	CLEAR LENGTH(M)	GL	IL
30.00	w1	0.00	531.172	529.190
71.20	w2	40.00	531.652	529.290
107.40	w3	35.00	531.800	529.370
148.60	w4	40.00	531.700	529.430
204.80	w5	55.00	532.350	529.540
276.00	w6	70.00	531.920	529.875
327.20	w7	50.00	531.980	530.050
373.40	w8	45.00	531.860	530.125
407.10	w9	32.50	532.400	530.290

PROJECT:DEVELOPMENT OF SEWERAGE COLLECTION NETWORK UNDER UIDSSMT FOR AURANGABAD CITY

TITLE: AS BUILT OF MAIN SEWER "WARD NO.98" (NEAR STP PART- I) SIXTH R.A BILL.





AURANGABAD MUNICIPAL CORPORATION,
TOWN HALL, AURANGABAD



AGENCY:KHILARI INFRASTRUCTURE PVT. LTD.
101, PRABHAT CENTER, SECT-1A, CBD, BELAPUR,
NAVI MUMBAI-400 614

CONSULTANT: FORTRESS INFRASTRUCTURE ADVISORY SERVICES, MARINE LINES, MUMBAI-2

AS BUILT DRAWING OF MAIN SEWER "WARD NO.98"(HINDUSTAN AVAS PART-II) RA BILL-6

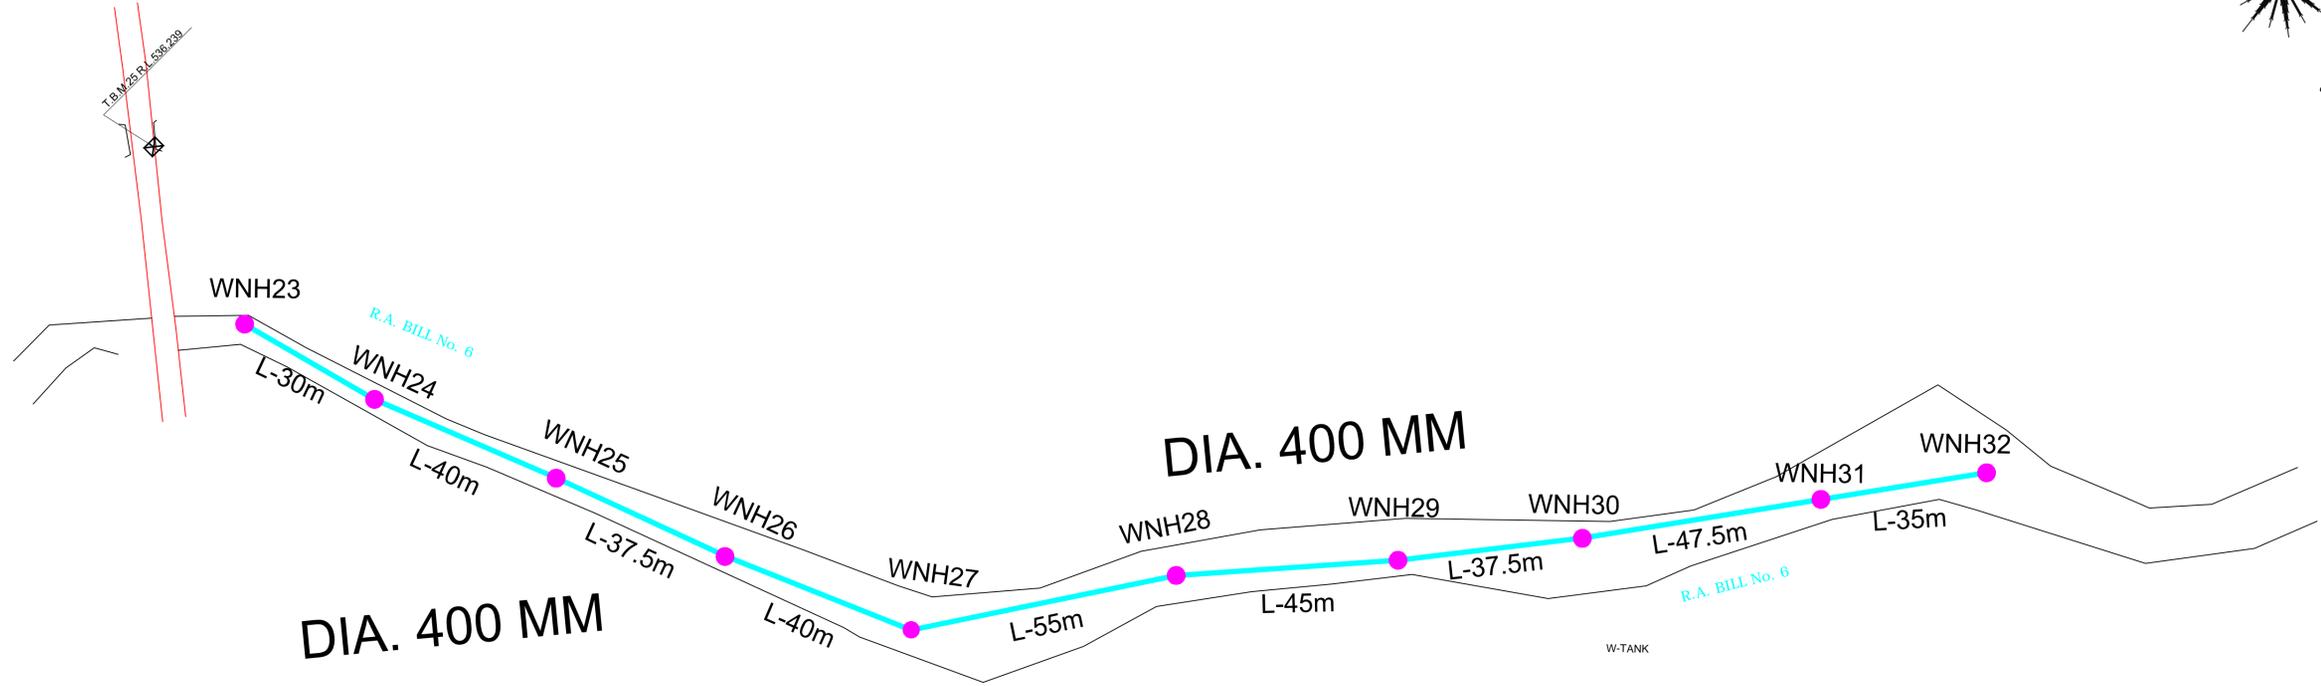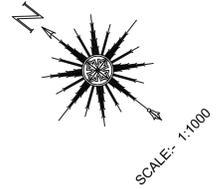

LEGENDS	
	RA BILL - 6

MAIN SEWER WARD-98 (HINDUSTAN AVAS PART-II) DIA 400MM				
CHAINAGE	MH	CLEAR LENGTH(M)	GL	IL
978.40	WNH23	0.00	535.345	533.210
1009.60	WNH24	30.00	535.505	533.330
1050.80	WNH25	40.00	535.885	533.515
1089.50	WNH26	37.50	536.060	533.630
1130.70	WNH27	40.00	536.385	533.710
1186.90	WNH28	55.00	536.190	533.890
1233.10	WNH29	45.00	536.615	534.120
1271.80	WNH30	37.50	536.900	534.470
1320.50	WNH31	47.50	537.380	534.980
1356.70	WNH32	35.00	537.800	535.150

PROJECT:DEVELOPMENT OF SEWERAGE COLLECTION NETWORK UNDER UIDSSMT FOR AURANGABAD CITY
 TITLE: AS BUILT OF MAIN SEWER WARD NO-98 (HINDUSTAN AVAS PART-II) FOR SIXTH R.A BILL.




AURANGABAD MUNICIPAL CORPORATION,
 TOWN HALL, AURANGABAD

AGENCY:KHILARI INFRASTRUCTURE PVT. LTD.
 101, PRABHAT CENTER, SECT-1A, CBD, BELAPUR,
 NAVI MUMBAI-400 614

CONSULTANT: FORTRESS INFRASTRUCTURE
 ADVISORY SERVICES, MARINE LINES, MUMBAI-2

AS BUILT DRAWING OF MAIN SEWER "WARD NO.98" NEAR STP PART III & IV. RA BILL-6

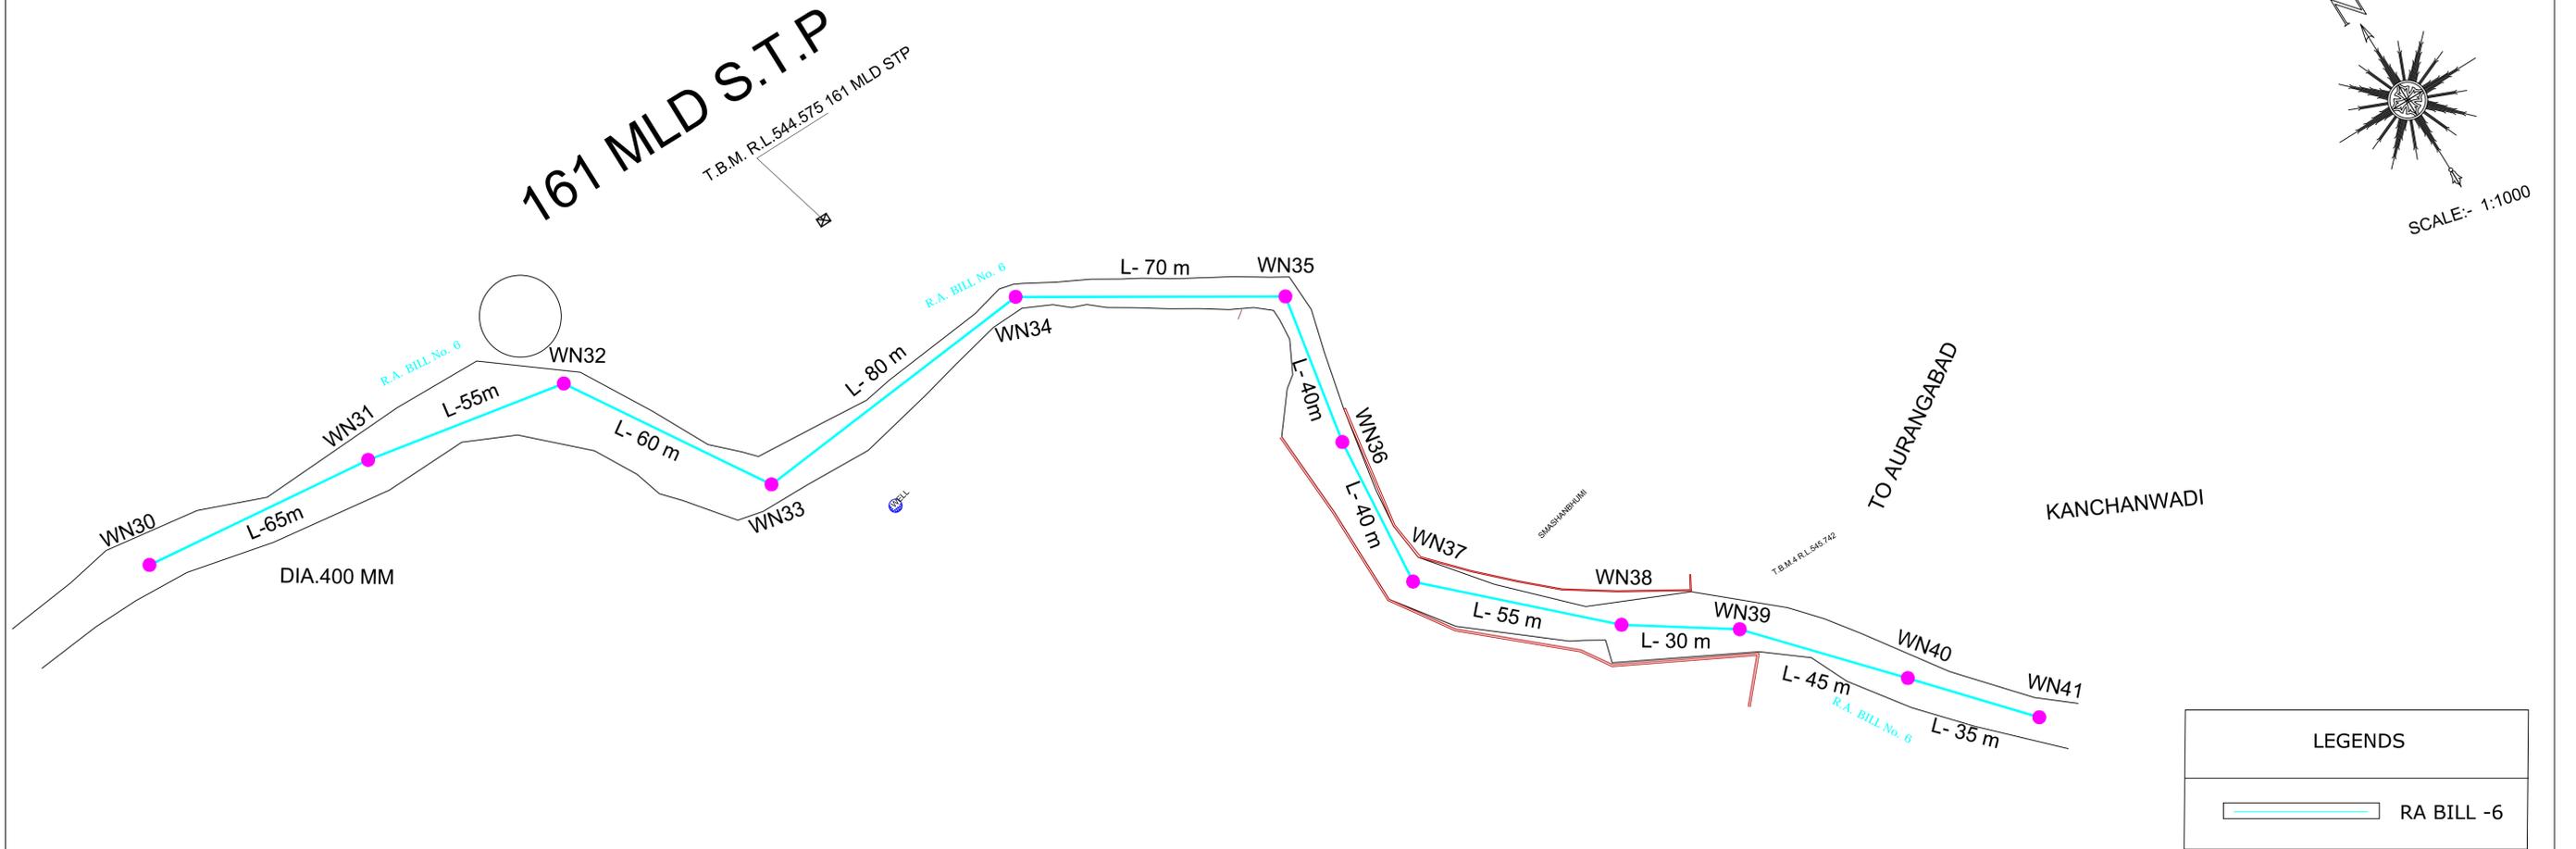

LEGENDS	
	RA BILL -6

MAIN SEWER WARD-98 (NEAR STP PART-III) DIA 400MM				
CHAINAGE	MH	CLEAR LENGTH(M)	GL	IL
1397.60	WN30	0.00	538.430	536.620
1463.80	WN31	65.00	539.600	536.930
1520.00	WN32	55.00	539.910	537.180
1581.20	WN33	60.00	540.690	537.850
1662.40	WN34	80.00	541.210	538.310
1733.60	WN35	70.00	541.690	538.800
1774.80	WN36	40.00	542.110	539.130

MAIN SEWER WARD-98 (NEAR STP PART-IV) DIA 400MM				
CHAINAGE	MH	CLEAR LENGTH(M)	GL	IL
1816.00	WN37	40.00	542.195	539.420
1872.20	WN38	55.00	542.615	539.810
1903.40	WN39	30.00	542.185	539.915
1949.60	WN40	45.00	542.420	540.111
1985.80	WN41	35.00	542.490	540.220

PROJECT:DEVELOPMENT OF SEWERAGE COLLECTION NETWORK UNDER UIDSSMT FOR AURANGABAD CITY

TITLE: AS BUILT OF MAIN SEWER "WARD NO.98" NEAR STP PART- III& IV SIXTH R.A BILL




AURANGABAD MUNICIPAL CORPORATION,
TOWN HALL, AURANGABAD




AGENCY:KHILARI INFRASTRUCTURE PVT. LTD.
101, PRABHAT CENTER, SECT-1A, CBD, BELAPUR,
NAVI MUMBAI-400 614

CONSULTANT: FORTRESS INFRASTRUCTURE
ADVISORY SERVICES, MARINE LINES, MUMBAI-2

AS BUILT DRAWING OF MAIN SEWER "WARD NO.98"(HINDUSTAN AVAS) RA BILL -6

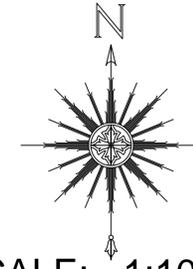

SCALE:- 1:100

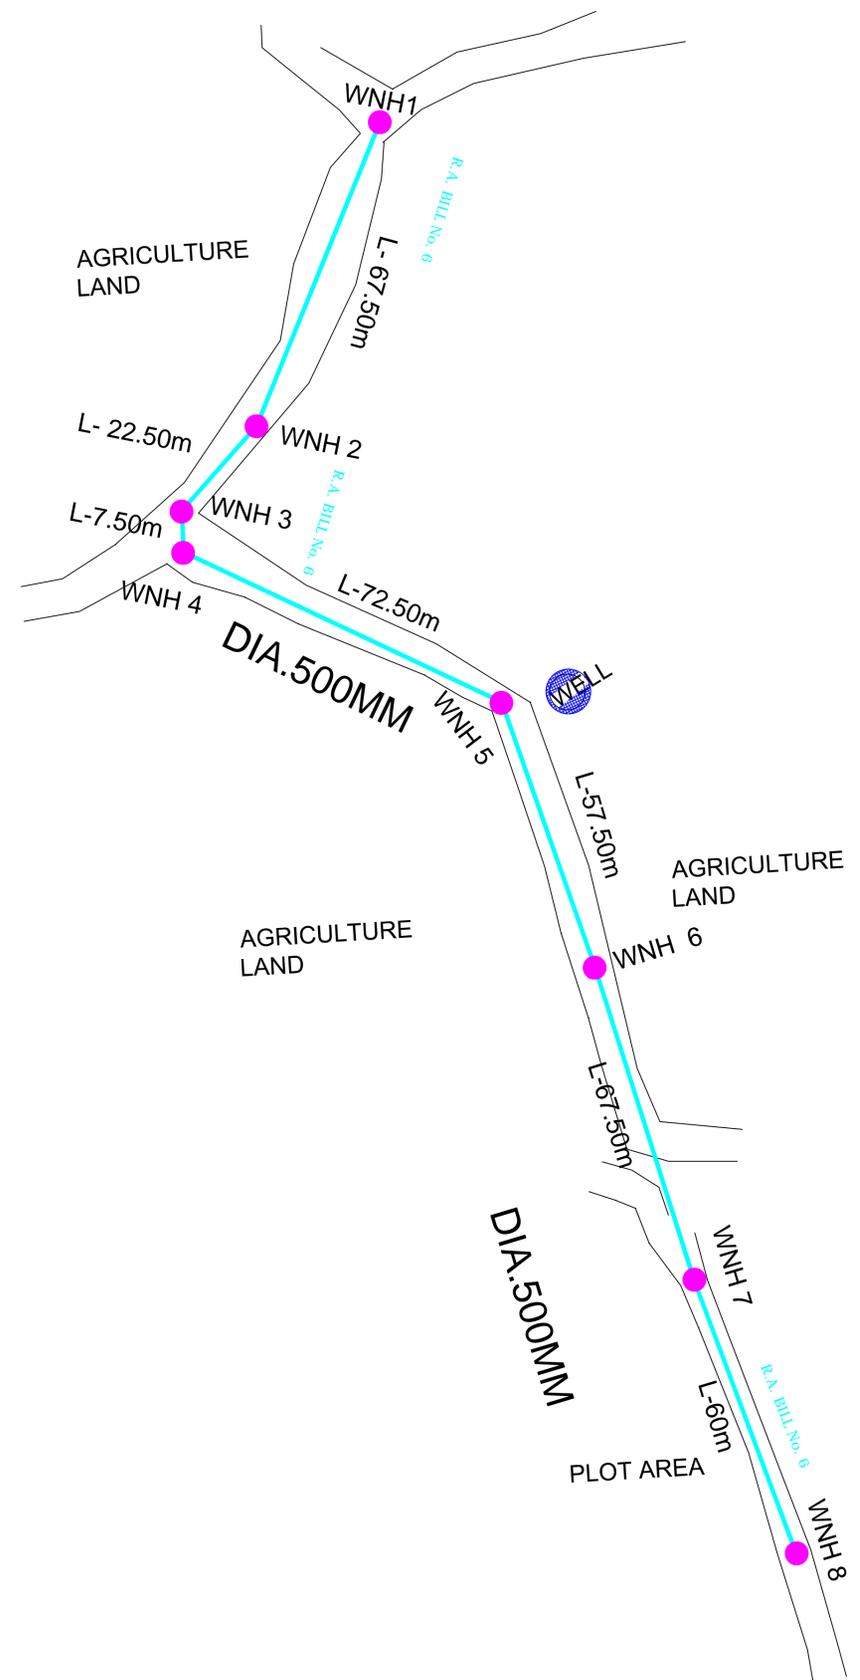

LEGENDS	
	RA BILL -6

MAIN SEWER WARD-98 < HINDUSTAN AVAS > DIA 500MM				
CHAINAGE	MH	CLEAR LENGTH(M)	GL	IL
10.00	WNH 1	0.00	530.662	527.642
78.70	WNH 2	67.50	530.622	527.812
102.40	WNH 3	22.50	530.327	527.922
111.10	WNH 4	7.50	530.547	527.956
184.80	WNH 5	72.50	530.547	528.160
243.50	WNH 6	57.50	531.527	528.347
312.20	WNH 7	67.50	532.517	528.937
373.40	WNH 8	60.00	533.197	529.087

PROJECT:DEVELOPMENT OF SEWERAGE COLLECTION NETWORK UNDER UIDSSMT FOR AURANGABAD CITY

TITLE: AS BUILT OF MAIN SEWER WARD NO-98 (HINDUSTAN AVAS) SIXTH R.A BILL





AURANGABAD MUNICIPAL CORPORATION,
TOWN HALL, AURANGABAD

AGENCY:KHILARI INFRASTRUCTURE PVT. LTD.
101, PRABHAT CENTER, SECT-1A, CBD, BELAPUR,
NAVI MUMBAI-400 614

CONSULTANT: FORTRESS INFRASTRUCTURE
ADVISORY SERVICES, MARINE LINES, MUMBAI-2

AS BUILT DRAWING OF MAIN SEWER "WARD NO.98" (AT WALMI NEAR CSMS) RA BILL-6

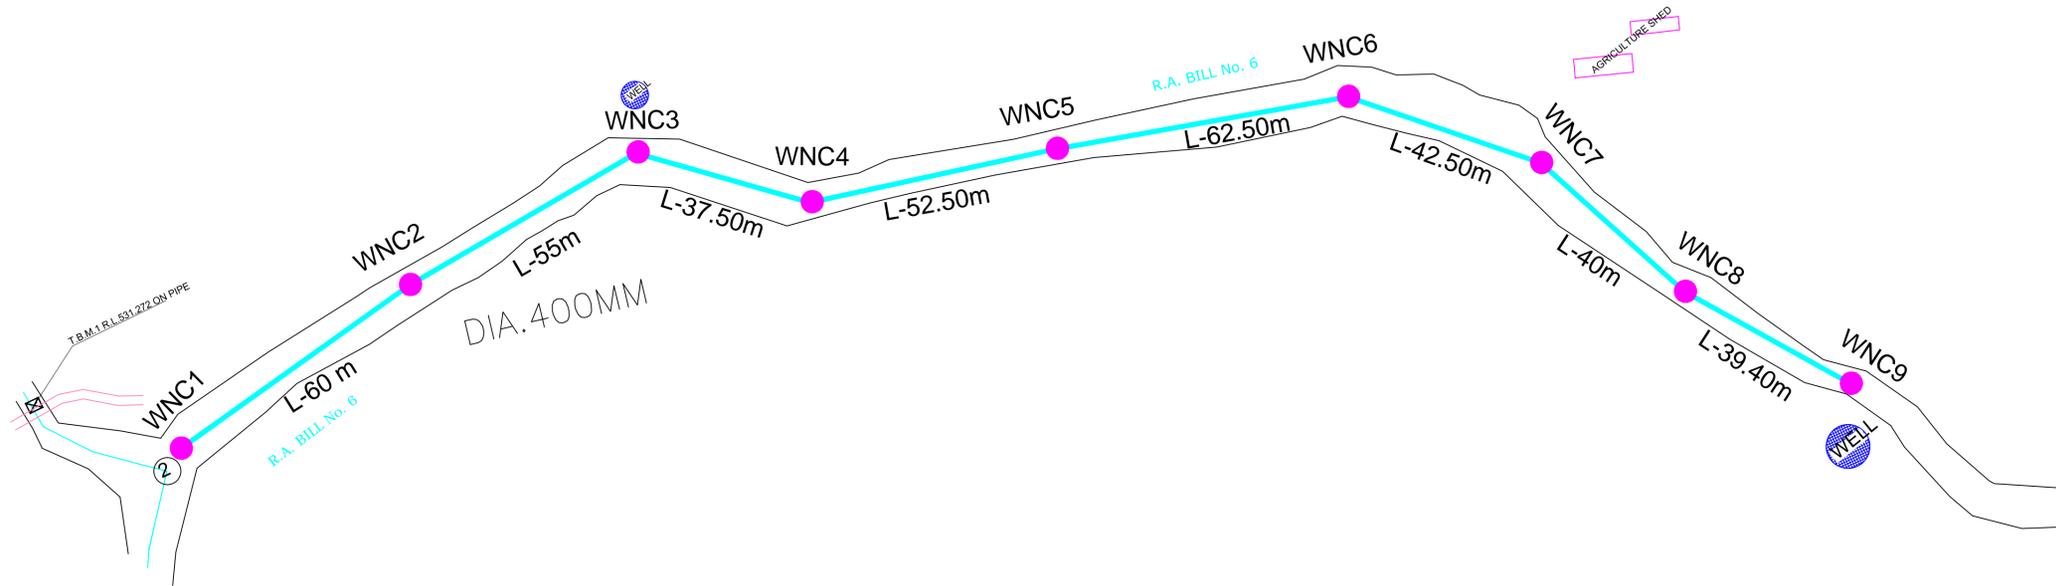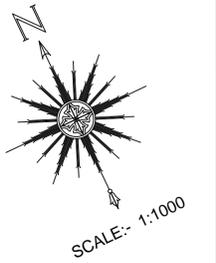

LEGENDS	
	RA BILL -6

MAIN SEWER WARD-98 (AT WALMI NEAR CSMS) DIA 400MM				
CHAINAGE	MH	CLEAR LENGTH(M)	GL	IL
15.00	WNC1	0.00	530.242	527.832
76.20	WNC2	60.00	530.642	528.112
132.40	WNC3	55.00	530.519	528.390
171.10	WNC4	37.50	530.890	528.510
224.80	WNC5	52.50	531.147	528.940
288.50	WNC6	62.50	531.827	529.676
332.20	WNC7	42.50	532.527	529.900
373.40	WNC8	40.00	532.610	529.970
414.00	WNC9	39.40	532.800	530.100

PROJECT:DEVELOPMENT OF SEWERAGE COLLECTION
NETWORK UNDER UIDSSMT FOR AURANGABAD CITY

TITLE: AS BUILT OF MAIN SEWER "WARD NO.98"
(AT WALMI NEAR CSMS) SIXTH R.A BILL



AURANGABAD MUNICIPAL CORPORATION,
TOWN HALL, AURANGABAD



AGENCY:KHLARI INFRASTRUCTURE PVT. LTD.
101, PRABHAT CENTER, SECT-1A, CBD, BELAPUR,
NAVI MUMBAI-400 614

CONSULTANT: FORTRESS INFRASTRUCTURE
ADVISORY SERVICES, MARINE LINES, MUMBAI-2